



3+13

500

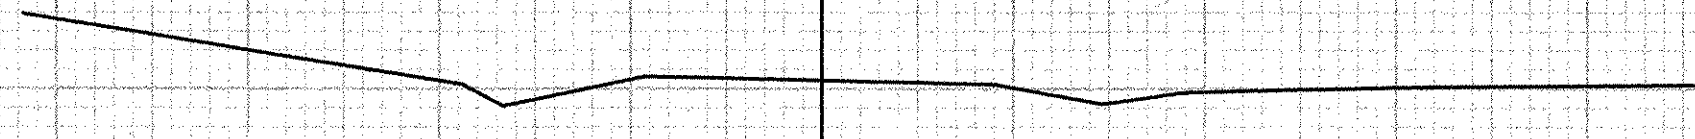

2+85

500

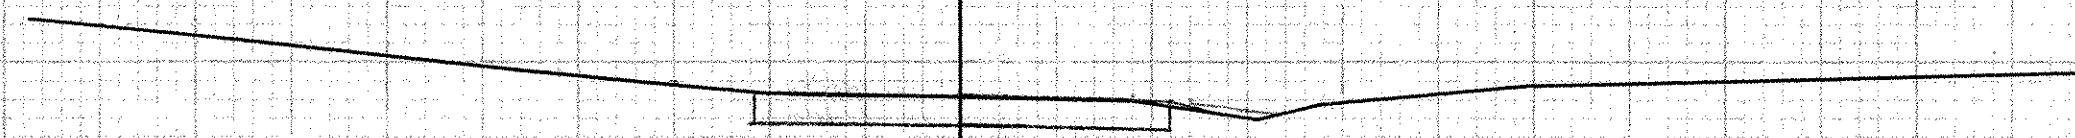

2+53

490

TH 66 2+50 Lt.
Existing 12" CGMP
Retain

END TH 66 2+50
APPROACH CONSTRUCTION

FROM STA.	2+53	TO STA.	3+13
PROJECT NAME	MORETOWN		
NO. OF SHEETS	RS0167(9)		
SURVEYED BY	PLOTTED 10/14/87		
SHEET	136	OF	243 SHEETS

SCALE 1" = 10 FEET