


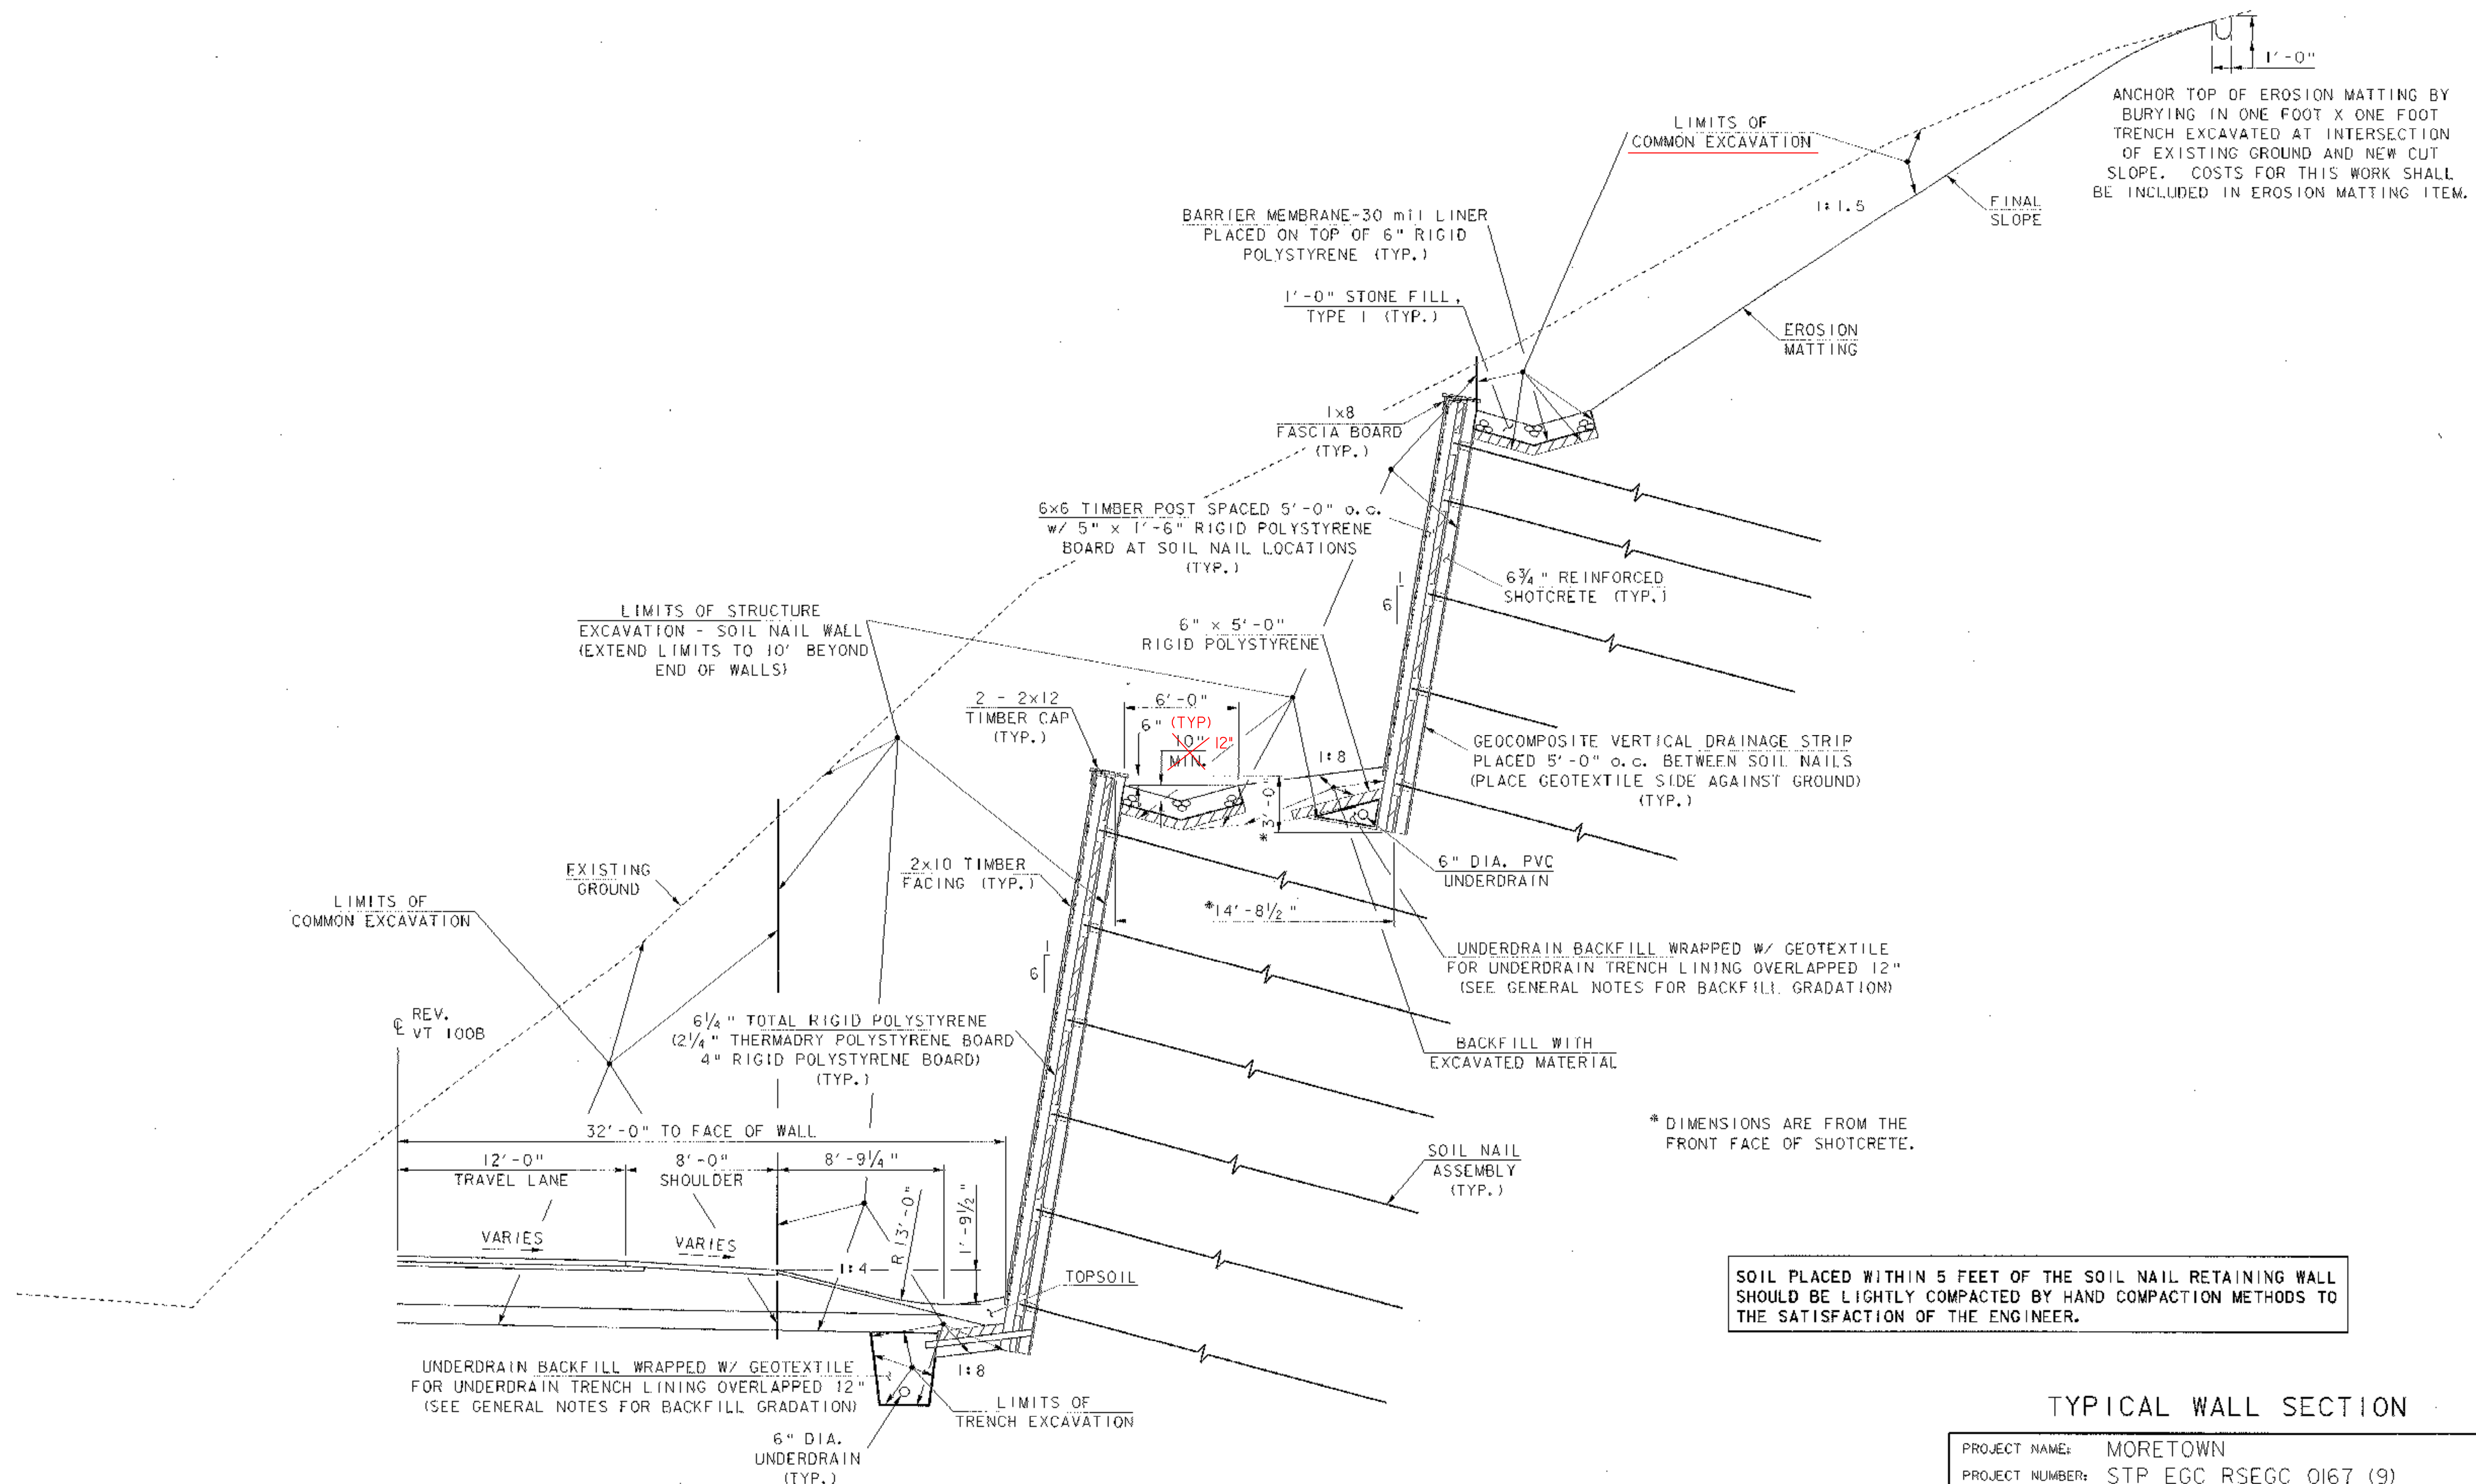

**TYPICAL WALL SECTION**  
SCALE: 1/4" = 1'-0"

**TYPICAL WALL SECTION**

|                    |                                |
|--------------------|--------------------------------|
| PROJECT NAME:      | MORETOWN                       |
| PROJECT NUMBER:    | STP EGC RSEGC 0167 (9)         |
| FILE NAME:         | \\78el32\Structures\sel32typ.I |
| PROJECT LEADER:    | R.R. WHITCOMB                  |
| DESIGNED BY:       | C. ALLEN                       |
| BRIDGE SHEET BR302 |                                |
| DATE:              | 12-MAY-2000                    |
| DRAWN BY:          | G. ROY                         |
| CHECKED BY:        | C. ALLEN                       |
| SHEET              | 139 OF 243                     |