



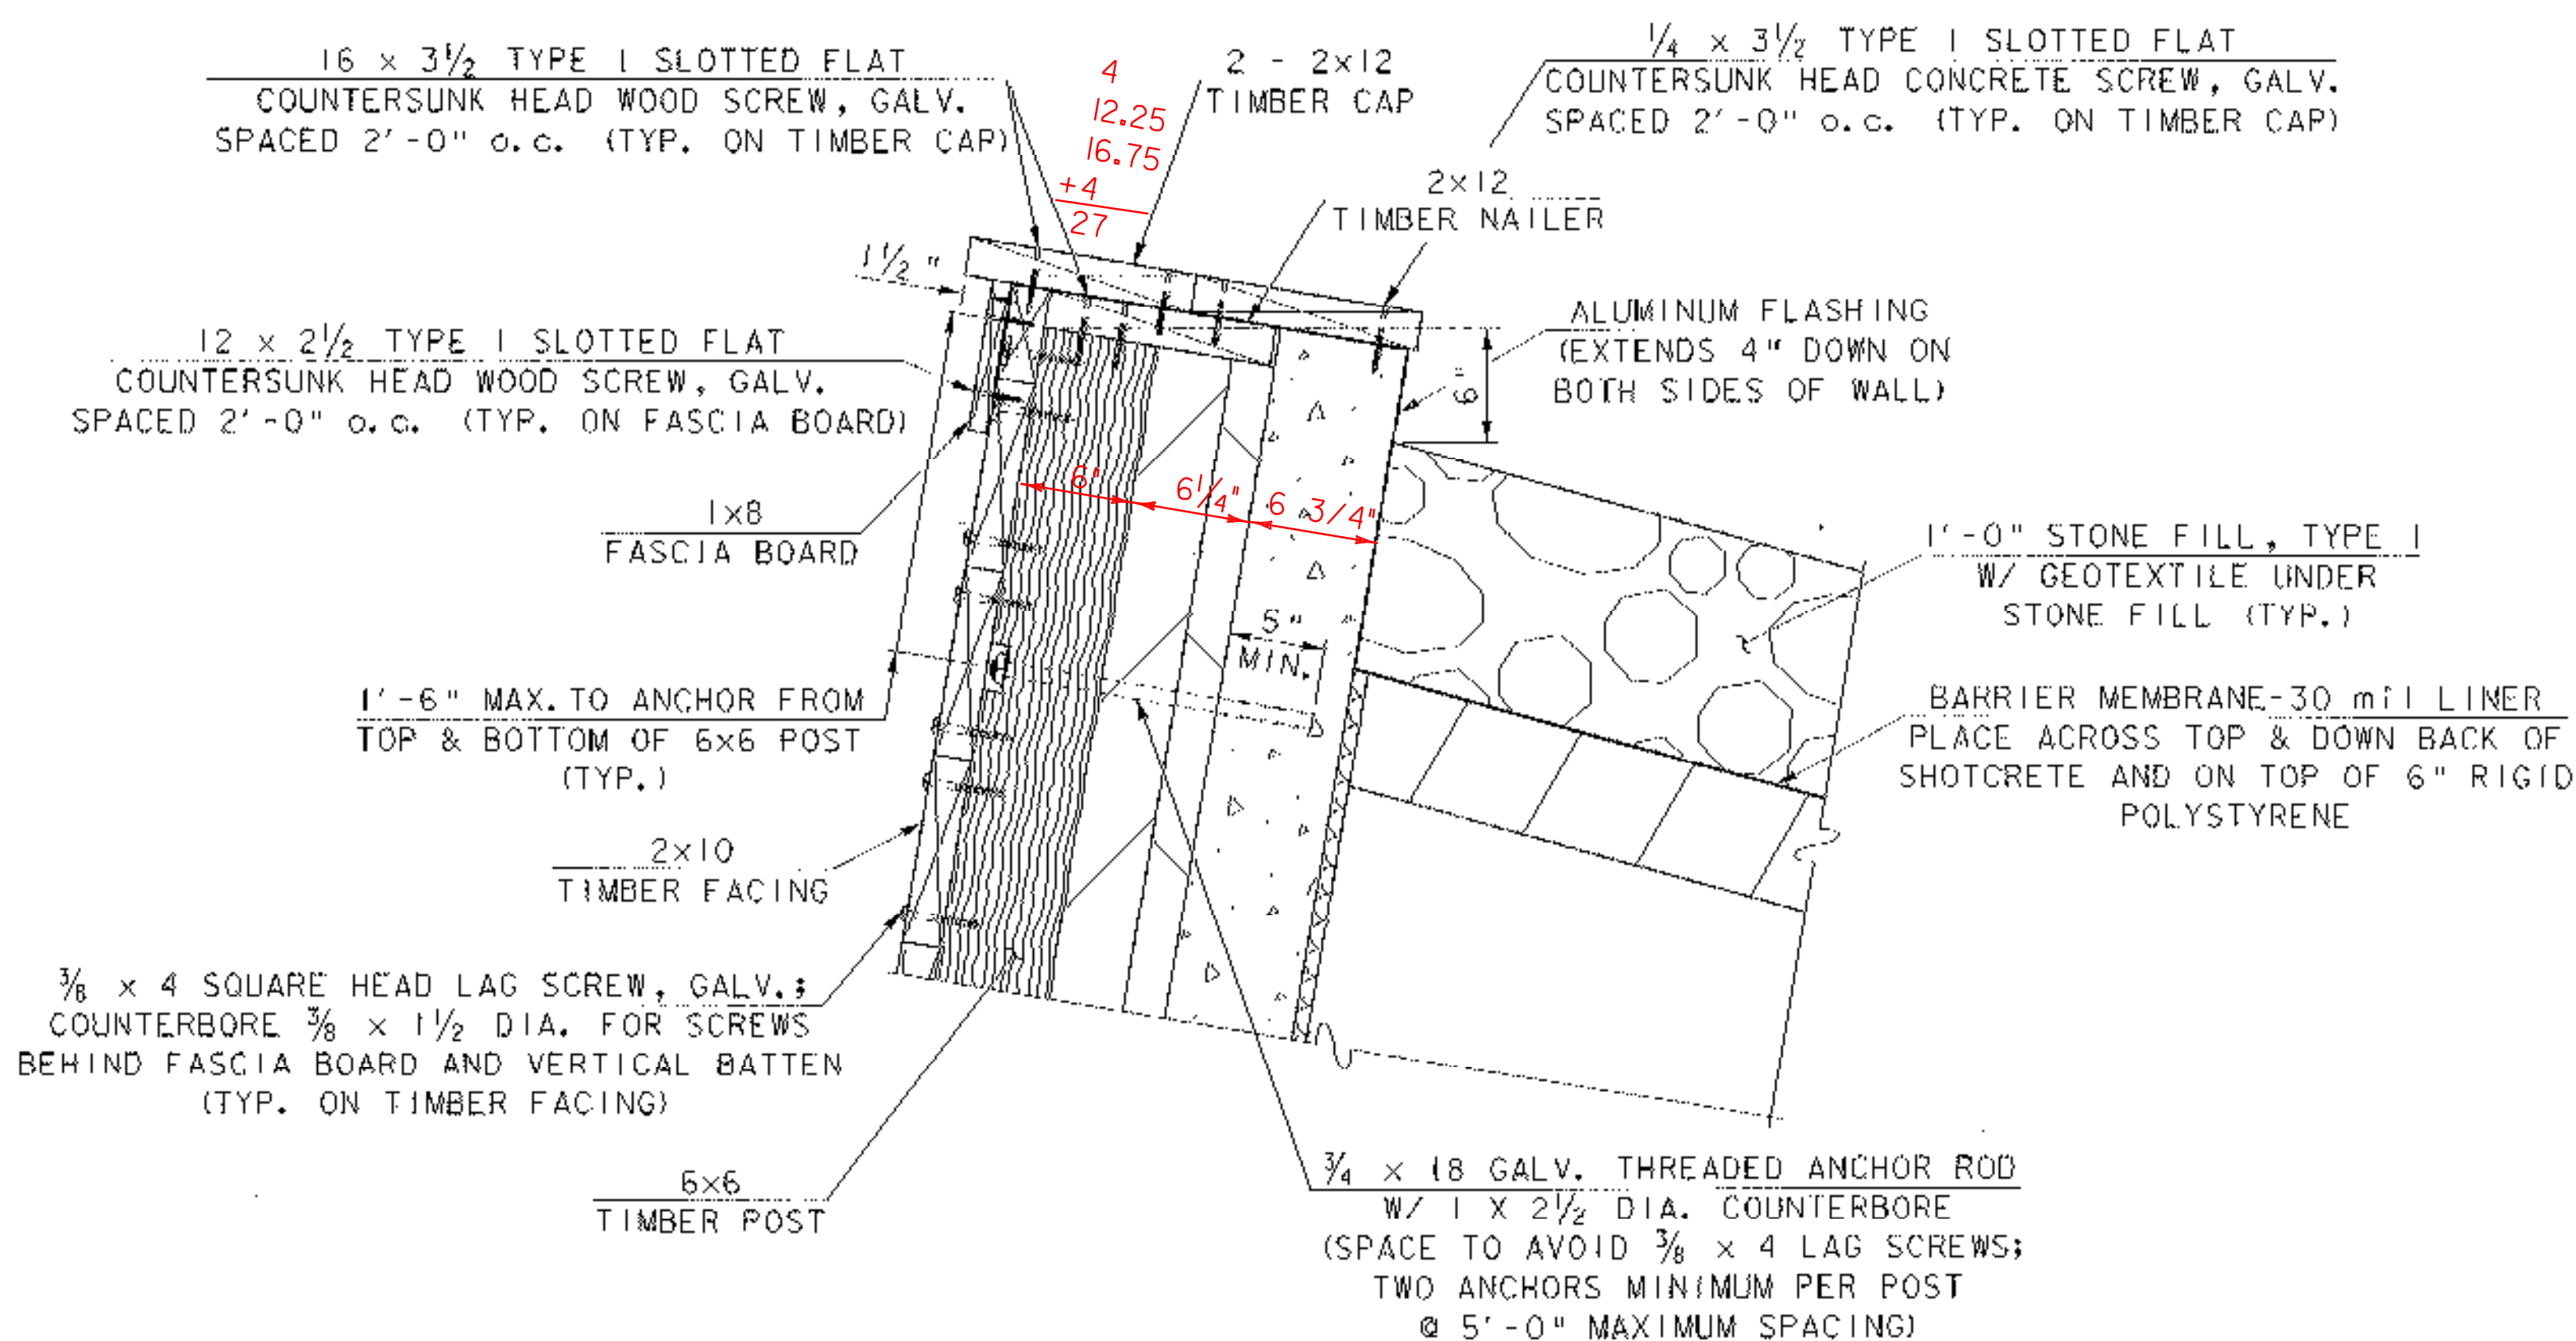


**TIMBER CAP AND
POST ANCHOR DETAIL**

SCALE: 1 1/2" = 1'-0"

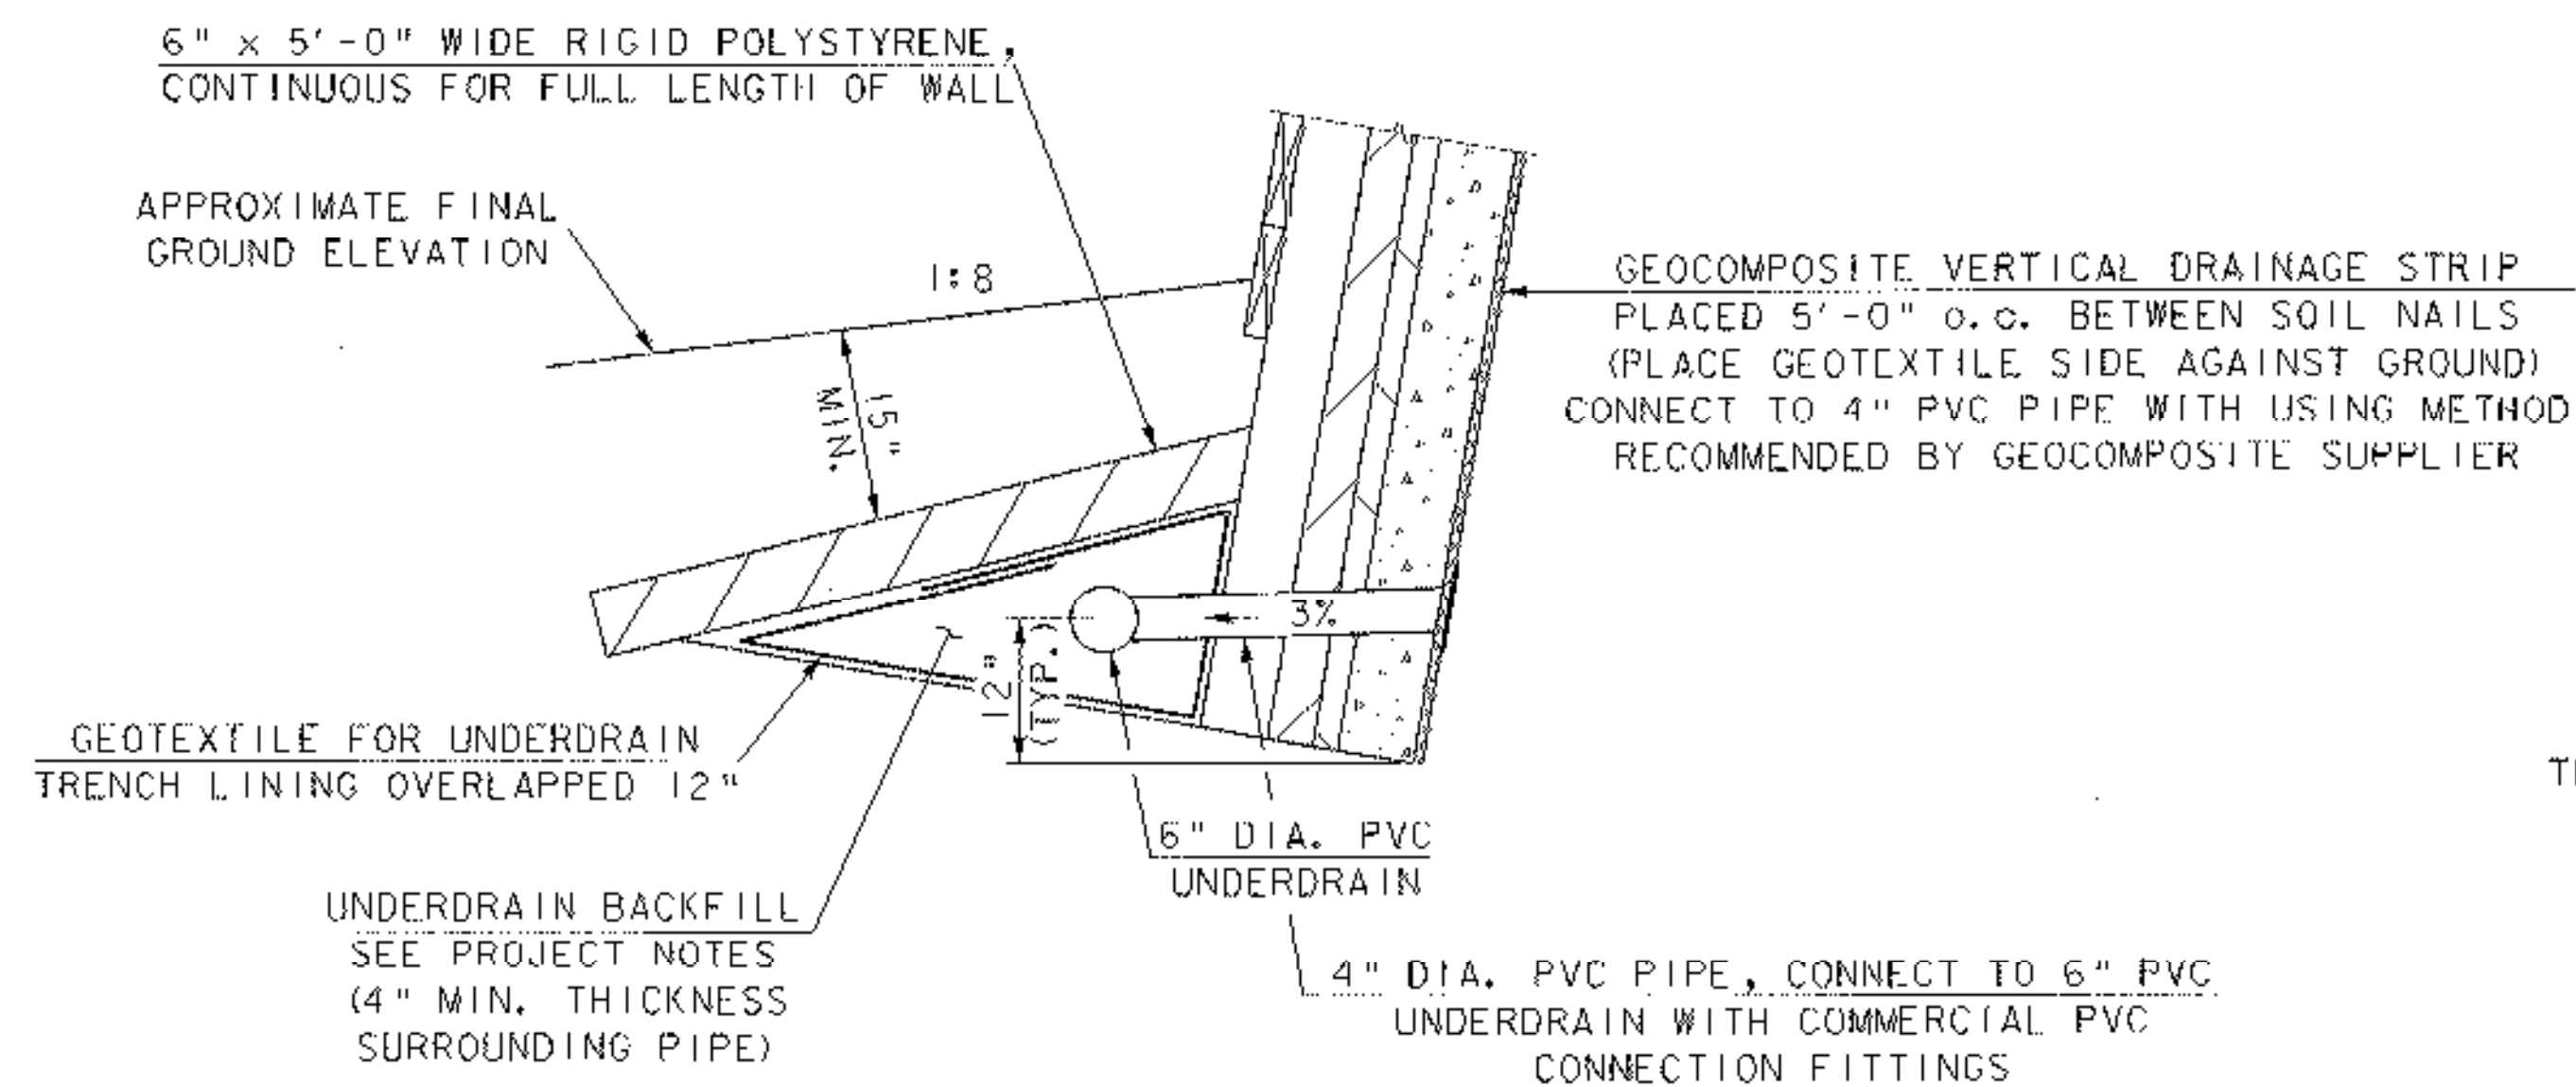


UPPER WALL DRAINAGE DETAIL

SCALE: 3/4" = 1'-0"

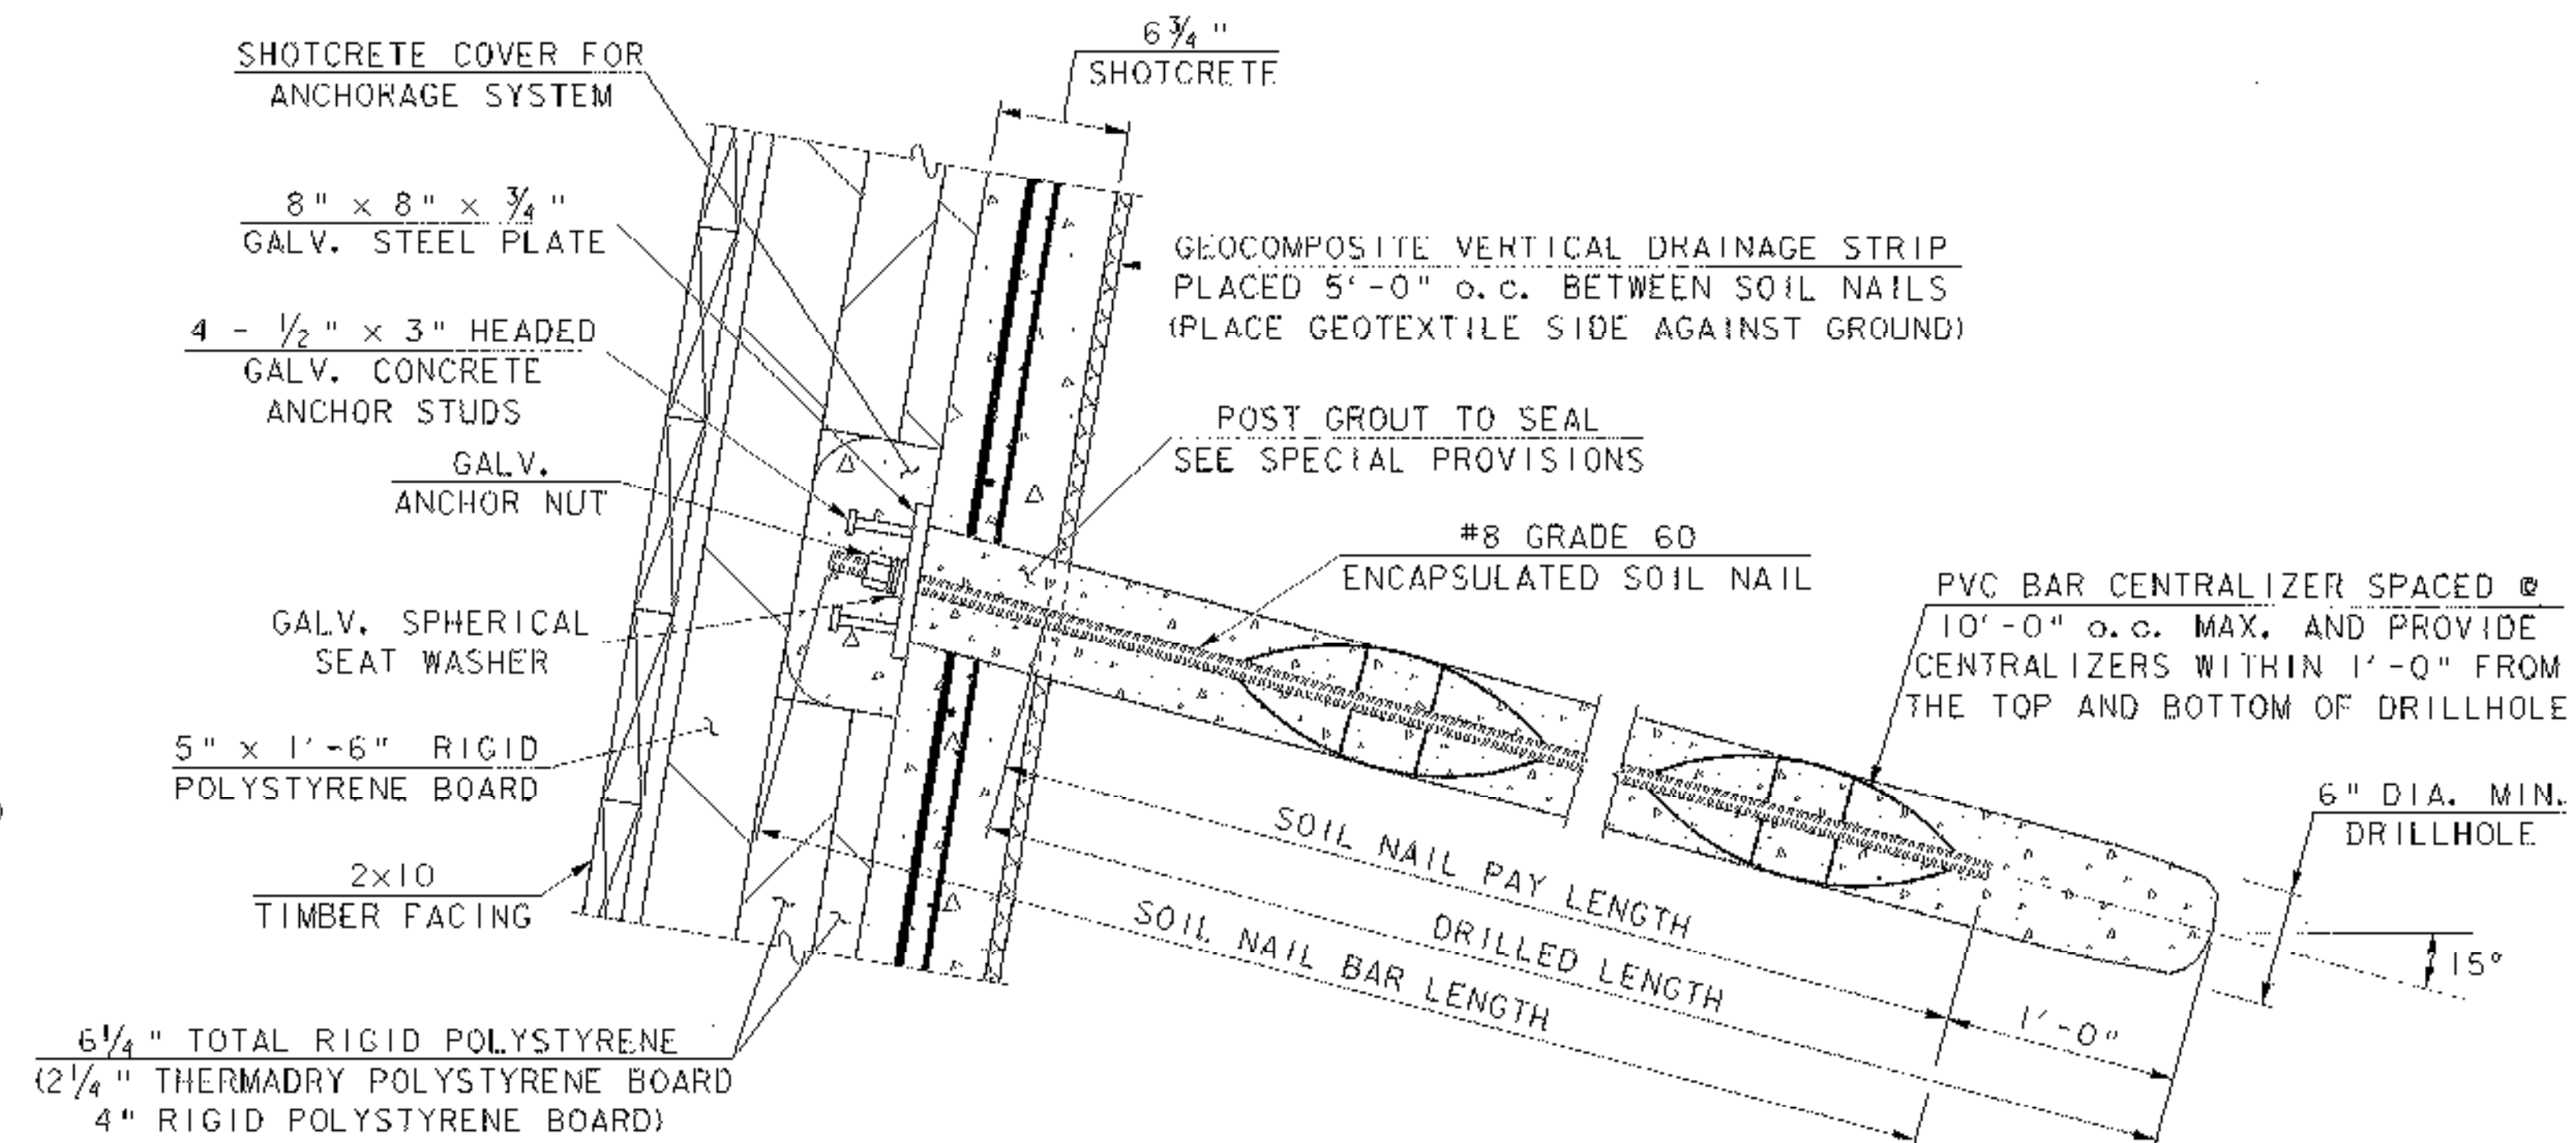

SOIL NAIL DETAIL

SCALE: 1 1/2" = 1'-0"

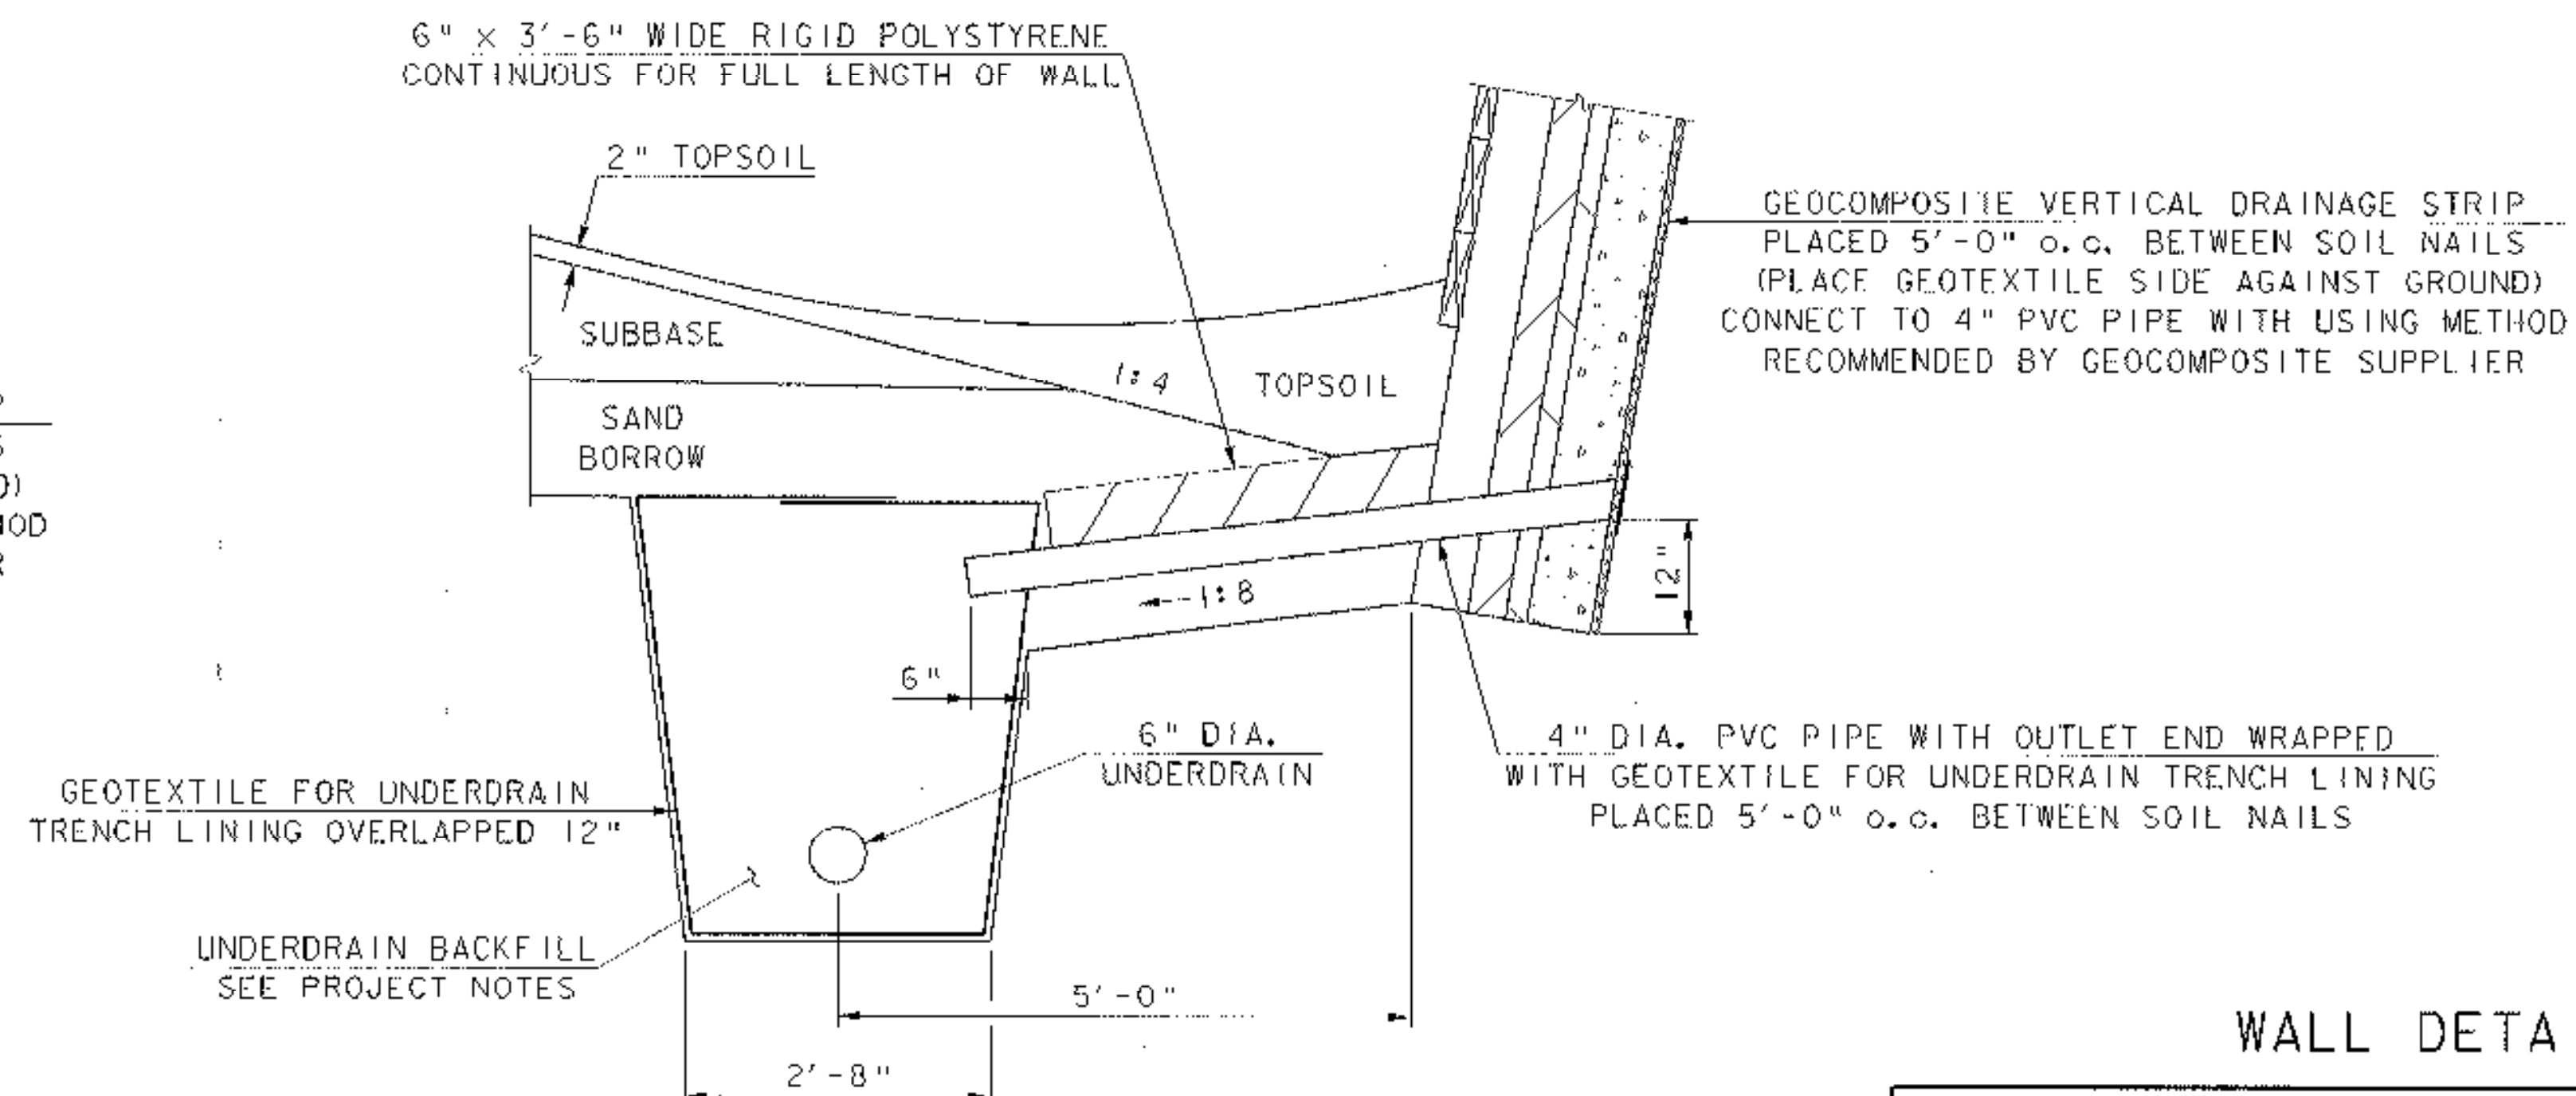

LOWER WALL DRAINAGE DETAIL

SCALE: 3/4" = 1'-0"

WALL DETAILS

PROJECT NAME:	MORETOWN
PROJECT NUMBER:	STP EGC RSEGC 0167 (9)
FILE NAME:	\\78el32\Structures\sel32det.d
PROJECT LEADER:	R. R. WHITCOMB
DESIGNED BY:	C. ALLEN
BRIDGE SHEET BR314	
PLOT DATE:	12-MAY-2000
DRAWN BY:	G. ROY
CHECKED BY:	C. ALLEN
SHEET	144B OF 243