


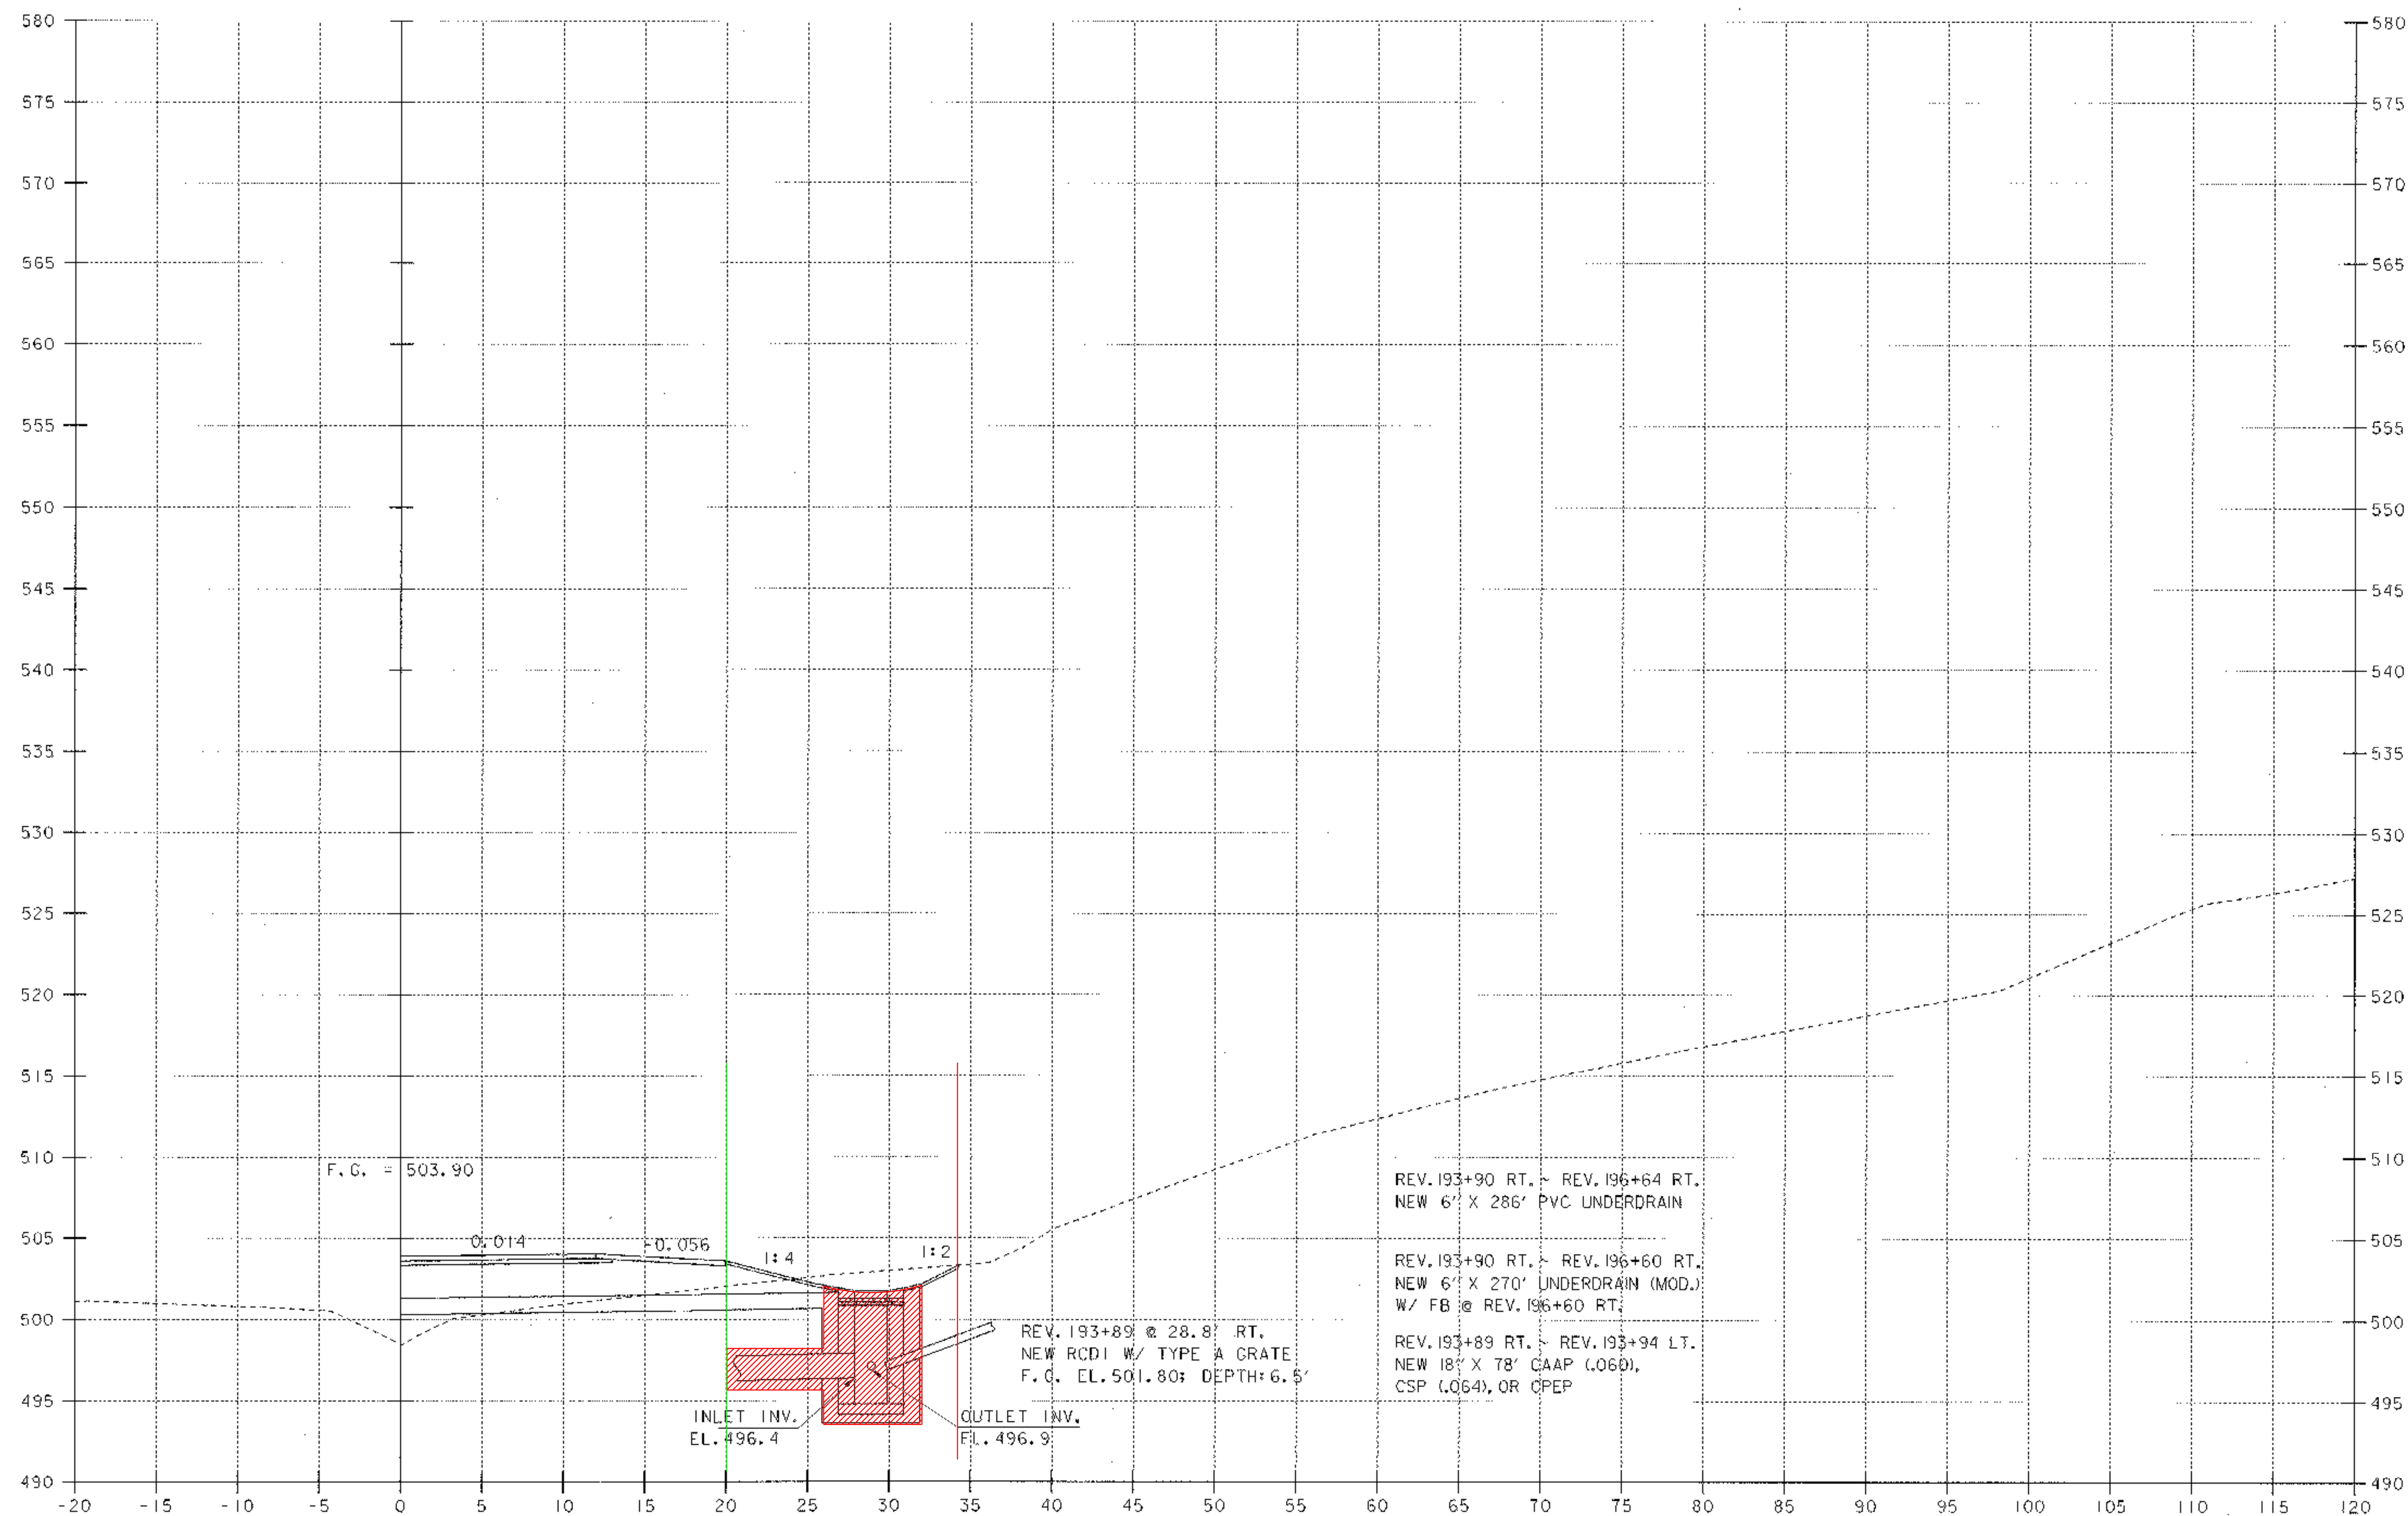

REV. 193+89

SCALE 1" = 5'-0"
5 0 5

PROJECT NAME: MORETOWN
PROJECT NUMBER: STP EGC RSEGC 0167 (9)

FILE NAME: \\78el32\Structures\sel32+02.1 PLOT DATE: 12-MAY-2000
PROJECT LEADER: R. R. WHITCOMB DRAWN BY: G. ROY
DESIGNED BY: C. ALLEN CHECKED BY: C. ALLEN
BRIDGE SHEET BR317 SHEET 145B OF 243