


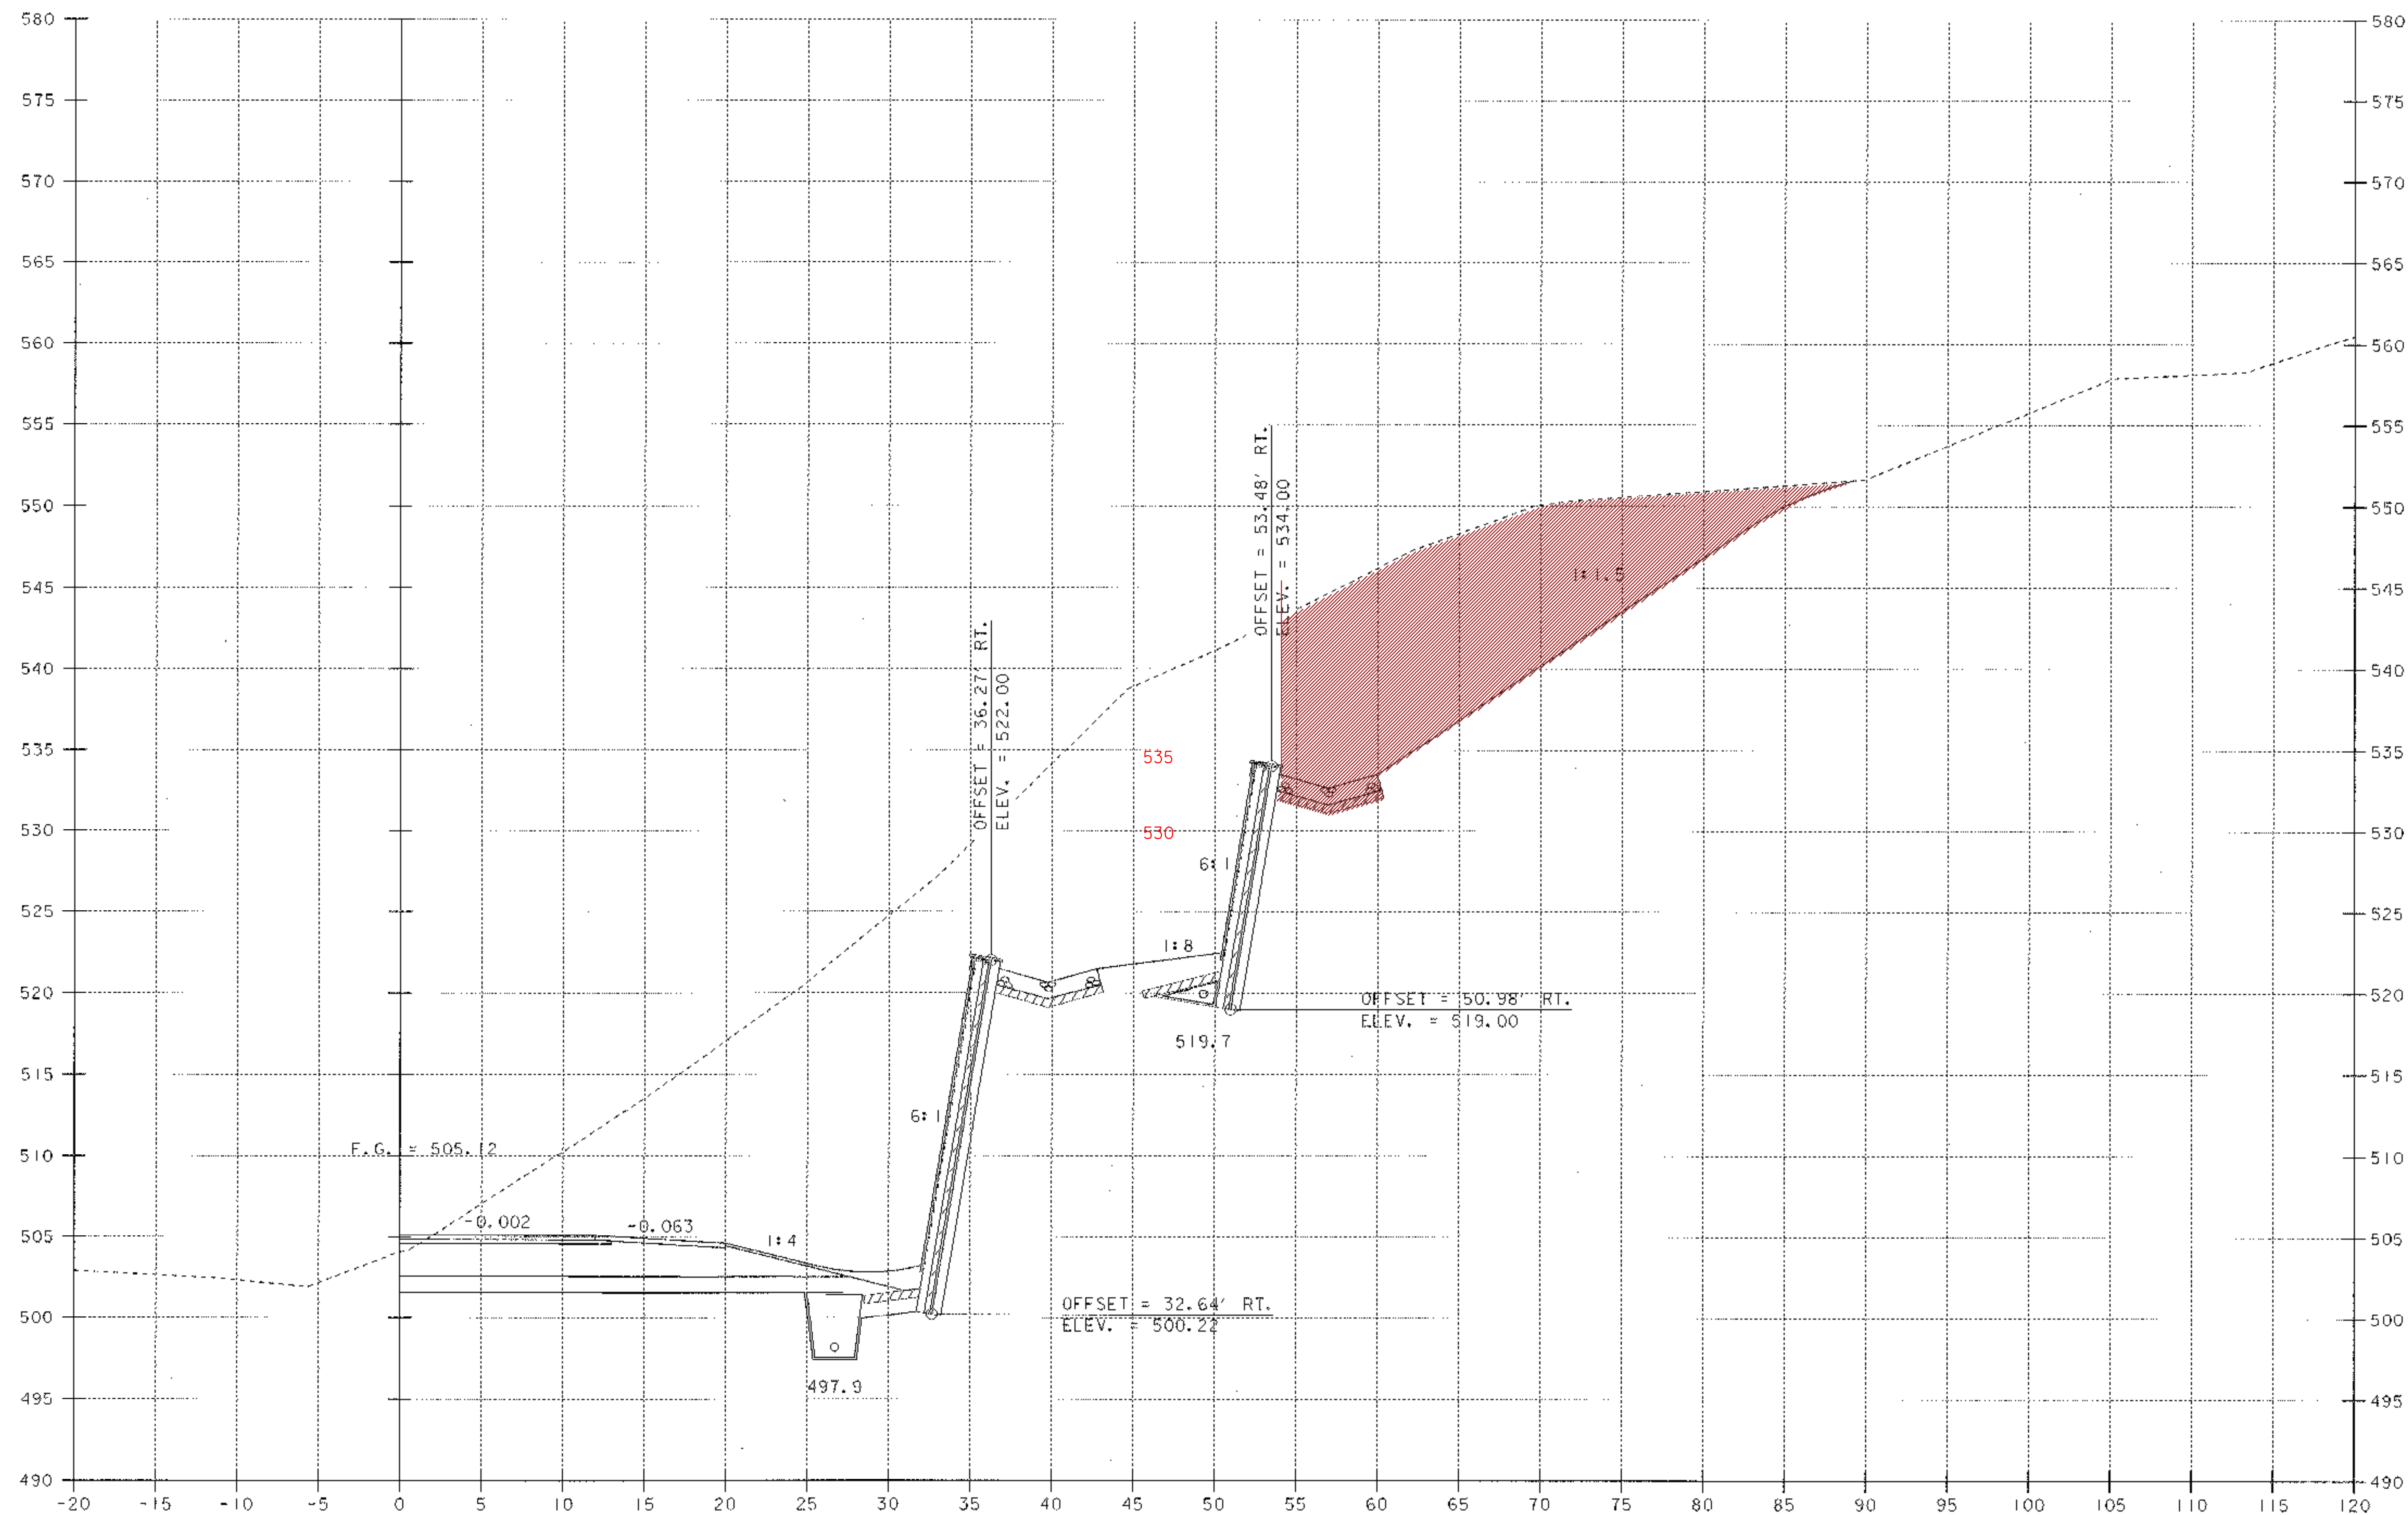

REV. 194+50

SCALE 1" = 5'-0"
5 0 5

PROJECT NAME: MORETOWN
PROJECT NUMBER: STP EGC RSECC 0167 (9)

FILE NAME: \\78el32\Structures\sej32t05.1 PLOT DATE: 12-MAY-2000
PROJECT LEADER: R. R. WHITCOMB DRAWN BY: G. ROY
DESIGNED BY: C. ALLEN CHECKED BY: C. ALLEN
BRIDGE SHEET BR320 SHEET 145E OF 243