


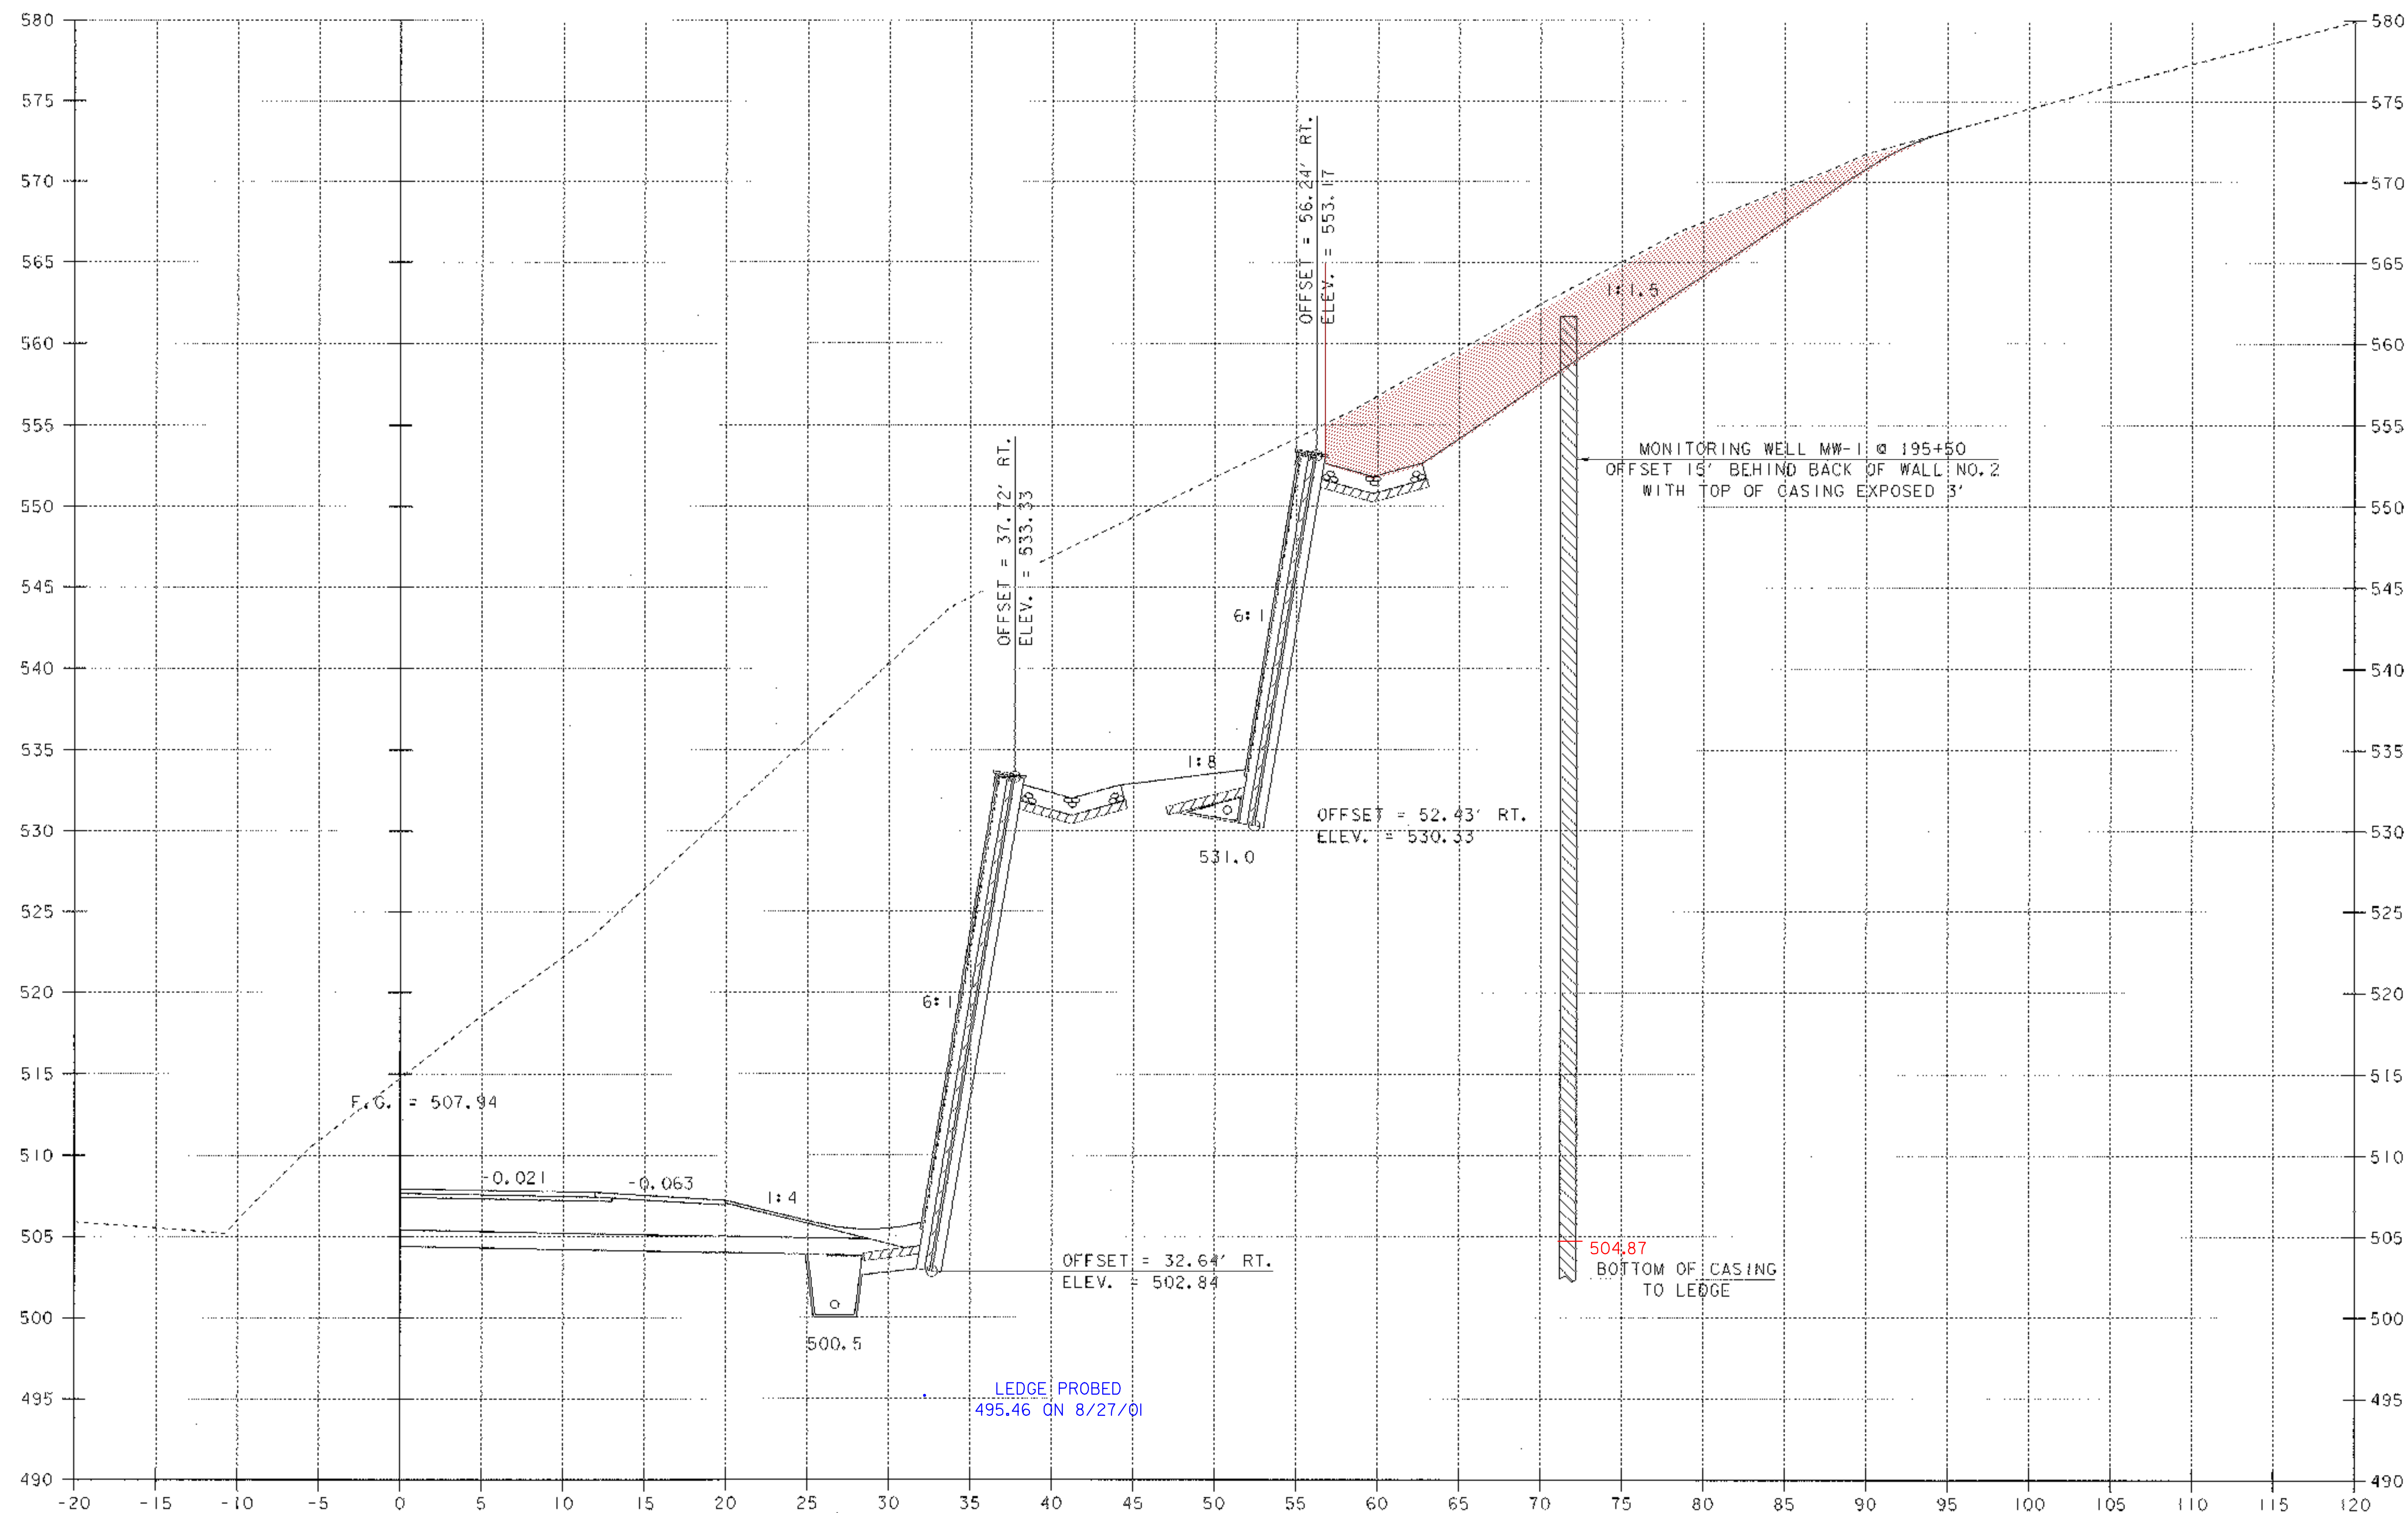

REV. 195+50

SCALE 1" = 5'-0"

PROJECT NAME: MORETOWN
PROJECT NUMBER: STP EGC RSEGC 0167 (9)

FILE NAME: \78el32\Structures\sel32t09.1 PLOT DATE: 12-MAY-2000
PROJECT LEADER: R. R. WHITCOMB DRAWN BY: G. ROY
DESIGNED BY: C. ALLEN CHECKED BY: C. ALLEN
BRIDGE SHEET BR324 SHEET 1451 OF 243