


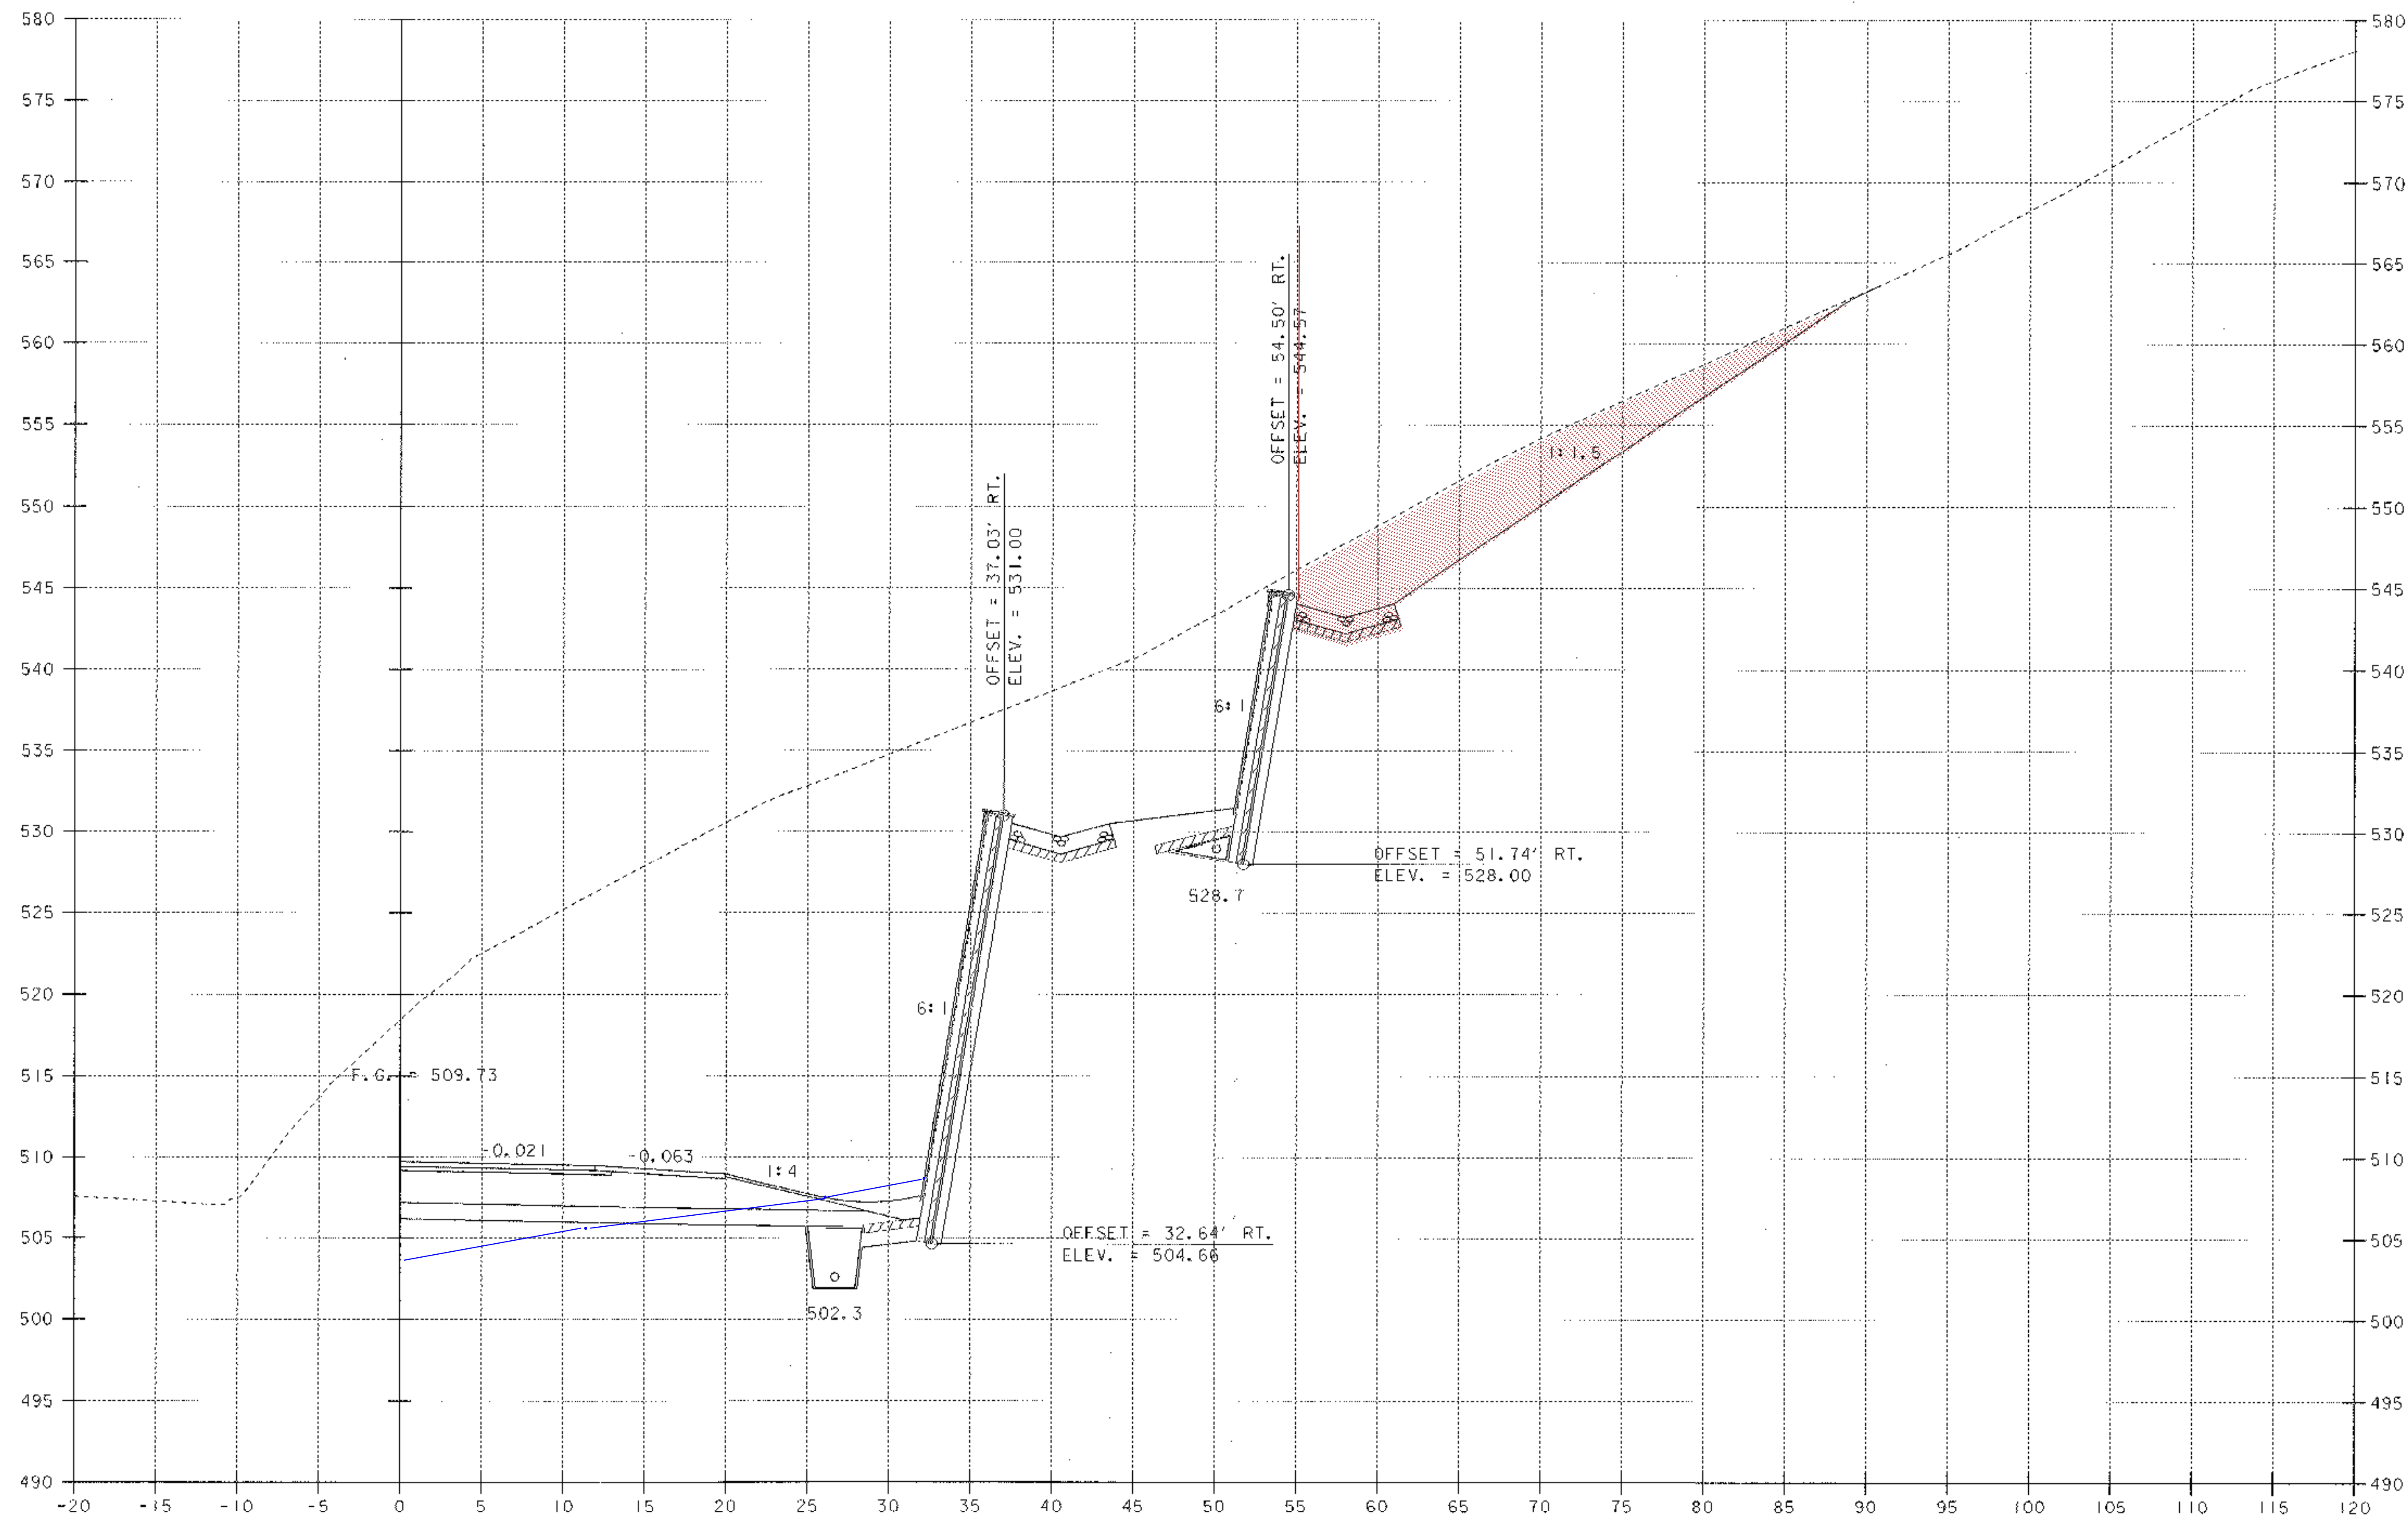

REV. 196+00

SCALE 1" = 5'-0"

PROJECT NAME: MORETOWN
PROJECT NUMBER: STP EGC RSECC 0167 (9)

FILE NAME: \78e132\Structures\se132t111 PLOT DATE: 12-MAY-2000
PROJECT LEADER: R. R. WHITCOMB DRAWN BY: G. ROY
DESIGNED BY: C. ALLEN CHECKED BY: C. ALLEN
BRIDGE SHEET BR326 SHEET 145K OF 243