


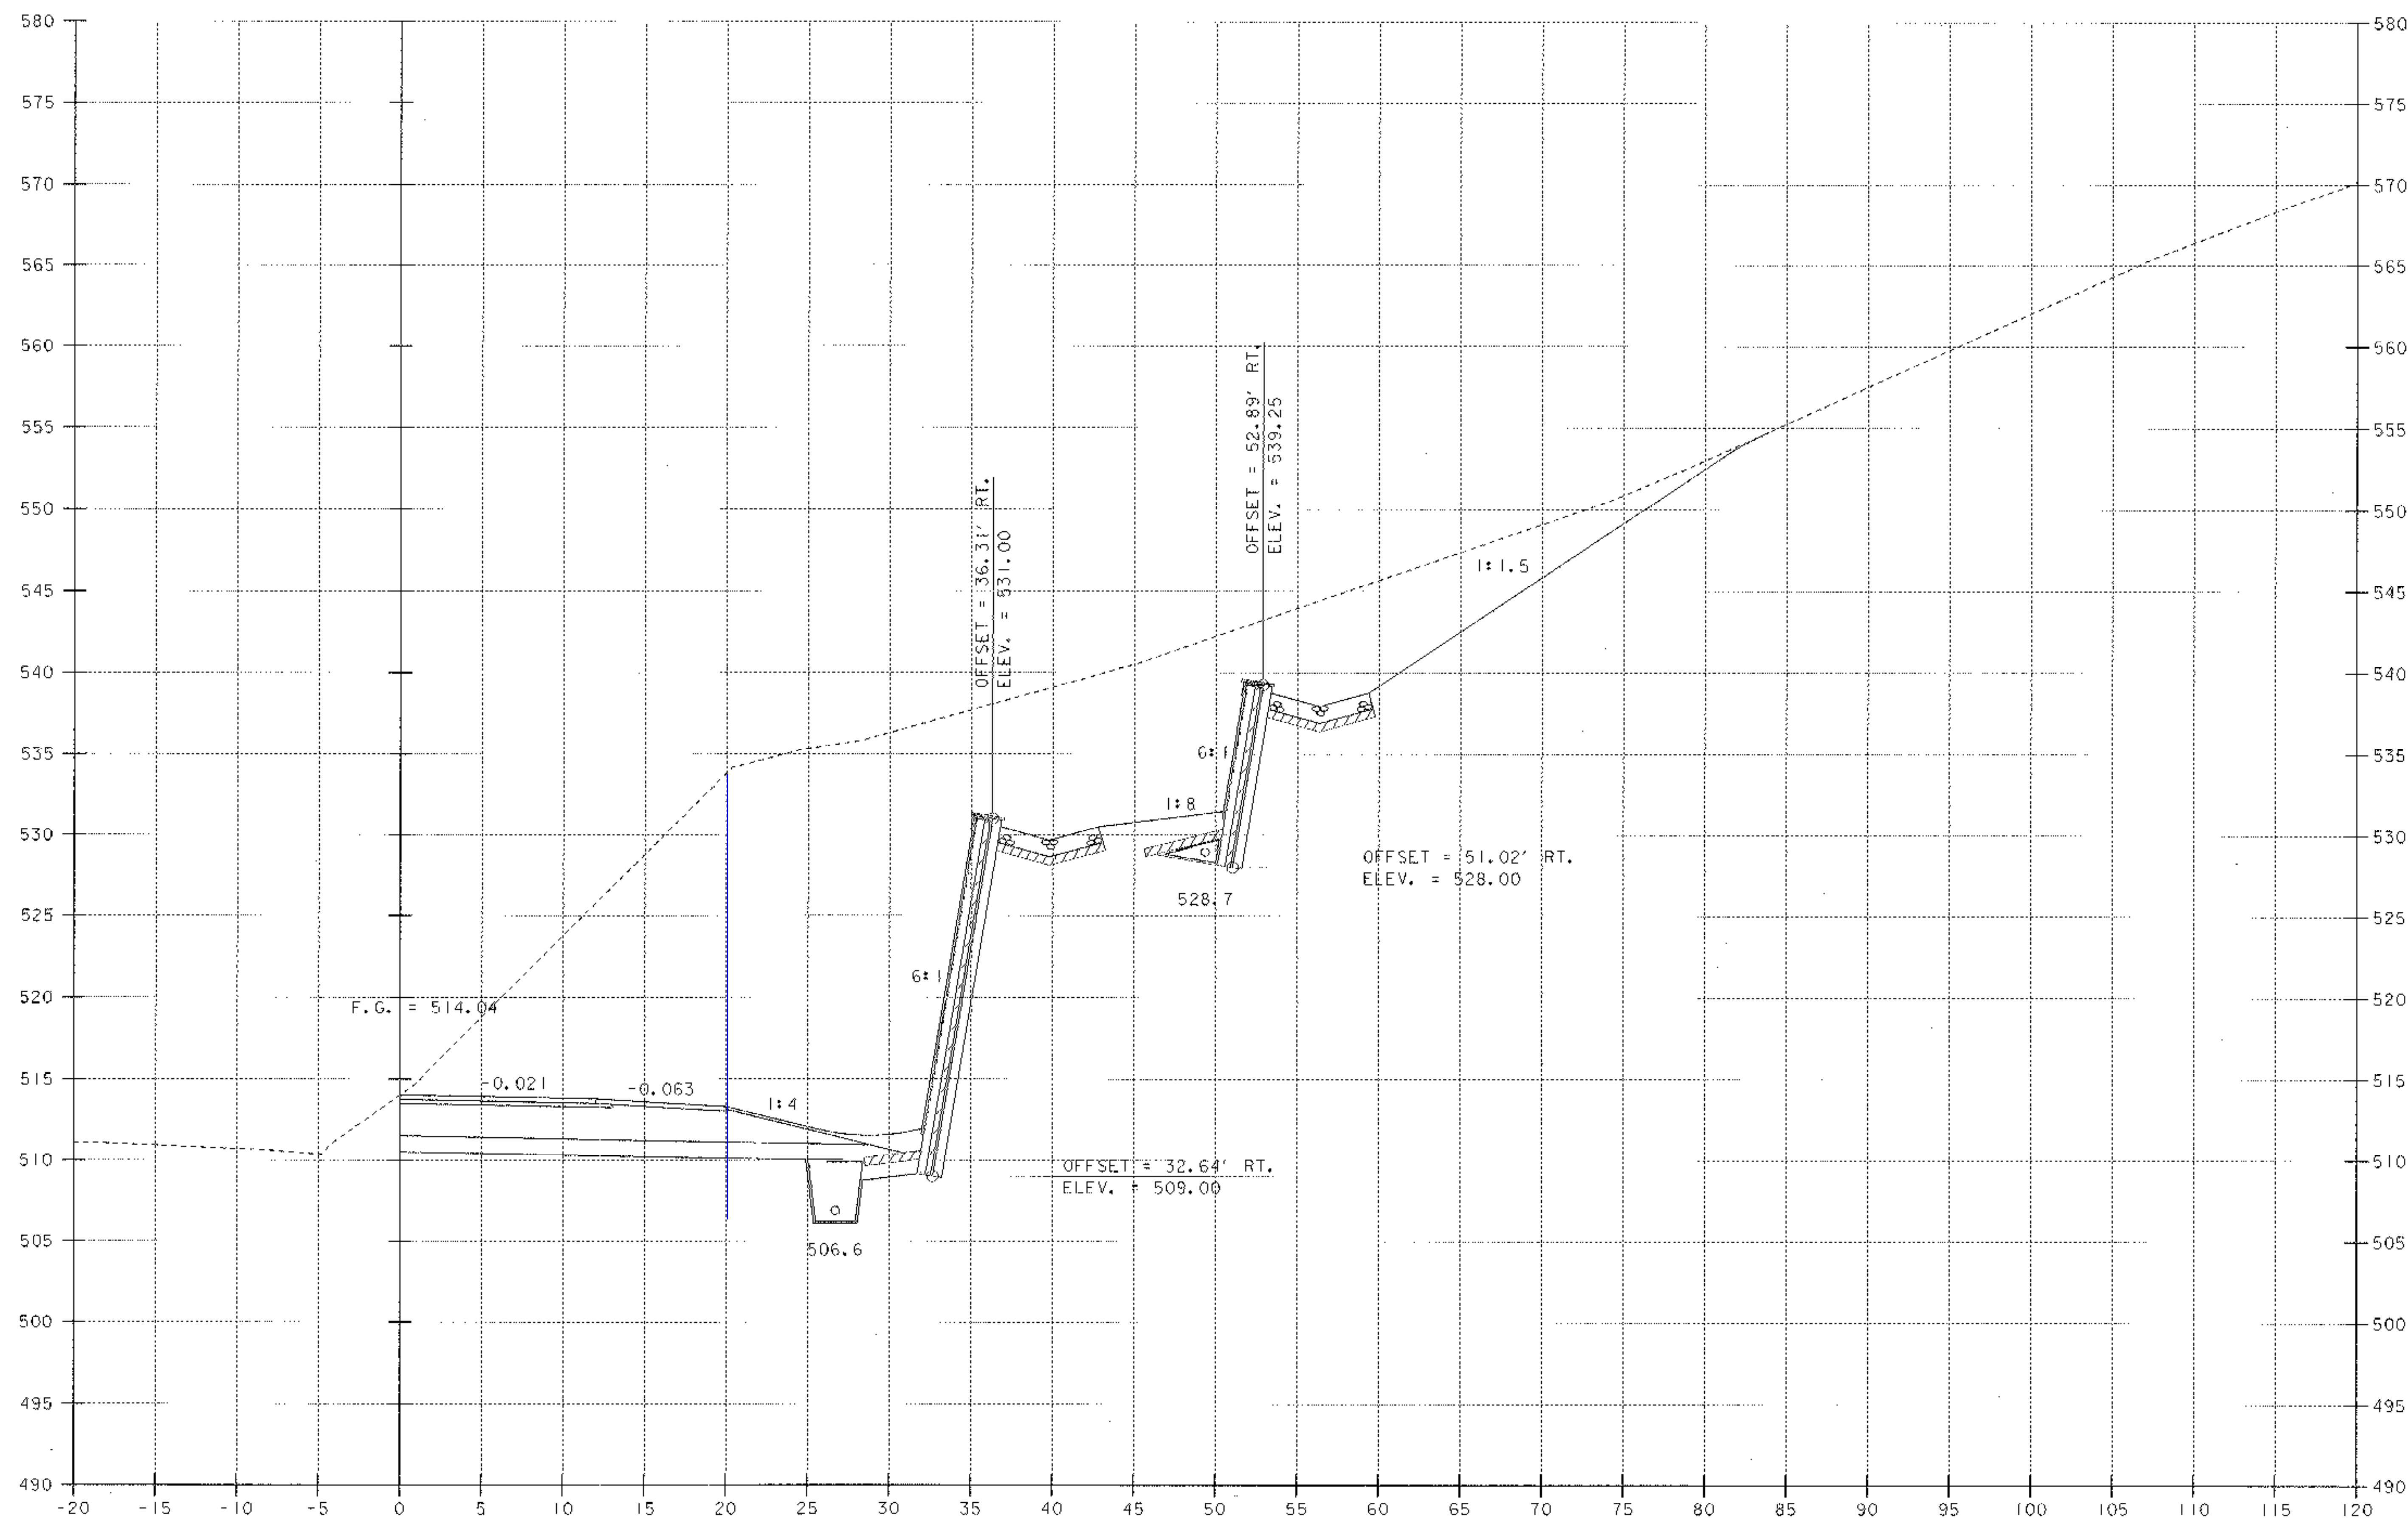

REV. 197+00

REV. 196+90 RT.
BEGIN RETAINING WALL NO. 1

SCALE 1" = 5'-0"
5 0 5

PROJECT NAME: MORETOWN
PROJECT NUMBER: STP EGC RSECC 0167 (9)

FILE NAME: \78e132\Structures\se132t16.i PLOT DATE: 12-MAY-2000
PROJECT LEADER: R. R. WHITCOMB DRAWN BY: G. ROY
DESIGNED BY: C. ALLEN CHECKED BY: C. ALLEN
BRIDGE SHEET BR331 SHEET 145P OF 243