


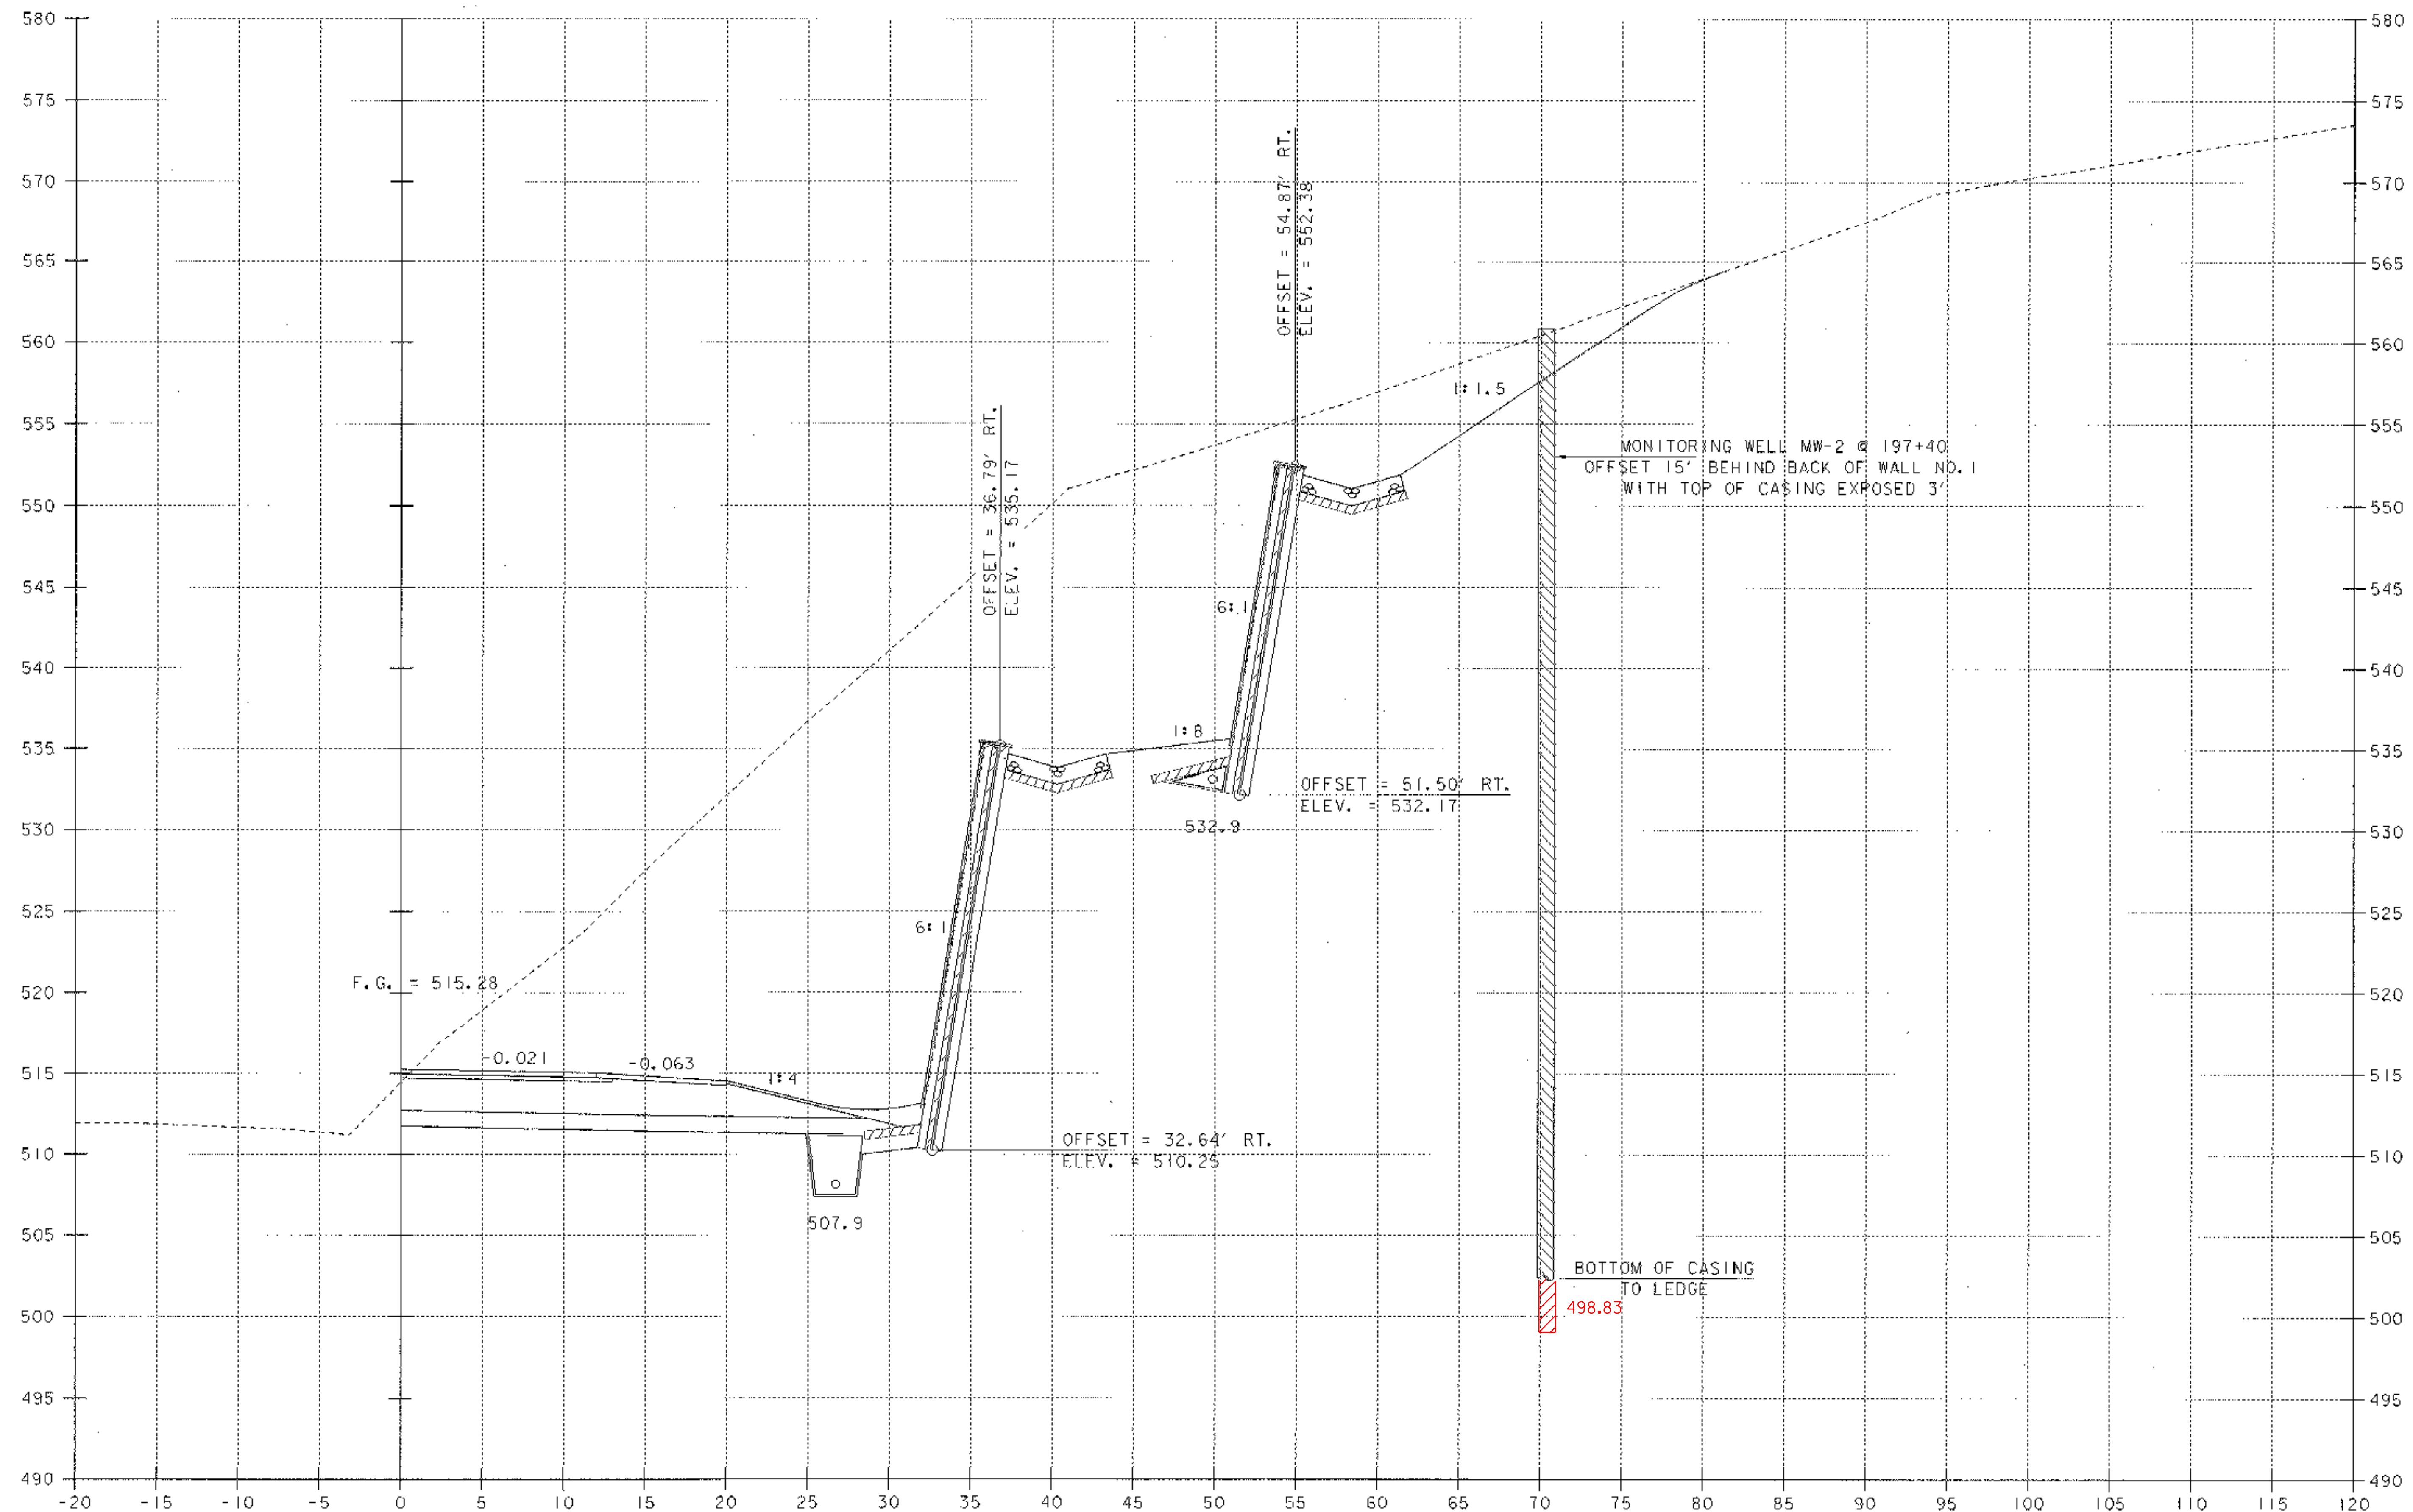

REV. 197+25

SCALE 1" = 5'-0"

PROJECT NAME:	MORETOWN
PROJECT NUMBER:	STP EGC RSEGC 0167 (9)
FILE NAME:	\\78e132\Structures\sel32\17.1
PROJECT LEADER:	R. R. WHITCOMB
DESIGNED BY:	C. ALLEN
BRIDGE SHEET BR332	
PLOT DATE:	12-MAY-2000
DRAWN BY:	G. ROY
CHECKED BY:	C. ALLEN
SHEET	145Q OF 243