


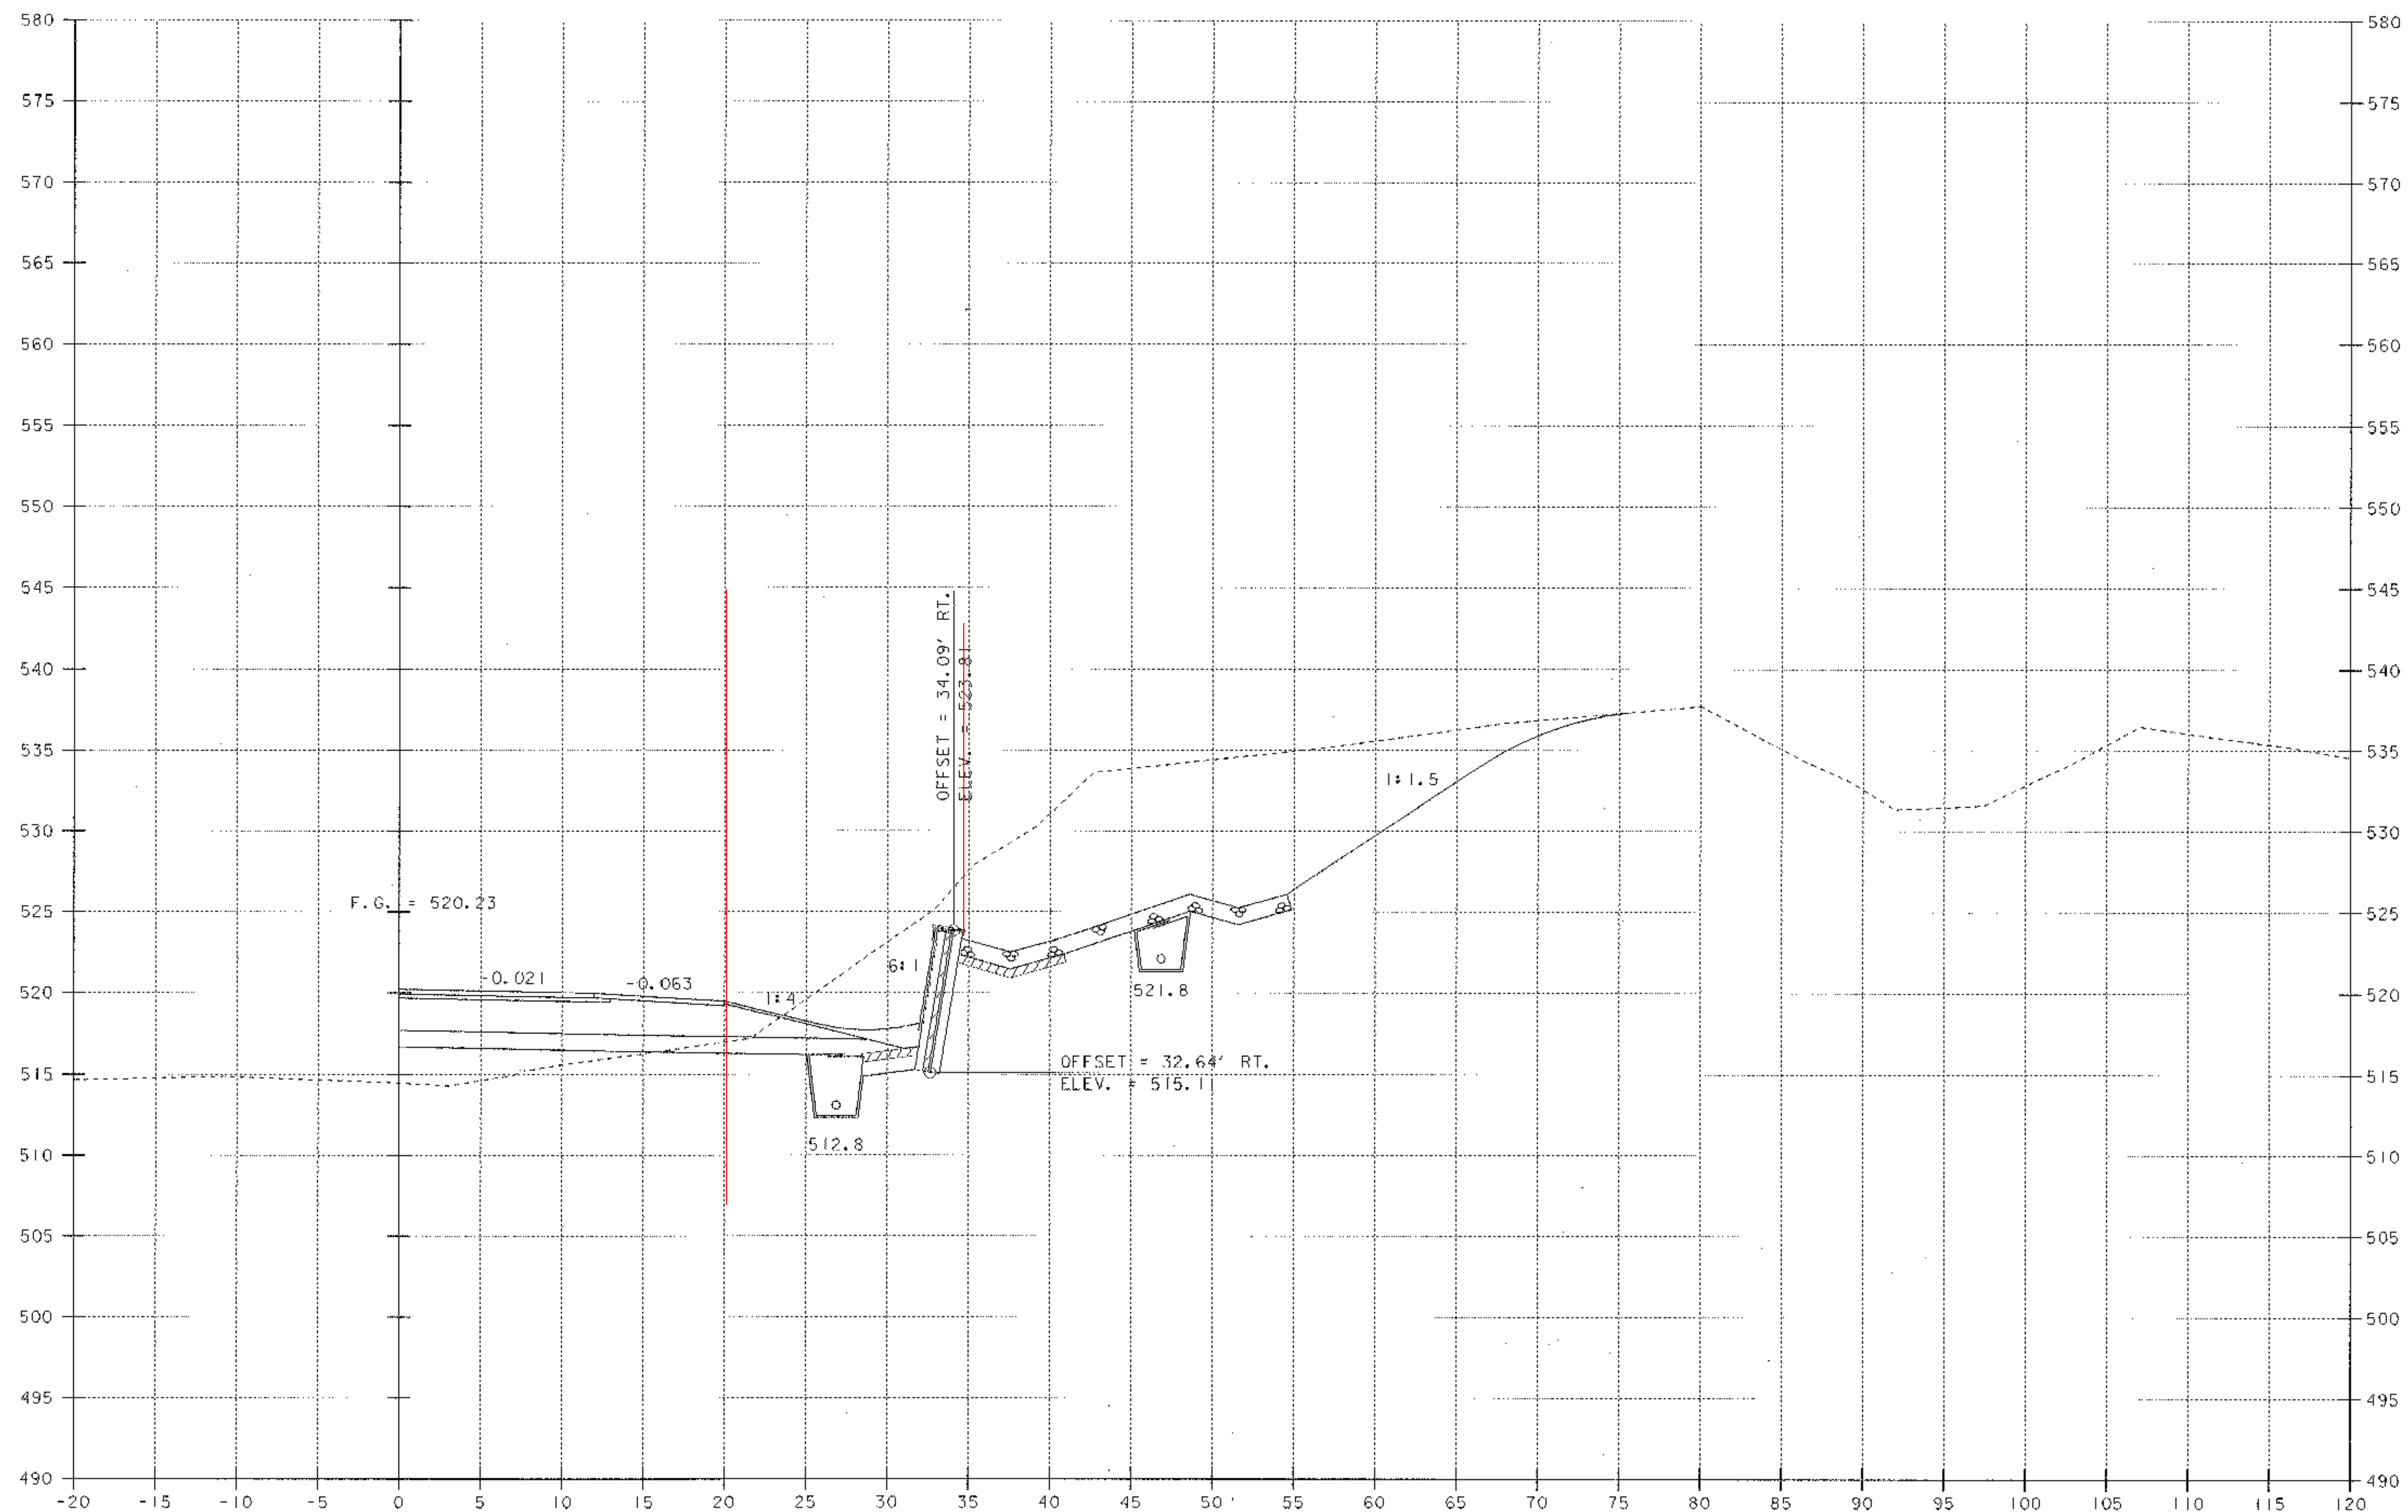

REV. 198+25

SCALE 1" = 5'-0"
5 0 5

REV. 198+20 RT.
END RETAINING WALL NO. 1

PROJECT NAME:	MORETOWN
PROJECT NUMBER:	STP EGC RSEGC 0167 (9)
FILE NAME:	\\78e132\Structures\se132t2L1
PROJECT LEADER:	R. R. WHITCOMB
DESIGNED BY:	C. ALLEN
BRIDGE SHEET	BR336
PLOT DATE:	12-MAY-2000
DRAWN BY:	G. ROY
CHECKED BY:	C. ALLEN
SHEET	1450 OF 243