


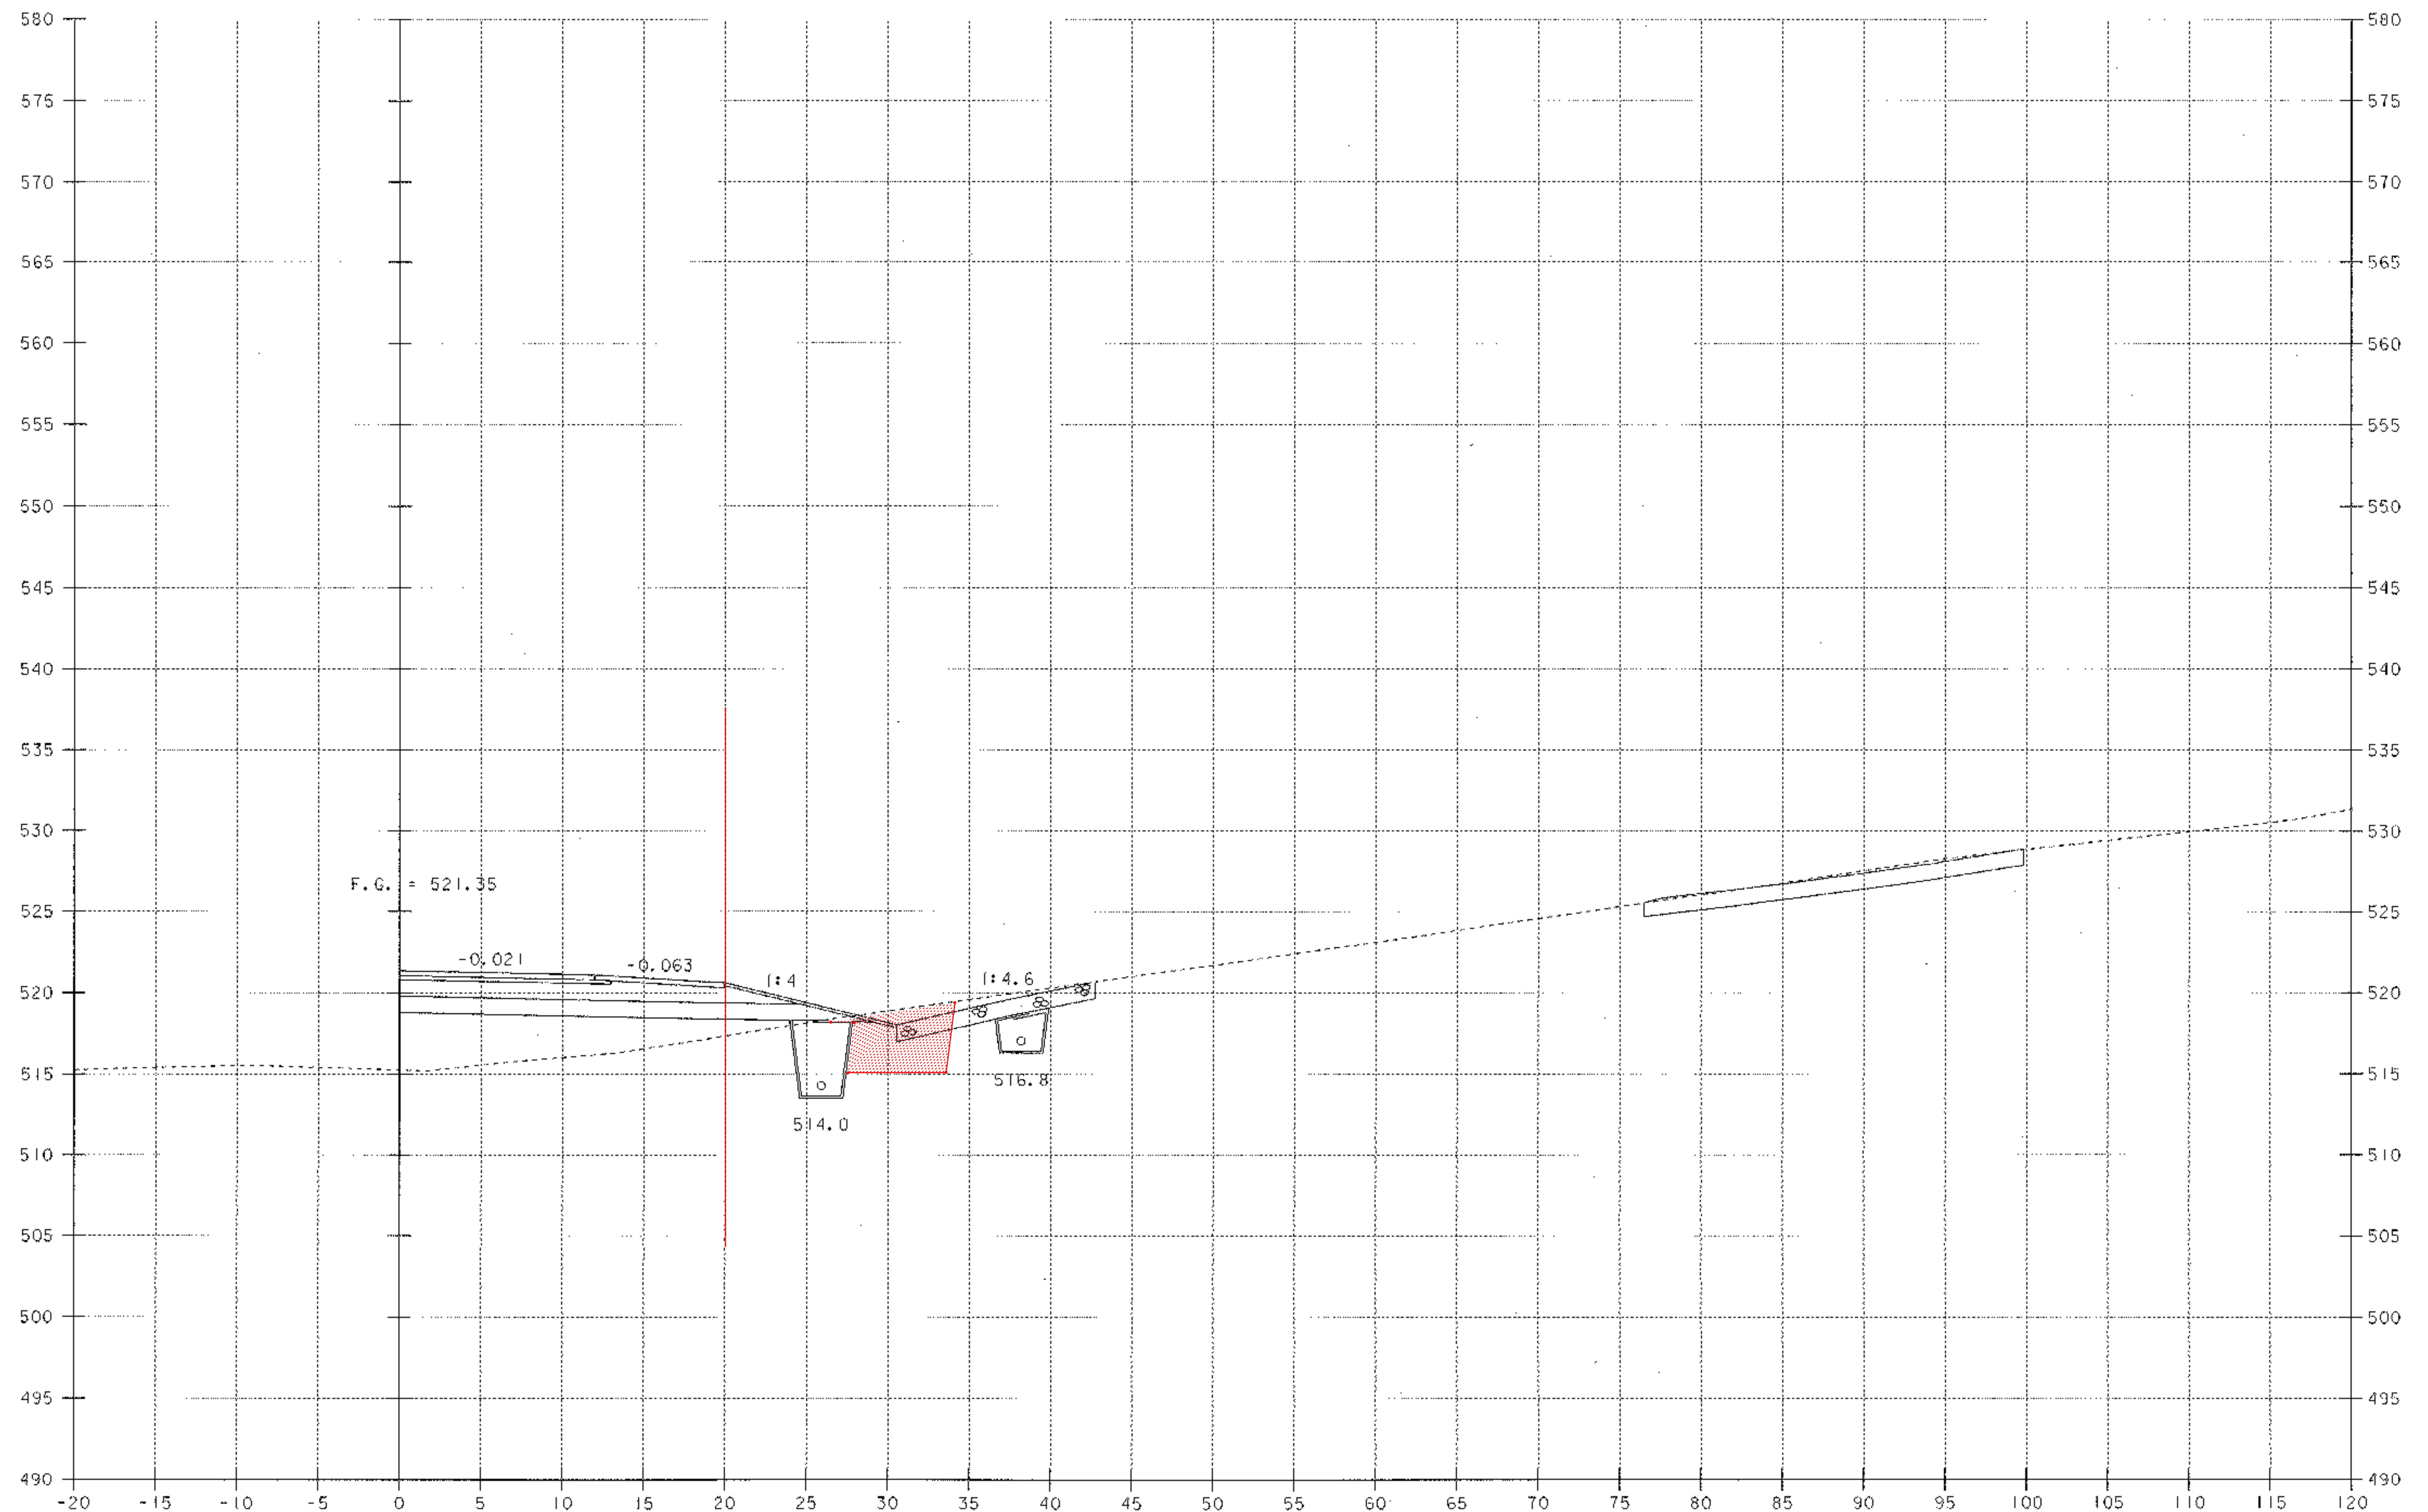

PROJECT NAME:	MORETOWN
PROJECT NUMBER:	STP EGC RSEGC 0167 (9)
FILE NAME:	\\78el32\Structures\sel32t22.j
PROJECT LEADER:	R. R. WHITCOMB
DESIGNED BY:	C. ALLEN
BRIDGE SHEET	BR337
PLOT DATE:	12-MAY-2000
DRAWN BY:	G. ROY
CHECKED BY:	C. ALLEN
SHEET	145V OF 243