


REV. 196+50

REV. 196+40 RT.
END RETAINING WALL NO. 2

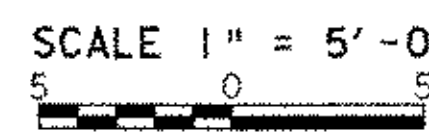

PROJECT NAME: MORETOWN
PROJECT NUMBER: STP EGC RSEGC 0167 (9)

FILE NAME: \78e132\Structures\se132t13.i PLOT DATE: 12-MAY-2000
PROJECT LEADER: R. R. WHITCOMB DRAWN BY: G. ROY
DESIGNED BY: C. ALLEN CHECKED BY: C. ALLEN
BRIDGE SHEET BR328 SHEET 145M OF 243