


520.73

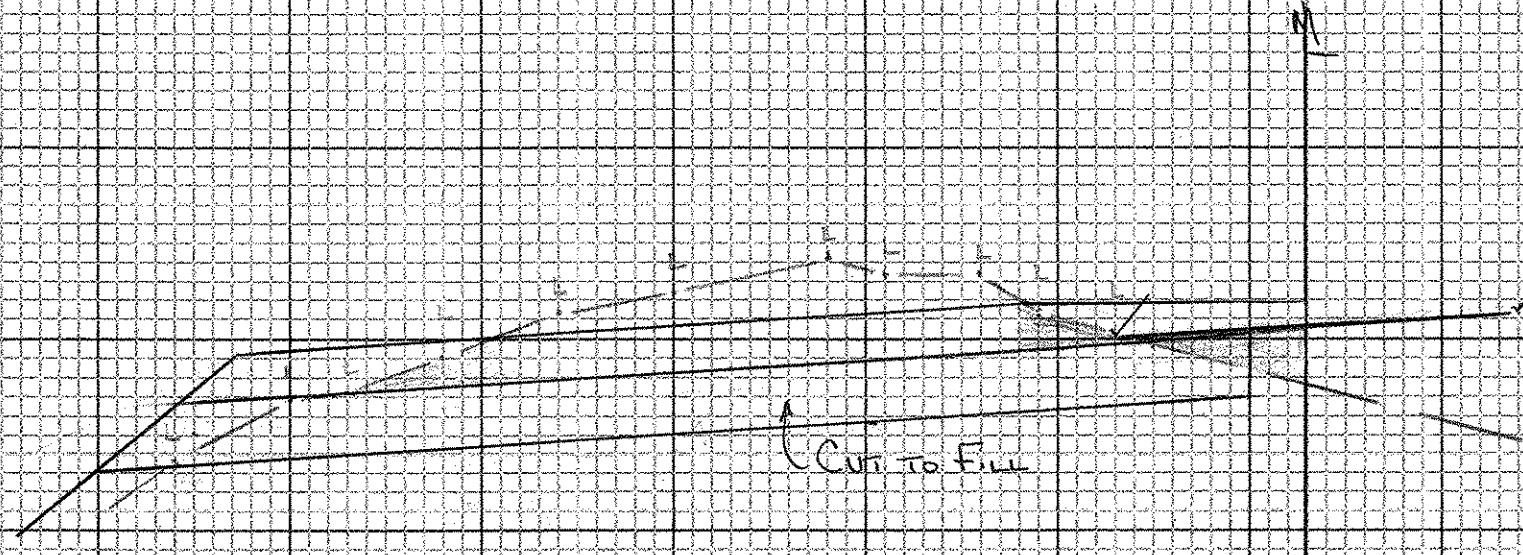

520.00

Q

210.03

CROSS SECTION SHEET

PROJECT NAME: MORETOWN-MIDDLESEX R50167(a)
PROJECT NUMBER: _____
FILE NAME: ROUTE 100B LEDGE SECTION PLOT DATE: 05-JUN-2000 09
PROJECT LEADER: _____ DRAWN BY: STW 1/3/01
DESIGNED BY: _____ CHECKED BY: _____
const: g:/common/cadd/e-xsection.dgn SHEET _____ OF _____