



510

211+44.74 =  
SURV 211+50.00

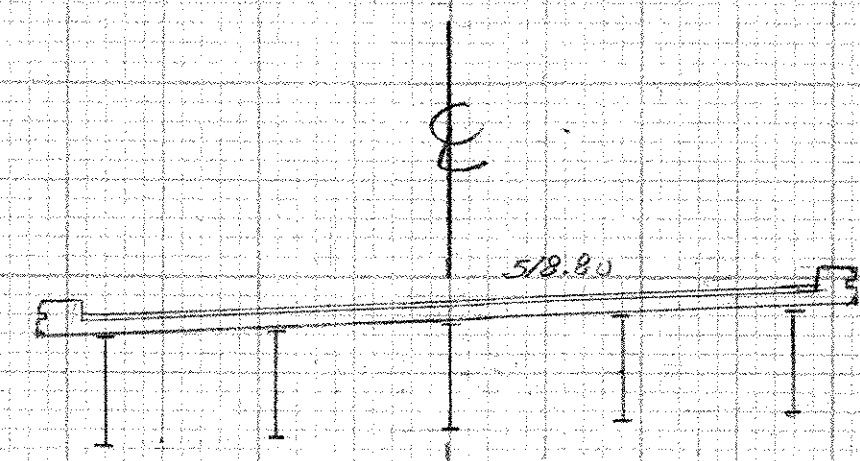

470

210+95.16 = SURV 211+00.00

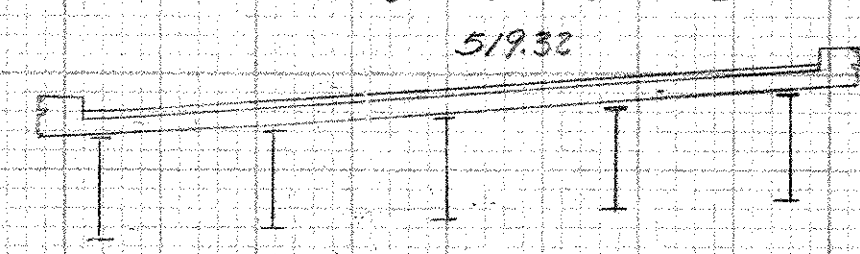

490

210+70.39 =  
SURV 210+75.00

RIVER

RIVER

MDS

OR

ERD

ER

FROM STA. 210+75	TO STA. 211+90
PROJECT NAME	MORETOWN-MIDDLESEX
NO.	BRS0167 (11)
SURVEYED BY	MOREAU
SHEET 230 OF 243 SHEETS	PLOTTED 05/04/87 01/86 0039

SCALE 1" = 10 FEET