


216+88.02  
 END PROJECT BRS 0167(11)  
 CONSTRUCT U.S. 2 APPROACH

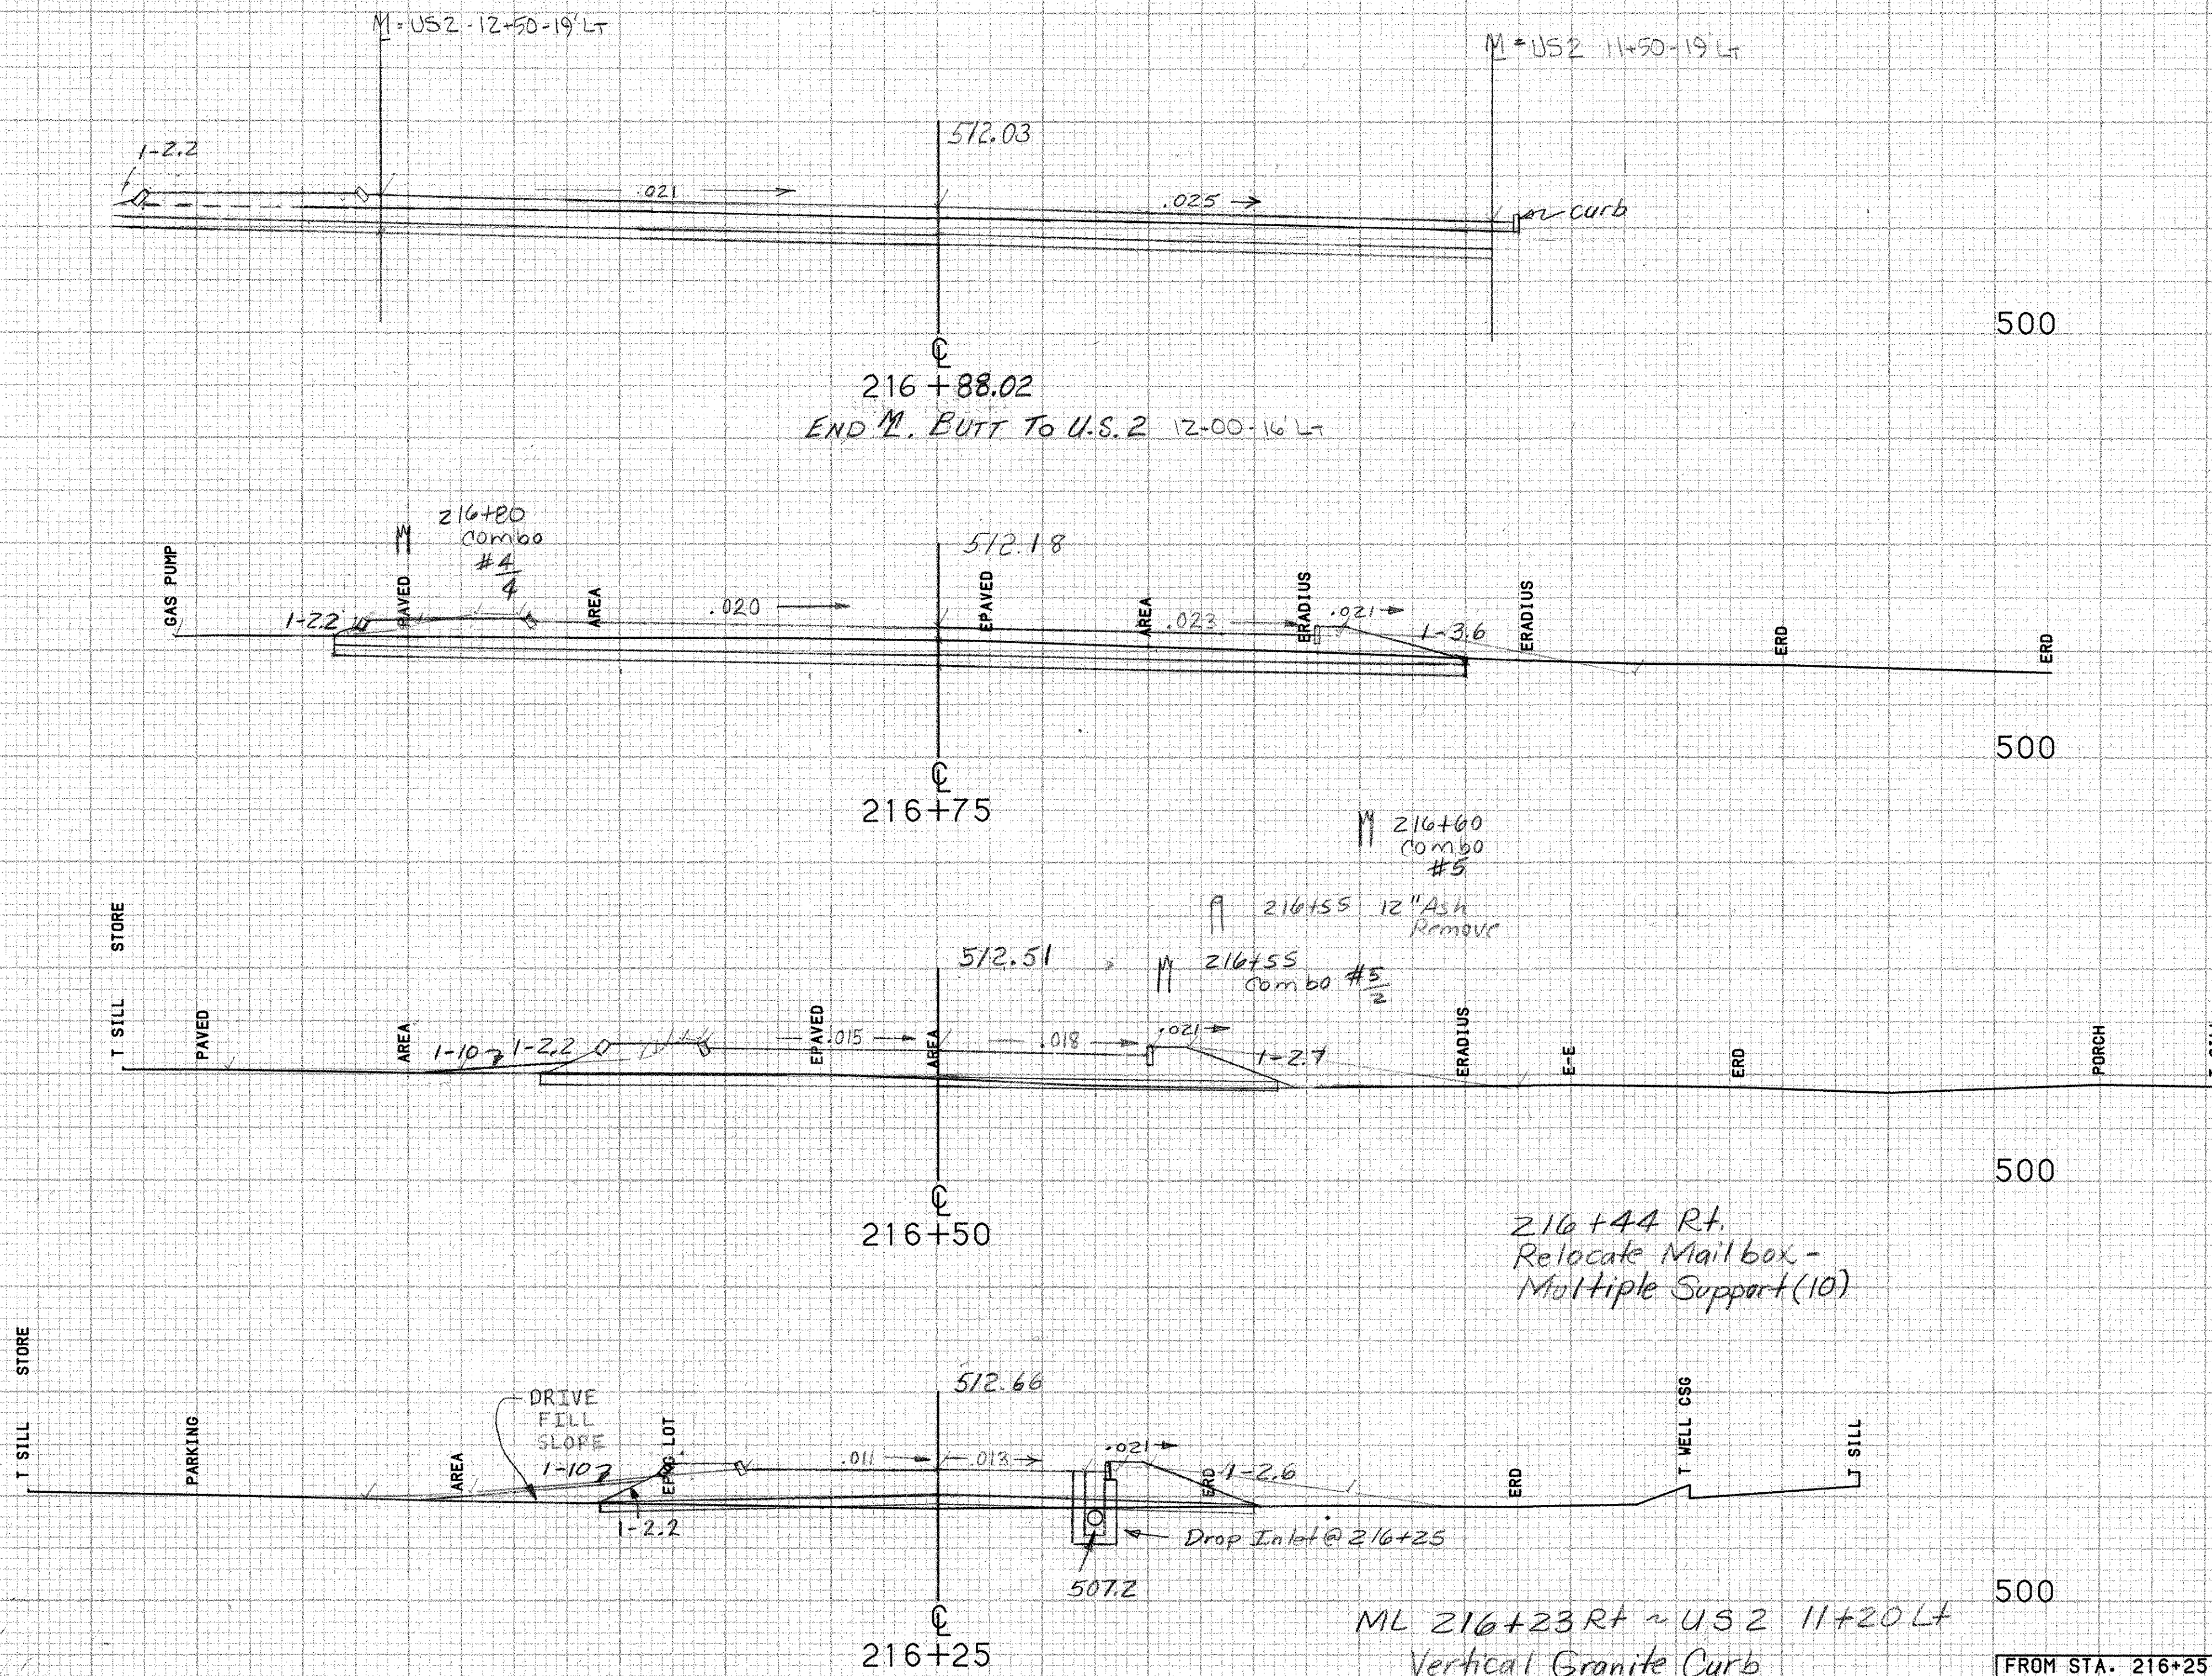

500

500

500

500

FROM STA. 216+25	TO STA. 217+00
PROJECT NAME	MORETOWN-MIDDLESEX
NO.	BRS0167 (1-1)
SURVEYED BY	MOREAU
SHEET 234 OF 243	PLOTTED 05/04/87
	01/86 0039

SCALE 10 FEET