


PC @ 9+85.00
 M 9+90
 Combo 4/01

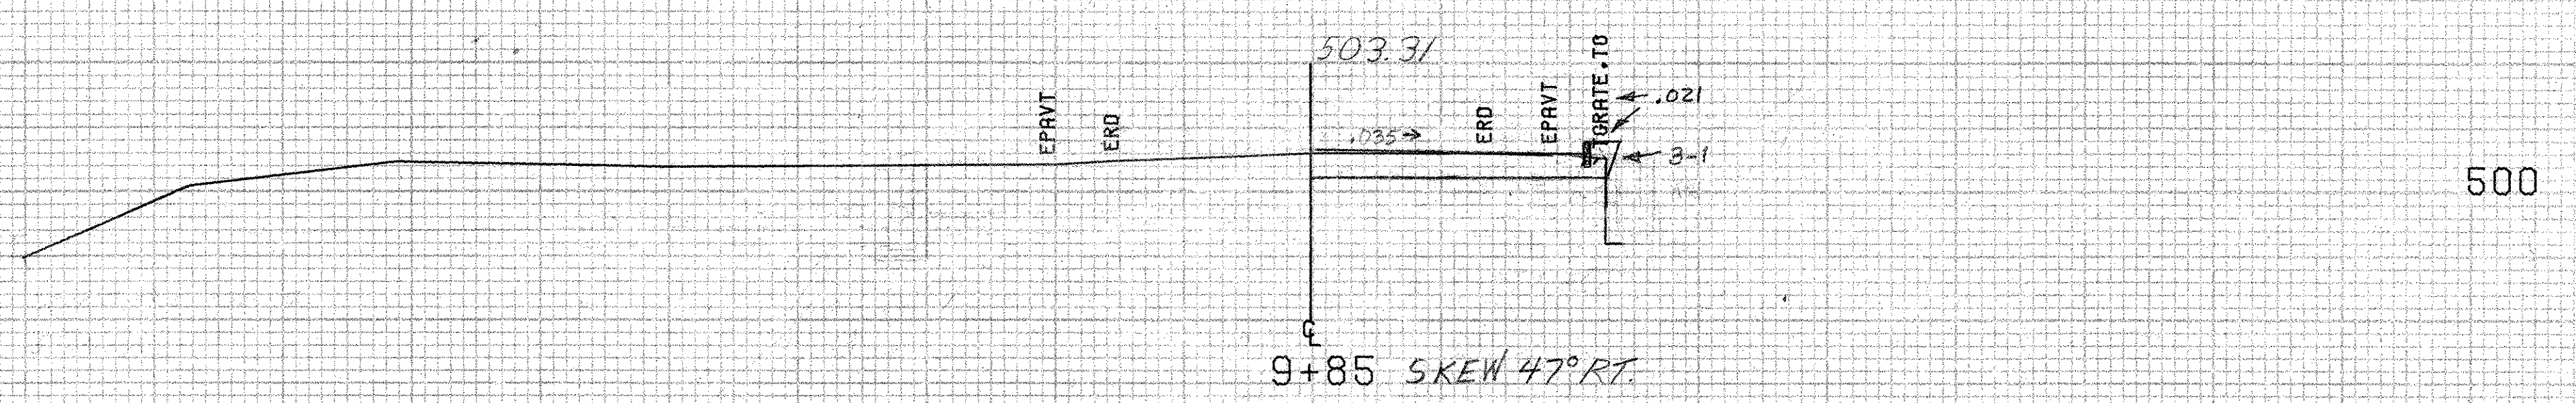

FROM STA. 9+85 TO STA. 10+02
 PROJECT NAME MORETOWN-MIDDLESEX RTE2
 NO. BR50167(U) PLOTTED 02/14/85
 SURVEYED BY JVE
 SHEET 230 OF 243 SHEETS JAN 1985

SCALE 10 FEET