


12" SUBBASE *
* 3" Subbase of Crushed Gravel (Fine Graded) over 9" of Dense Graded Crushed Stone

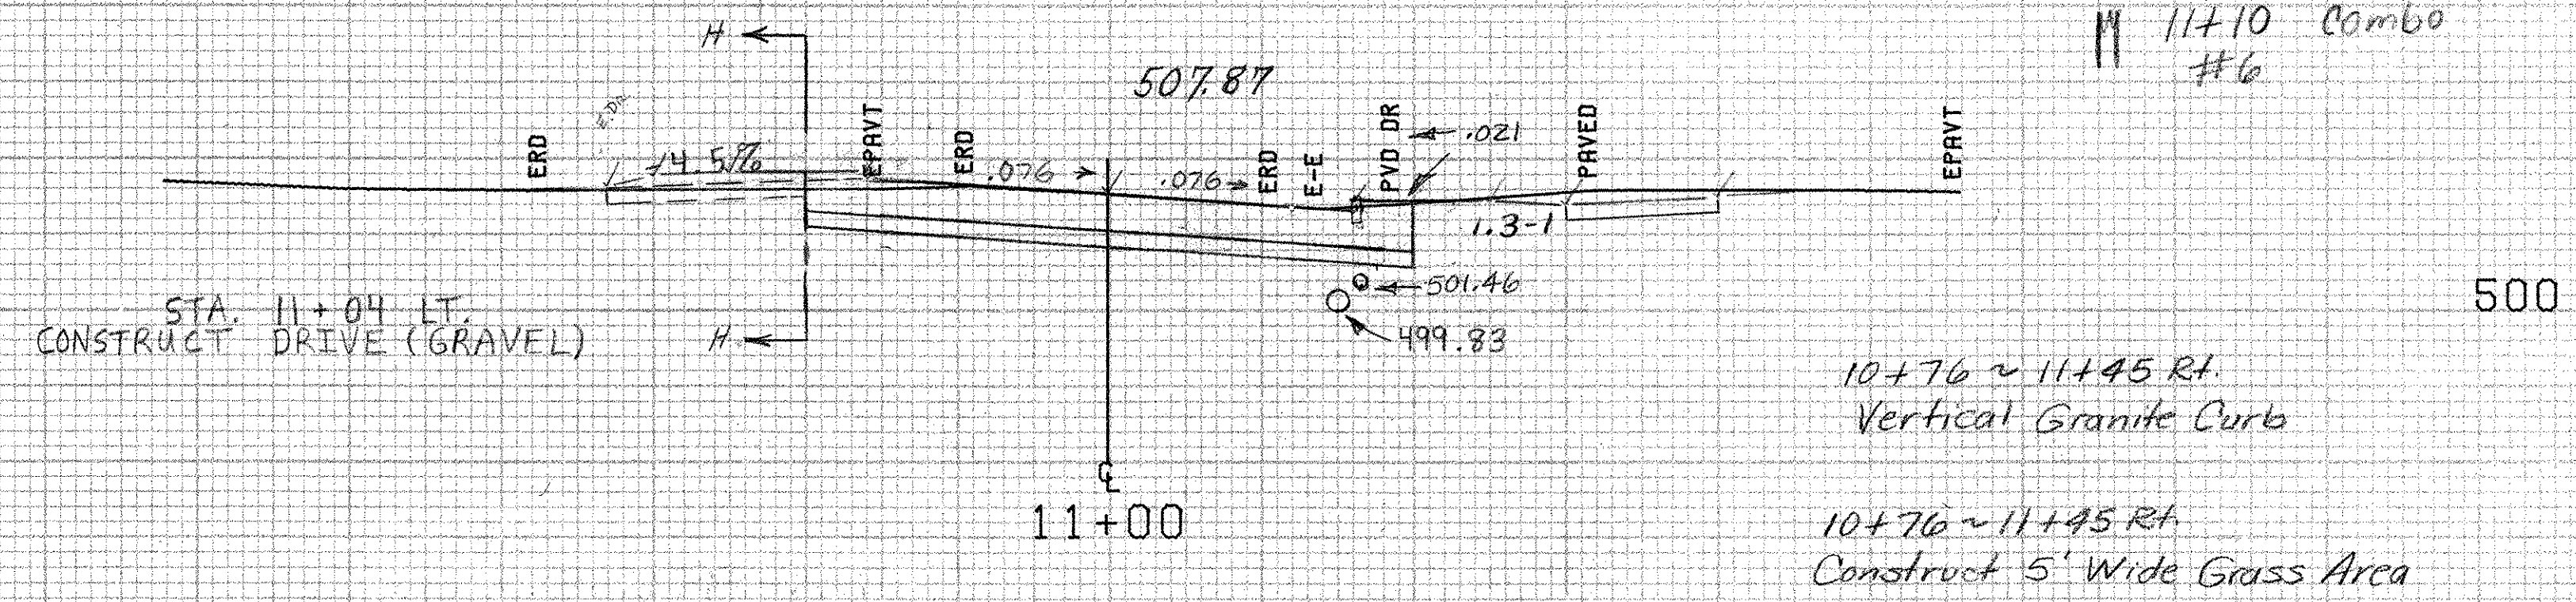


10+87 ~ 12+00 RT.
NEW 6" x 113" UNDERDRAIN
w/ FB @ 12+00 RT.

10+87 ~ 12+02 RT.
NEW 18" x 108" RCP CL. III
OR CPEP (SL)


10+62 ~ 10+87 LT.
Vertical Granite Curb

10+55 ~ 10+95 LT.
Construct 5' Wide
Grass Area

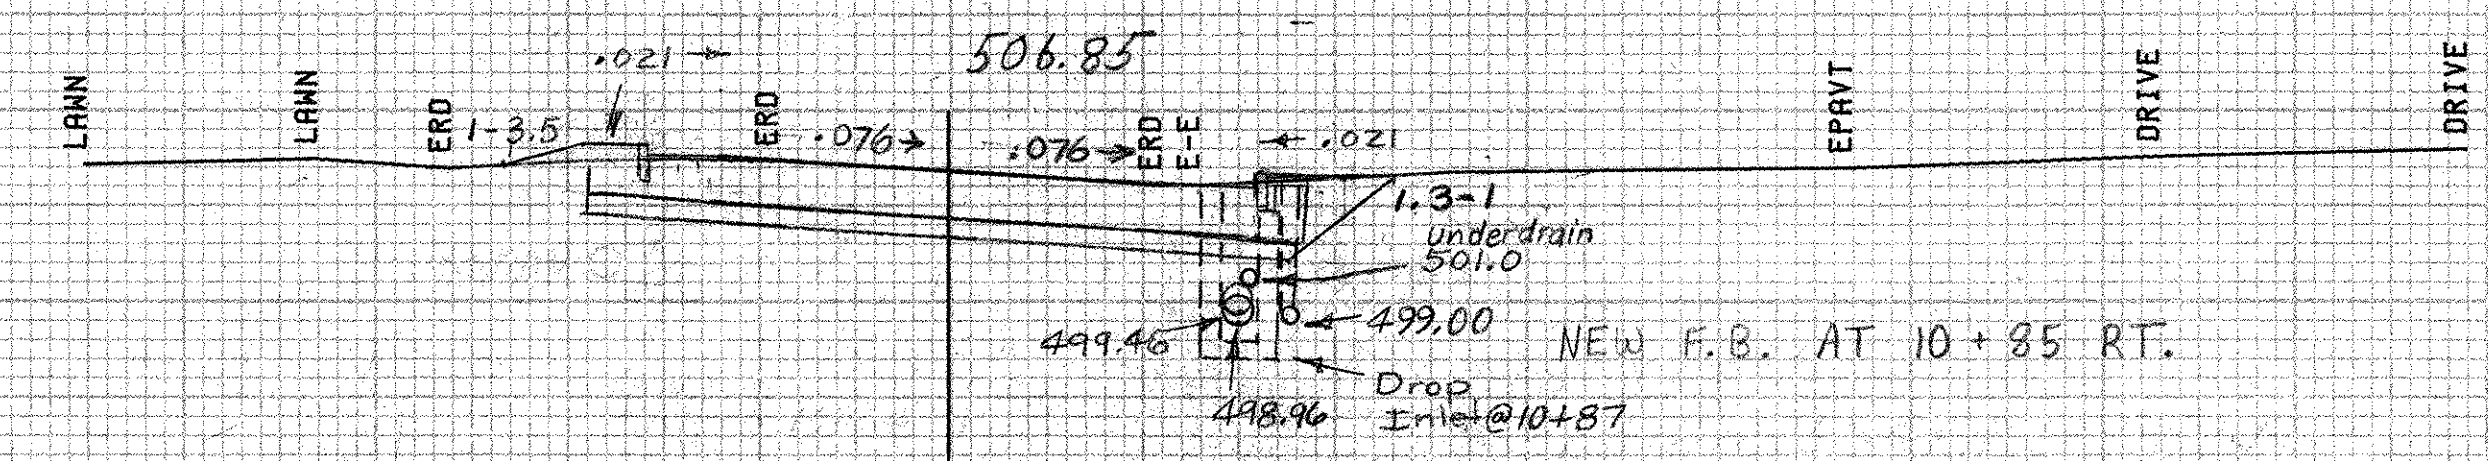


FOR GRAVEL DRIVE:
3" Subbase of Crushed Gravel (Fine Graded) over 9" of Dense Graded Crushed Stone

SECTION A-A

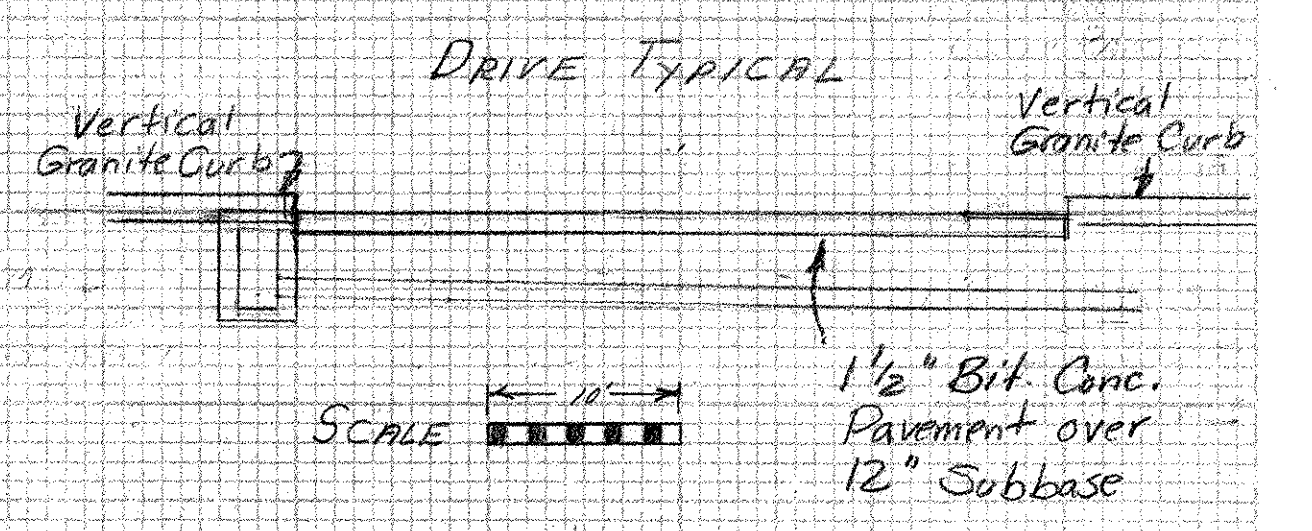

10+53 RT
CONSTRUCT DRIVE
(PAVED + GRAVEL)

12" Subbase *
* 3" Subbase of Crushed Gravel (Fine Graded) over 9" Dense Graded Crushed Stone

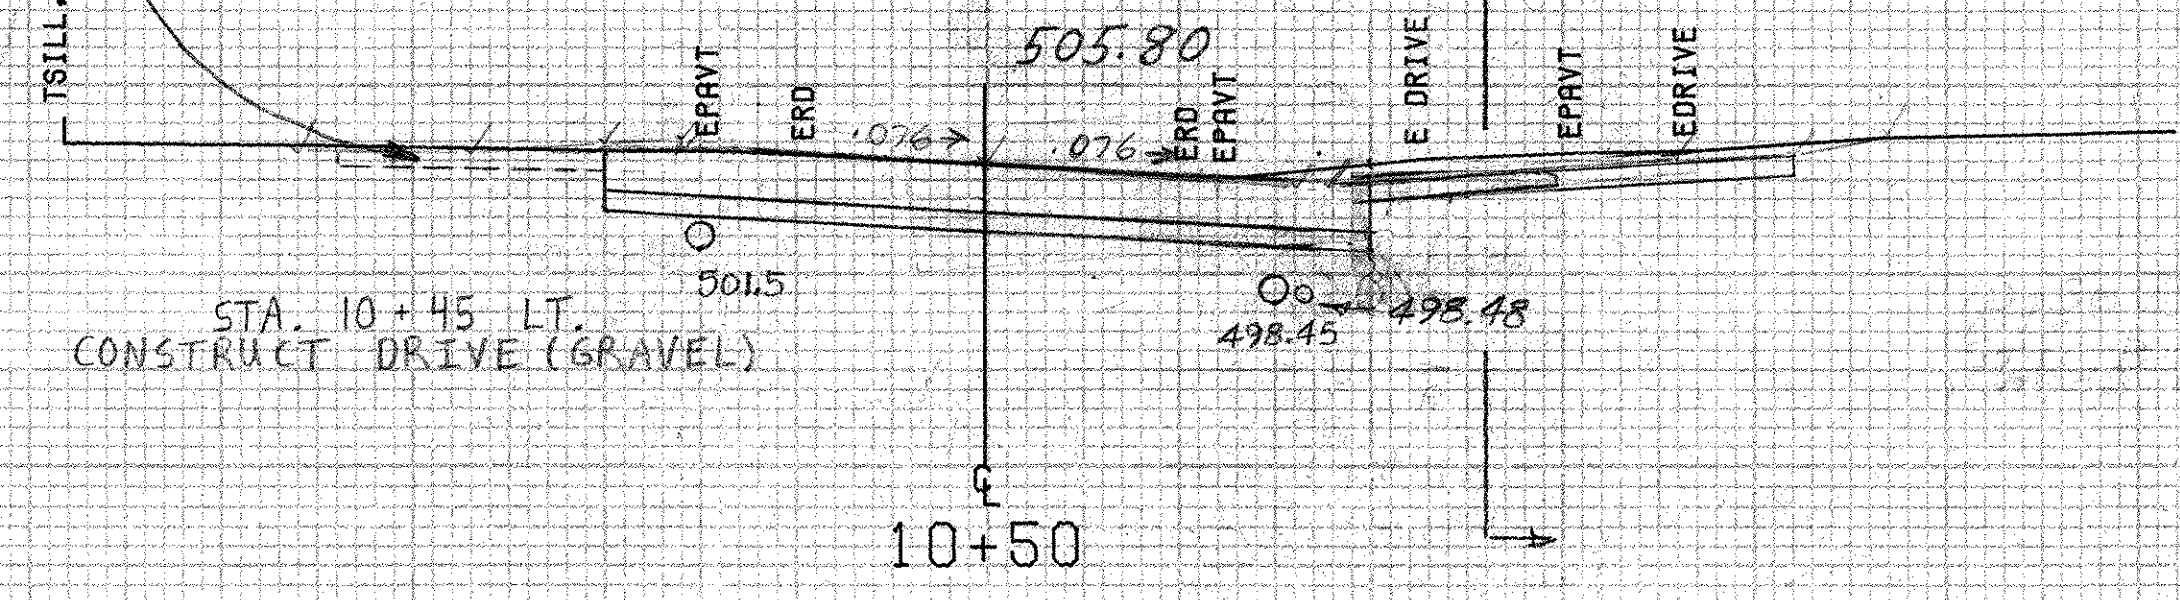

10+11 ~ 10+36 LT.
Construct 5' Wide
Grass Area

FROM STA. 10+50	TO STA. 11+00
PROJECT NAME MORETOWN-MIDDLESEX RTE2	
NO. BR50167(1)	PLOTTED 02/14/85
SURVEYED BY NYE	JAN 1985
SHEET 237 OF 243 SHEETS	

SCALE 10 FEET