


500

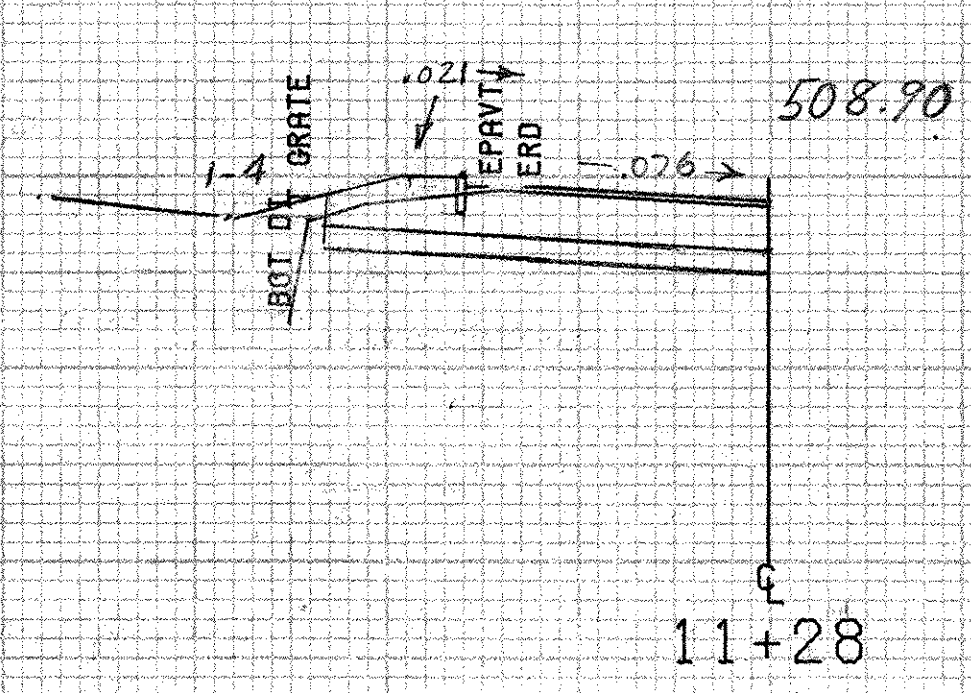


500

11+25 LT. ~ 13+71 LT. EXIST. 15" RCP
REMOVE EXIST. PIPE AND DI @ 13+71 LT.

11+25 ~ 12+27 RT. EXIST. 15" RCP
REMOVE EXIST. PIPE AND DI @ 12+27 RT.

USE 11+20 LT ~ ML 216+23 RT.
Vertical Granite Curb

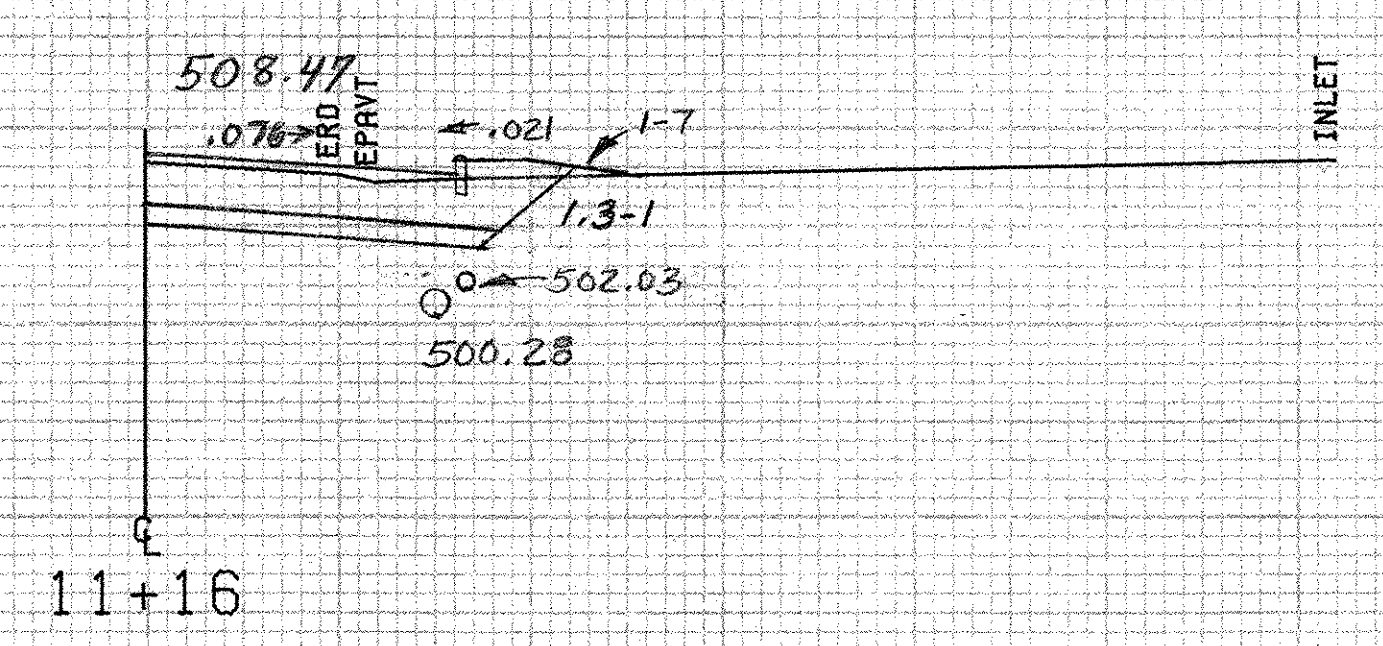

500

FROM STA. 11+16 TO STA. 11+50
PROJECT NAME MORETOWN-MIDDLESEX RTE2
NO. BR0167(0) PLOTTED 02/14/85
SURVEYED BY NYE JAN 1985
SHEET 23 OF 24 SHEETS

SCALE 1" = 10 FEET