



M. POT 217+04.02 =  
RTE 2 P.O.C. 12+00.00

12+16 ~ 12+19 RT.  
Remove Existing Fence

12+02 ~ 12+48 RT.  
NEW 6" x 46" UNDERDRAIN  
w/ FB @ 12+48 RT.

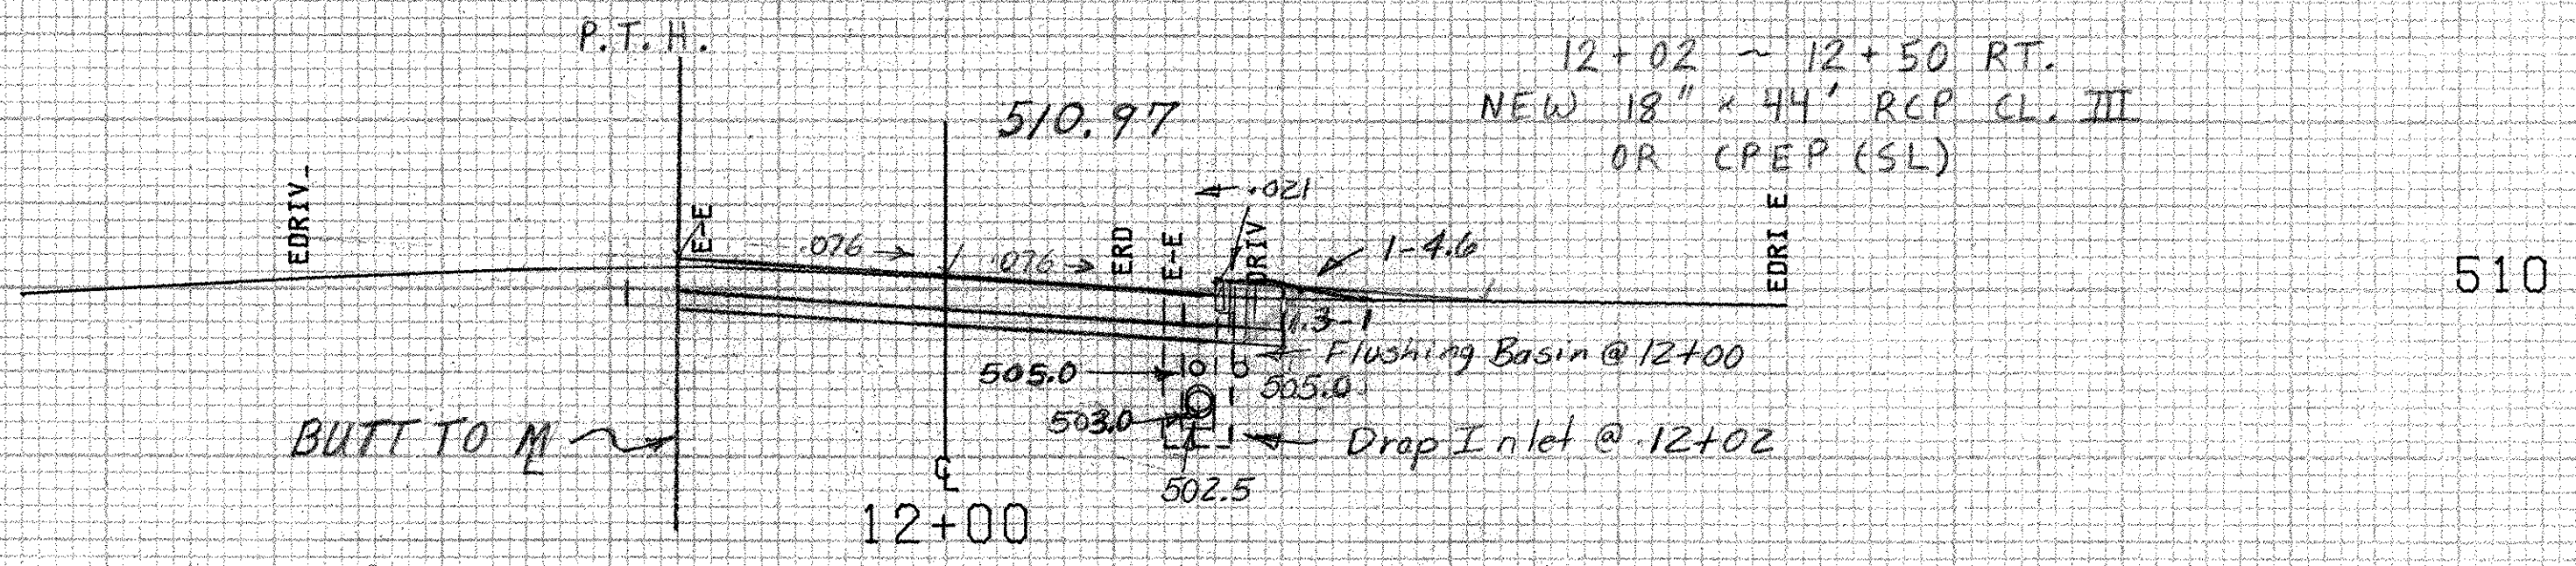

11+91 ~ 12+23 RT.  
Vertical Granite Curb

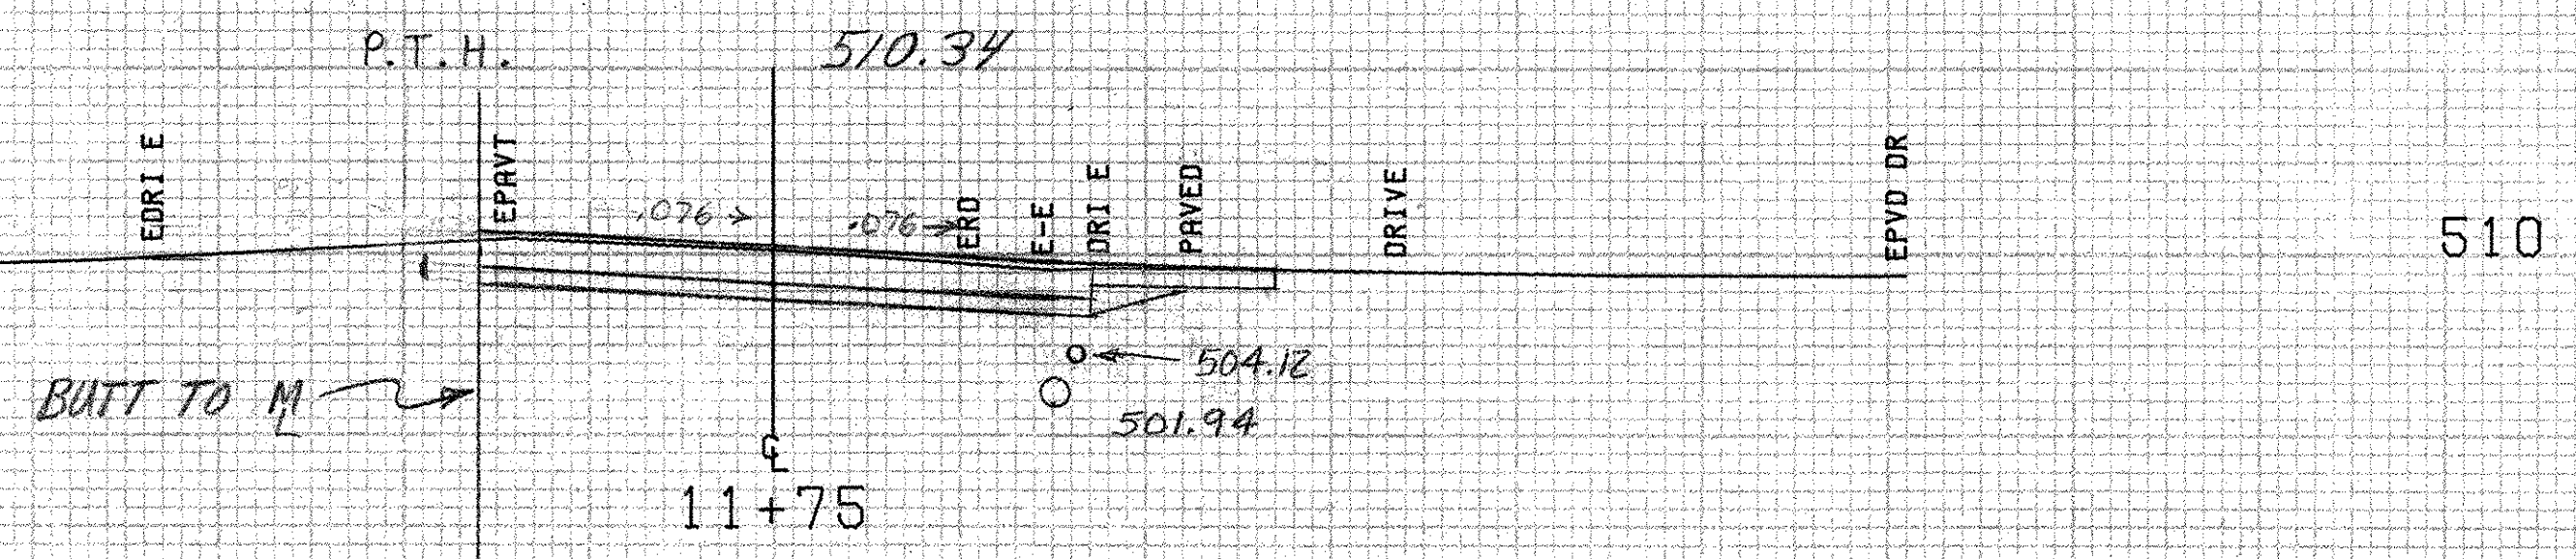

|              |                         |         |          |
|--------------|-------------------------|---------|----------|
| FROM STA.    | 11+75                   | TO STA. | 12+27    |
| PROJECT NAME | MORNTOWN-MIDDLESEX RTE2 |         |          |
| NO.          | BR50167(II)             | PLOTTED | 02/14/86 |
| SURVEYED BY  | NYE                     | JAN     | 1985     |
| SHEET        | 239                     | OF 245  | SHEETS   |

SCALE 10 FEET