



510

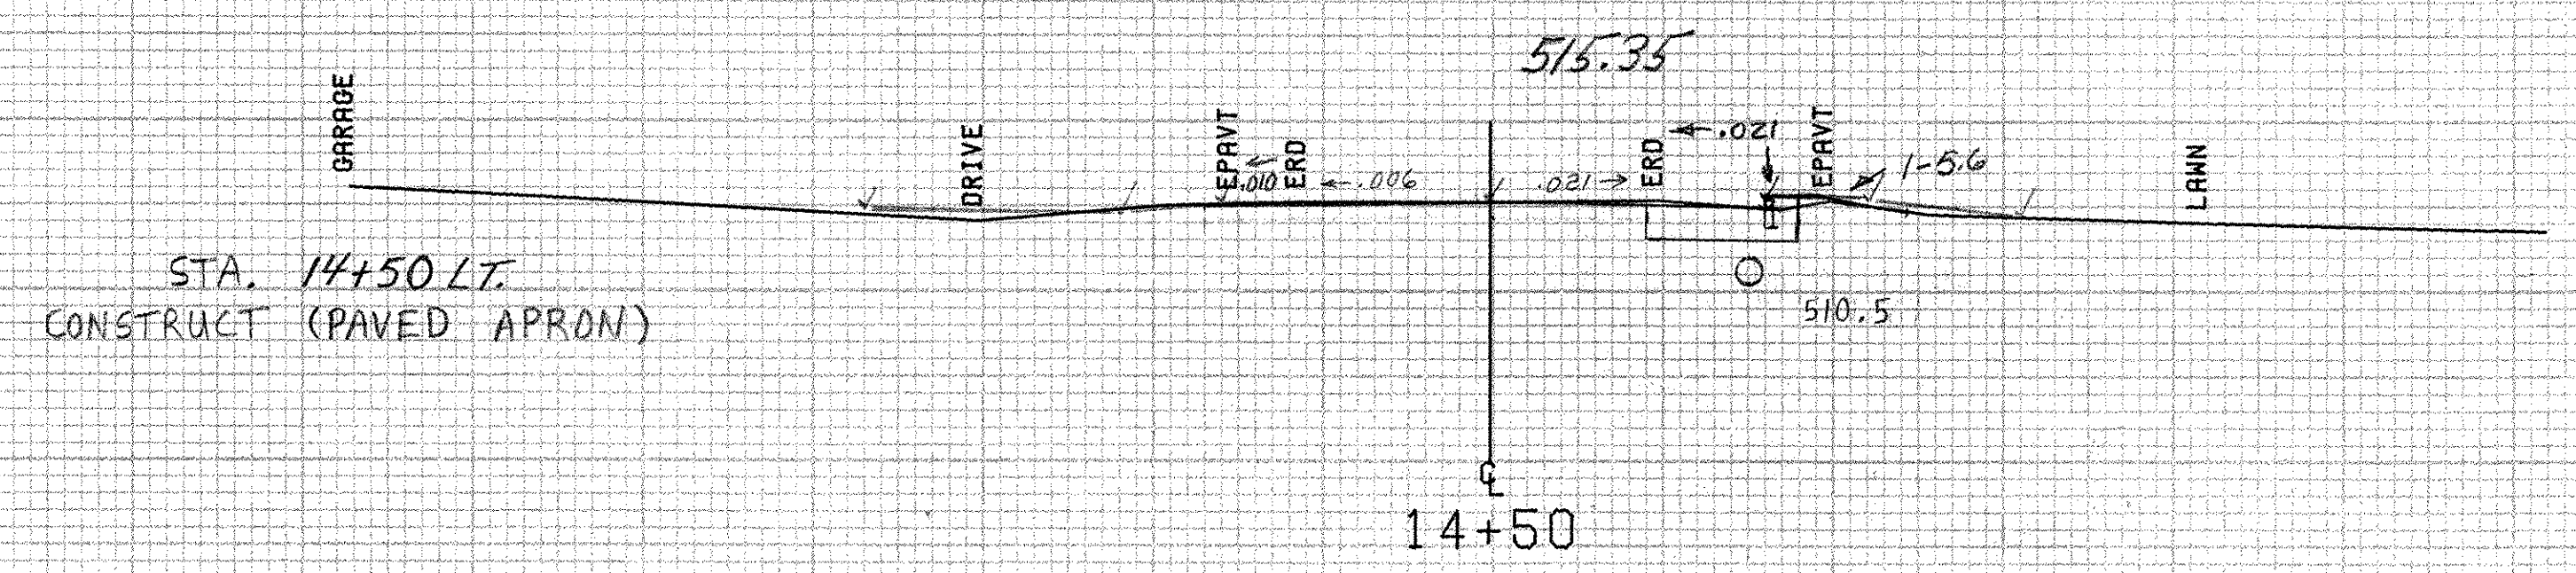

510

STA. 14+50 LT.
CONSTRUCT (PAVED APRON)

14+25 @
END REMOVAL OF PORTLAND
CEMENT CONCRETE PAVEMENT
BEGIN REMOVAL OF BITUMINOUS CONCRETE PAVEMENT
TO 1 1/2" DEPTH BY COLD PLANING
BEGIN 1 1/2" BITUMINOUS CONCRETE OVERLAY

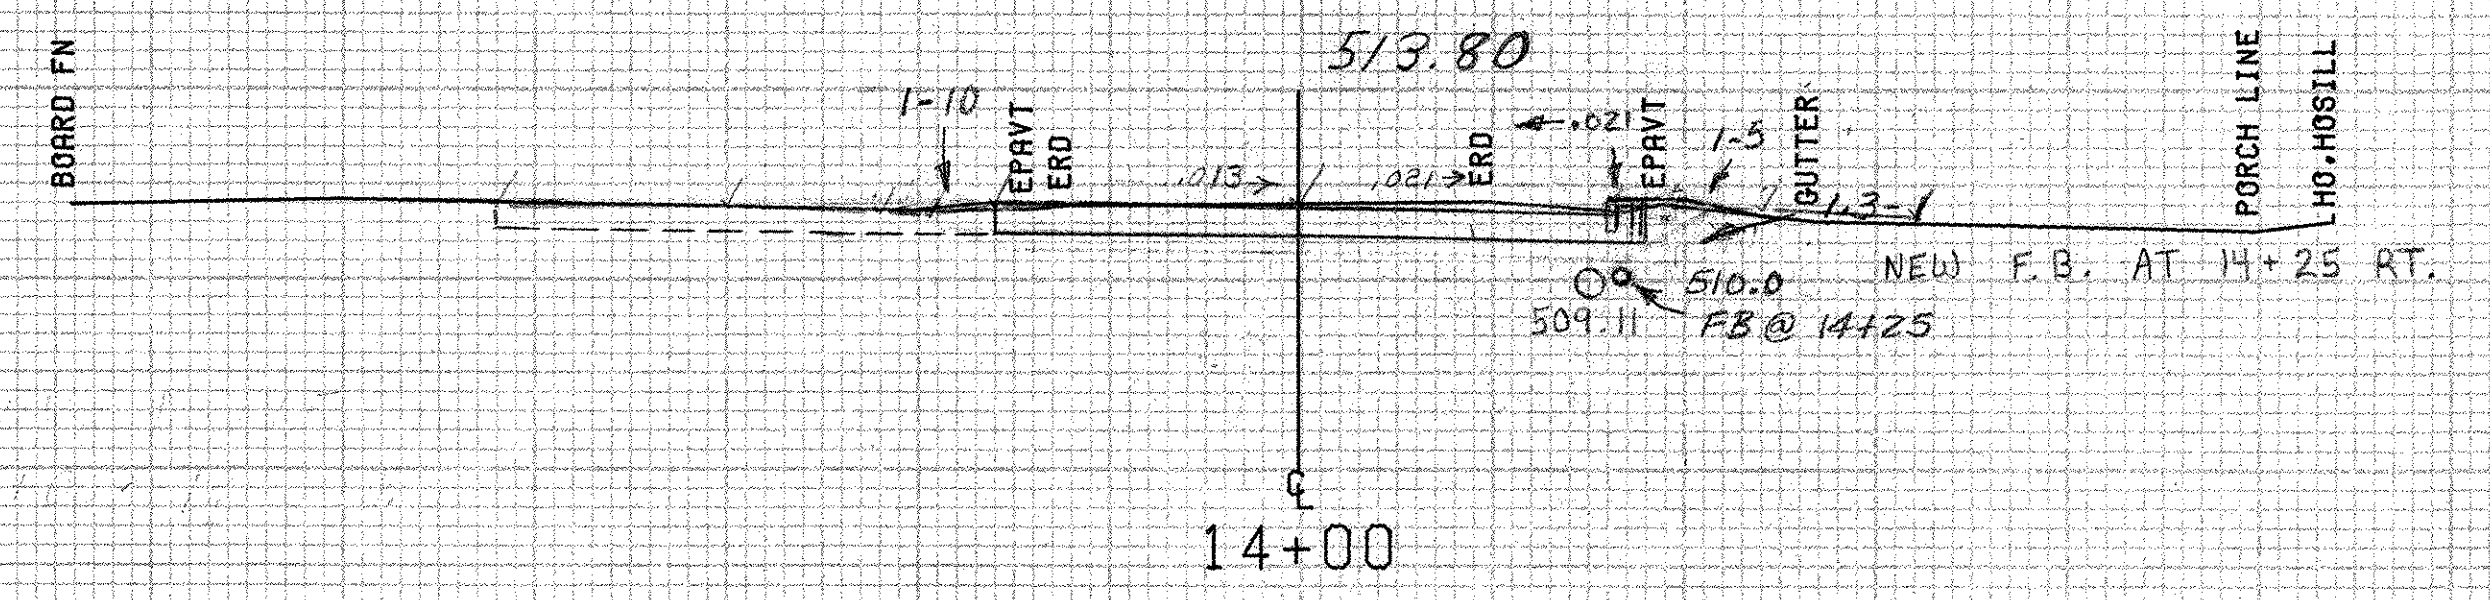

510

FROM STA. 14+00 TO STA. 14+58
PROJECT NAME MORETOWN-MIDDLESEX RTE2
NO. BR50167(II) PLOTTED 02/14/85
SURVEYED BY JVE JAN 1985
SHEET 242 OF 243 SHEETS

SCALE 10 FEET