


16+63 LT.  
 END EXCAVATION OF SURFACES AND PAVEMENTS  
 (Area to be topsoiled, seeded and mulched)


U.S. 2 STA. 16+63 E  
 END APPROACH CONSTRUCTION

U.S. 2 STA. 15+85 E  
 END REMOVAL OF BITUMINOUS CONCRETE PAVEMENT  
 END 1 1/2" BITUMINOUS CONCRETE OVERLAY


15+50 LT.  
 BEGIN EXCAVATION OF SURFACES AND PAVEMENTS  
 (Area to be topsoiled, seeded and mulched)

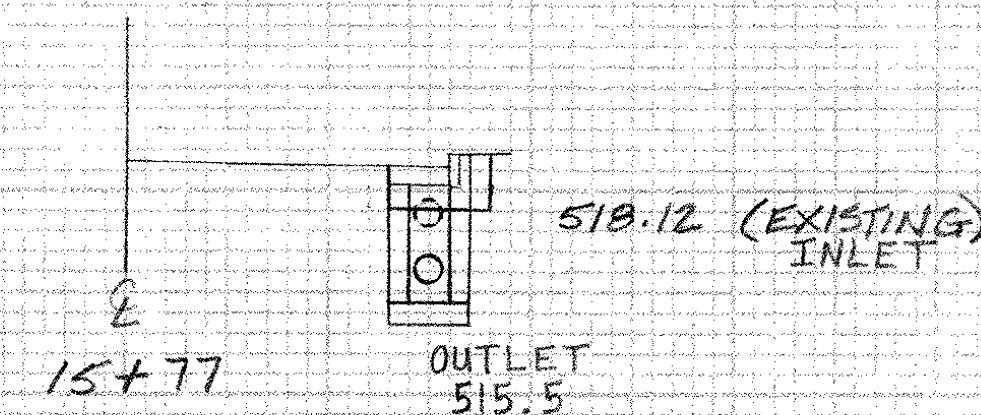



520

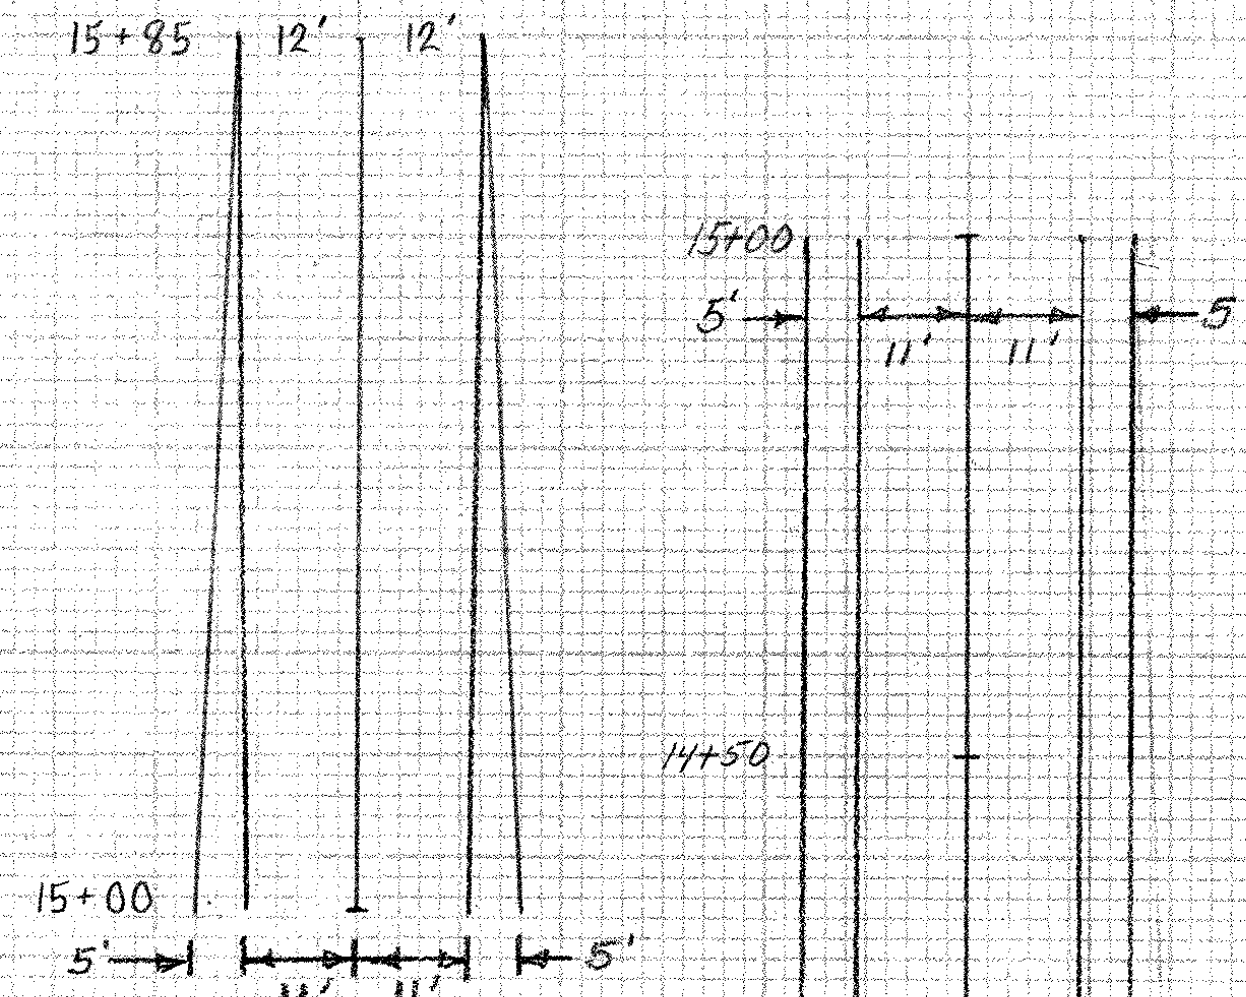

520

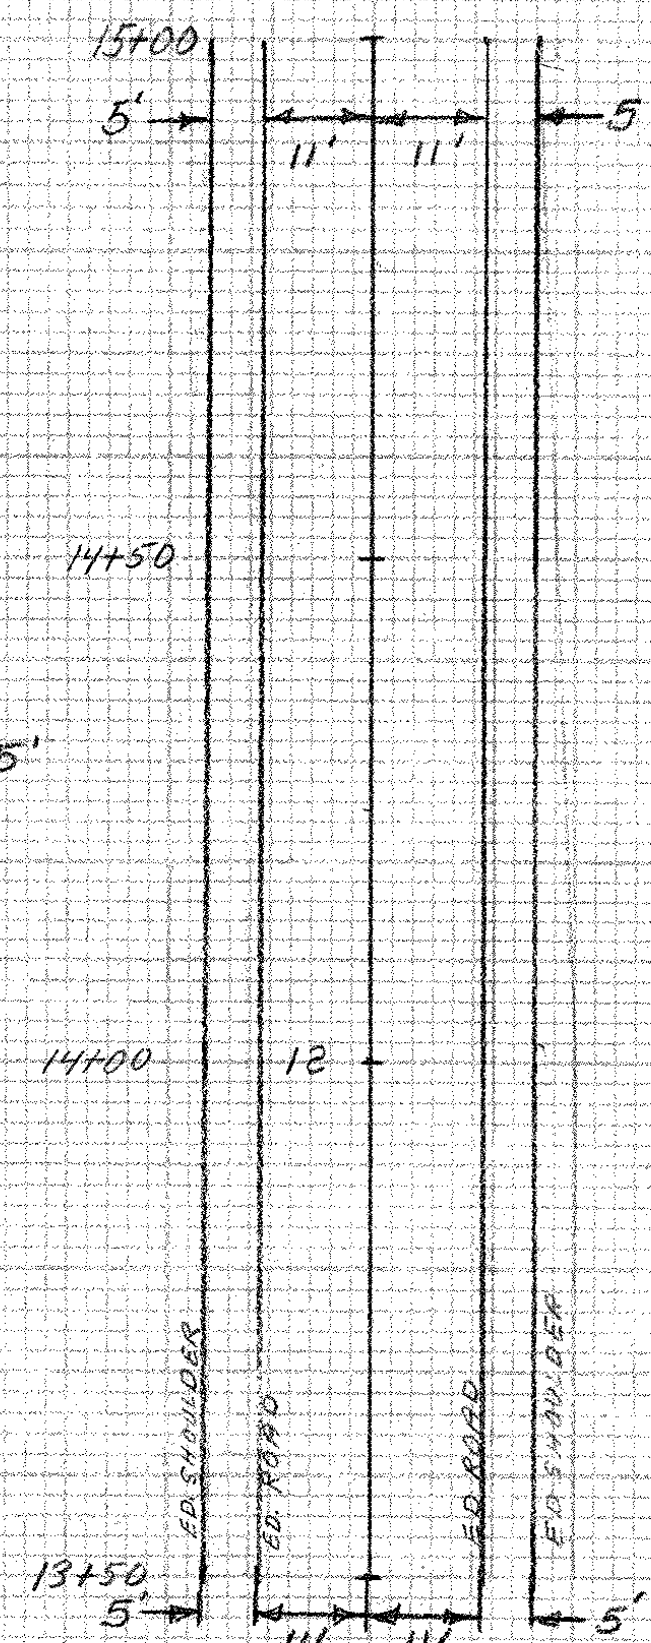


SHOULDER TRANSITION

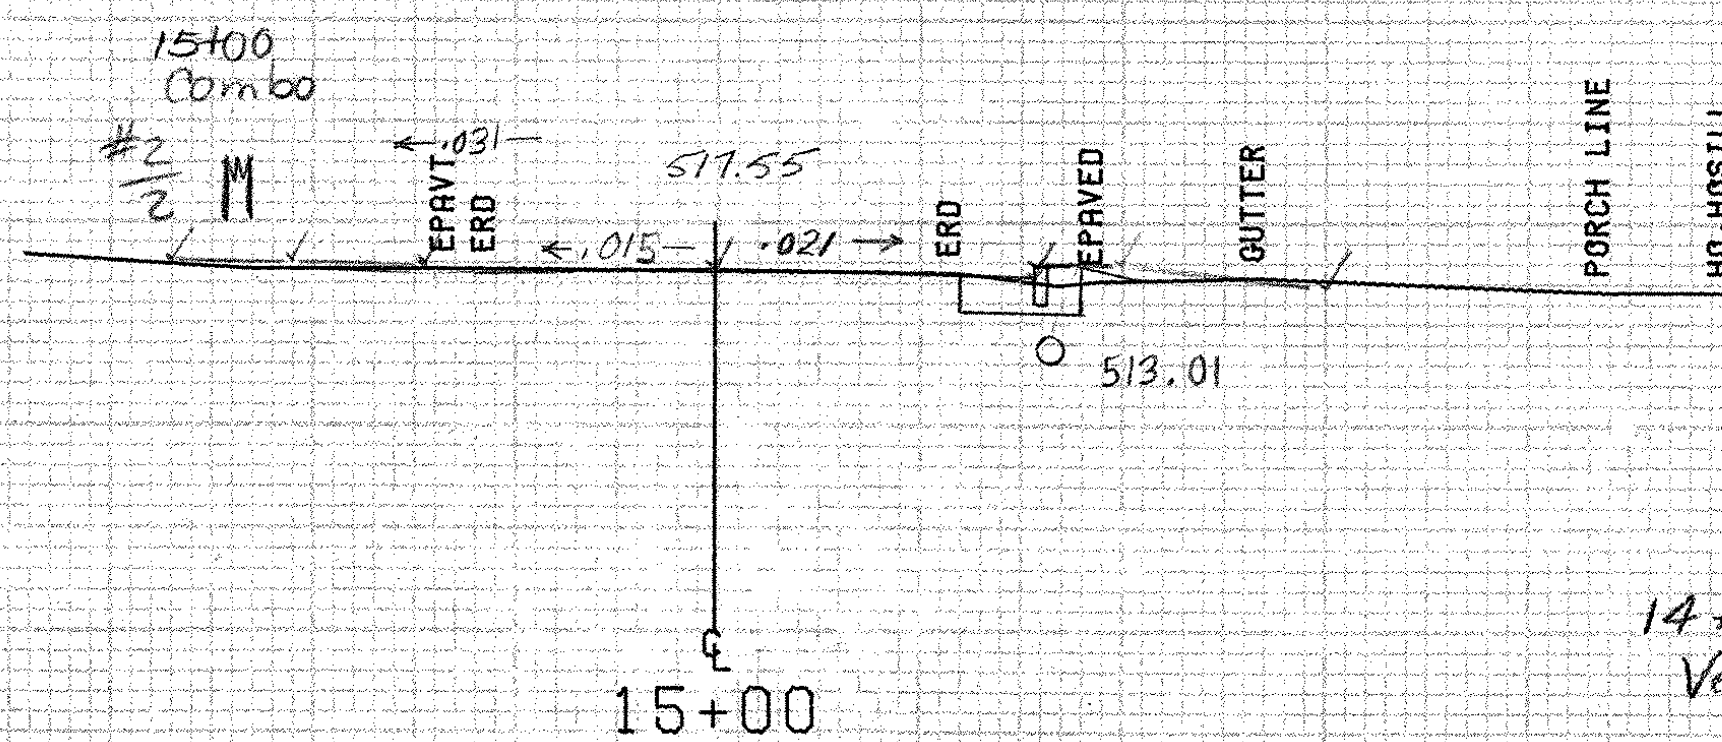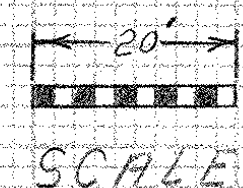


510

14+79 ~ 15+82 RT.  
 Vertical Granite Curb

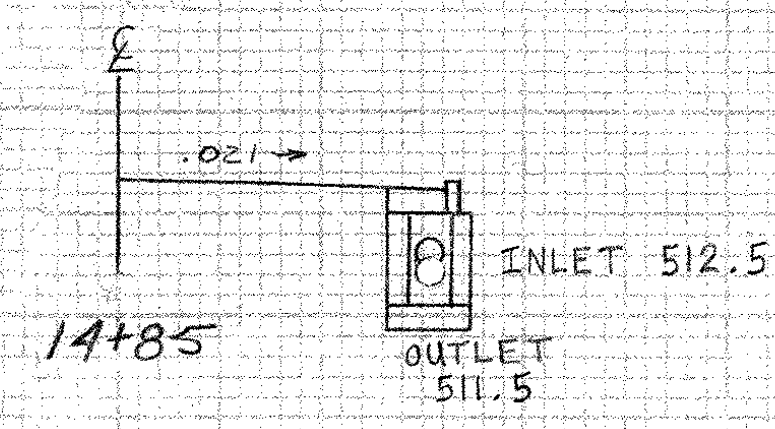

14+85 ~ 15+77 RT.  
 NEW 18" x 88" RCP CL. III OR CPEP (SL): REPLACE EXIST. DI @ 15+77 RT. AND CONNECT TO EXIST. PIPE

510

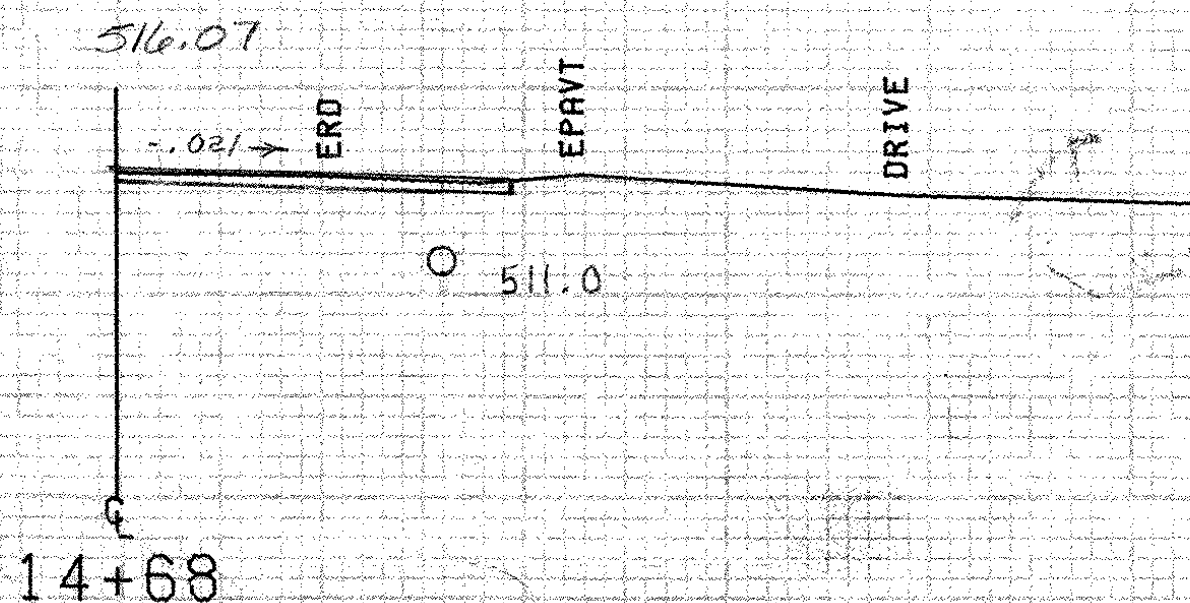

STA. 14+72 RT.  
 CONSTRUCT (PAVED APRON)

510