

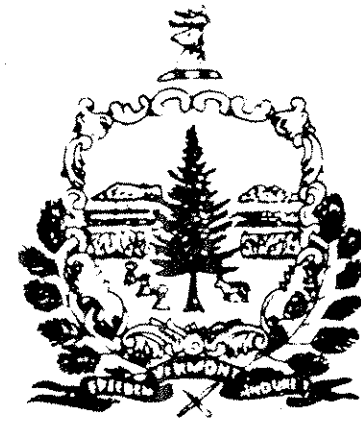


STATE OF VERMONT AGENCY OF TRANSPORTATION

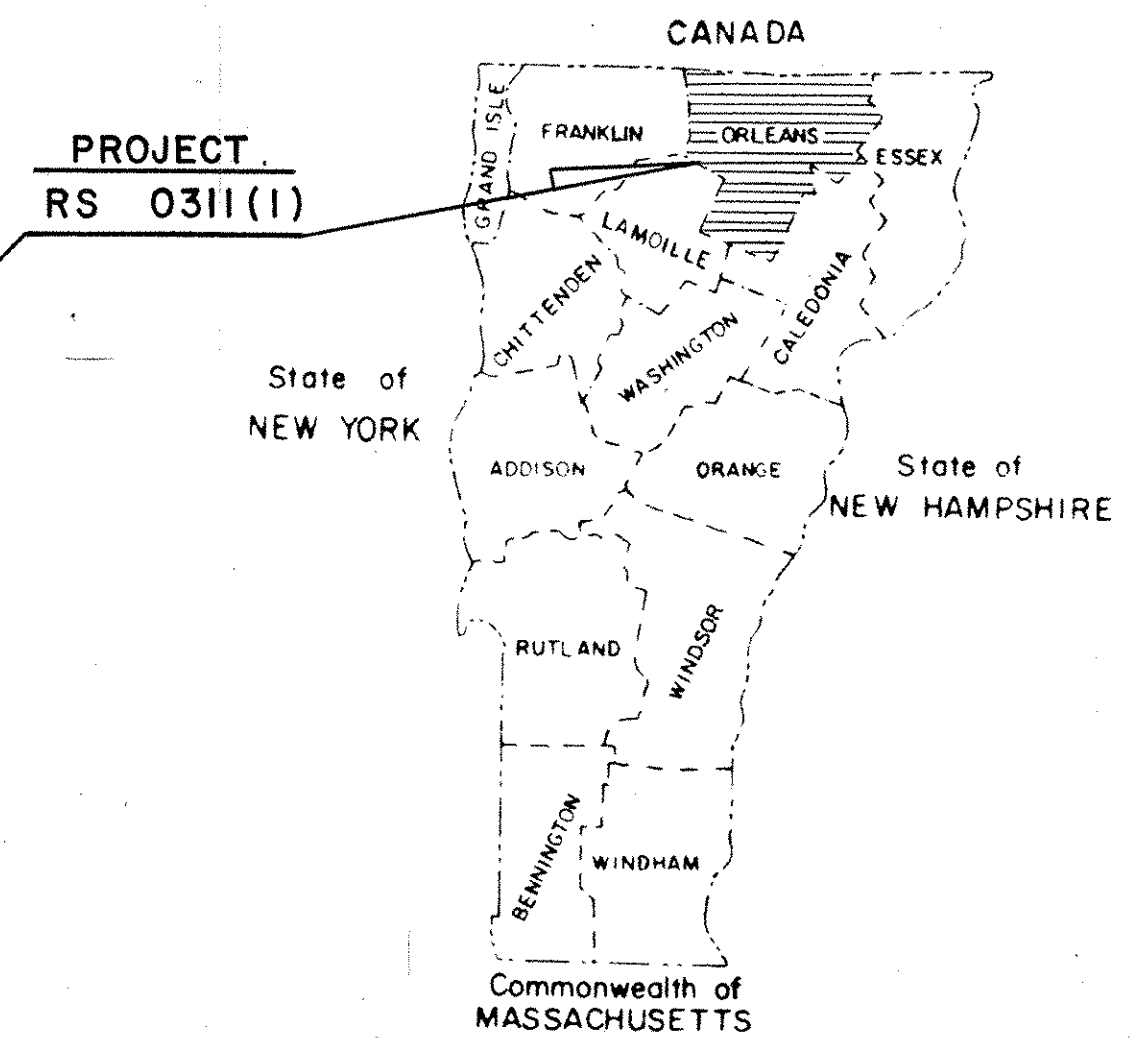

RURAL PROJECT

PROPOSED IMPROVEMENT TOWN OF TROY COUNTY OF ORLEANS ROUTE 101 (FAS)

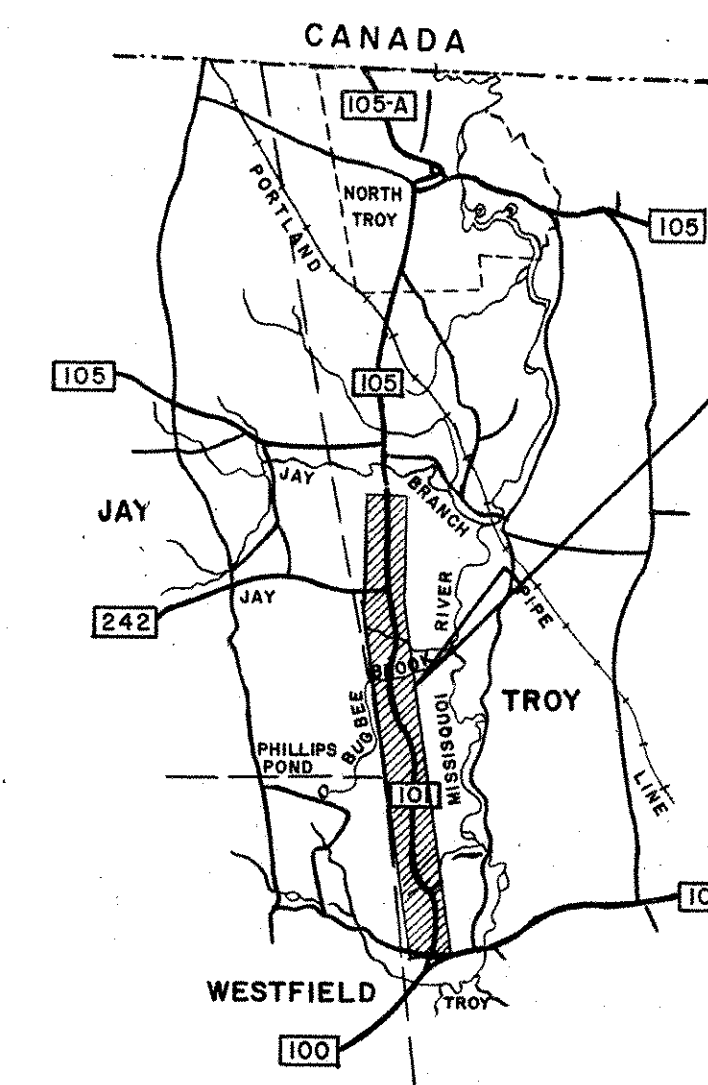

TRAFFIC DATA	
EST. 1990 ADT	= 770
EST. 2010 ADT	= 1050
EST. 2010 DHV	= 145
D	= 55%
T	= 16%
V	= 50 M.P.H.
STATION 110+70.00 - 143+26.12	
V	= 35 M.P.H.

RECORD PLANS

CONTRACTOR *EMARTH CONSTRUCTION INC.*
GROTON, VT
RESIDENT ENGINEER *DOUGLAS BUMPS*
CONSTRUCTION BEGAN 2-13-91
CONSTRUCTION COMPLETED

RECORD PLANS BY *RICHARD RUSSELL*

I hereby certify that all the construction required by this set of drawings has been accomplished as indicated herein.



By *Douglas Bumps* Resident Engineer
Date *2-8-93*

NOTE: Any further information concerning final quantities, amounts or other details relative to this project may be found on microfilm in Central Files.

BEGINNING AT THE INTERSECTION OF ROUTE 101 AND 100 AND EXTENDING NORTHERLY TO A POINT 1800 FEET SOUTH OF THE ROUTE 101 AND 105 INTERSECTION.

LENGTH OF ROADWAY 21465.02 FT. = 4.065 MI.
LENGTH OF PROJECT 21465.02 FT. = 4.065 MI.

WORK DESCRIPTION
WORK TO BE PERFORMED UNDER THIS PROJECT INCLUDES GRADING, DRAINAGE, SUBBASE AND PAVEMENT FOR A STATE HIGHWAY GENERALLY ALONG EXISTING ALIGNMENT.

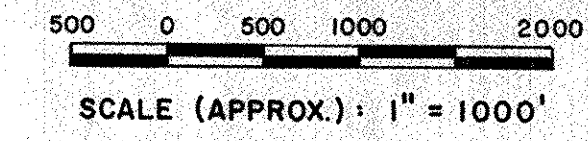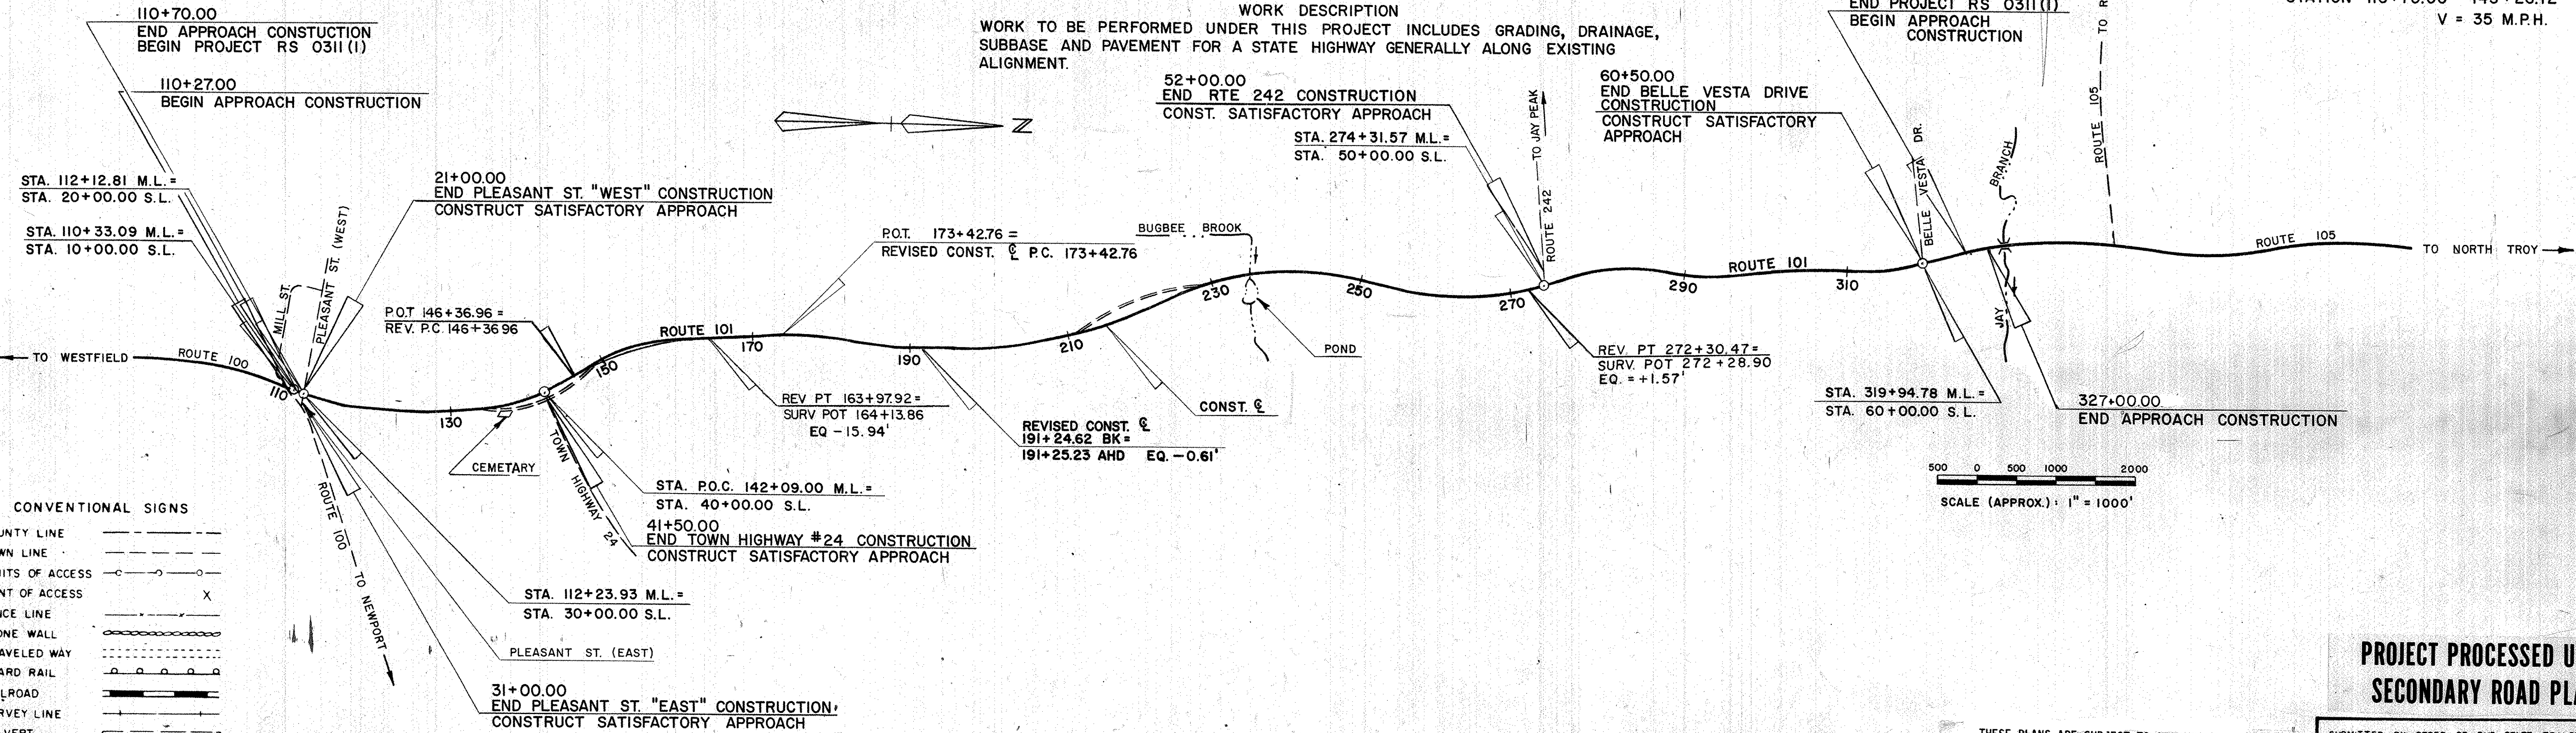

CONVENTIONAL SIGNS

COUNTY LINE	---
TOWN LINE	- - - -
LIMITS OF ACCESS	---X---
POINT OF ACCESS	X
FENCE LINE	---X---
STONE WALL	---X---
TRAVELED WAY	---X---
GUARD RAIL	---X---
RAILROAD	---X---
SURVEY LINE	---X---
CULVERT	---X---
POWER POLE	---X---
TELEPHONE POLE	---X---
TREES	---X---
CONTROL OF ACCESS	---X---
PROPERTY LINE	---X---
ROW TAKING LINE	---X---
SLOPE RIGHTS	---X---
TOP OF CUT	---X---
TOE OF SLOPE	---X---

DATUM NATIONAL GEODETIC
VERTICAL VERTICAL DATUM 1929
HORIZONTAL VT. STATE COORDINATE SYSTEM

PLANS PREPARED BY
WEBSTER-MARTIN, INC.
SOUTH BURLINGTON, VERMONT.
BY *Robert A. Slayton*



THESE PLANS ARE SUBJECT TO SUCH ENGINEERING CHANGES AS MAY BE REQUIRED BY THE FEDERAL HIGHWAY ADMINISTRATION OR THE AGENCY SECRETARY. CONSTRUCTION IS TO BE CARRIED ON IN ACCORDANCE WITH THESE PLANS AND THE STANDARD SPECIFICATIONS FOR CONSTRUCTION DATED 1986, AS APPROVED BY THE FEDERAL HIGHWAY ADMINISTRATION ON NOVEMBER 21, 1985 FOR USE ON THIS PROJECT, INCLUDING ALL SUBSEQUENT REVISIONS AND SUCH REVISED SPECIFICATIONS AND SPECIAL PROVISIONS AS ARE INCORPORATED IN THESE PLANS.

**PROJECT PROCESSED UNDER
SECONDARY ROAD PLAN**

SUBMITTED BY ORDER OF THE STATE TRANSPORTATION BOARD

APPROVED *Robert A. Slayton* DATE *10/21/90*
DIR. OF PLANNING AND PRECONSTRUCTION

DEPARTMENT OF TRANSPORTATION
FEDERAL HIGHWAY ADMINISTRATION

APPROVED _____ DATE _____
DIVISION ADMINISTRATOR

PROJECT *TROY* NO *RS 0311(1)*

SHEET 1 OF 229 SHEETS