


DATE
BY
SURVEYED
ADJUSTED
NOTE BOOK
NO. OF WY CHECKED

DATE
BY
SURVEYED
ADJUSTED
NOTE BOOK
NO. OF WY CHECKED

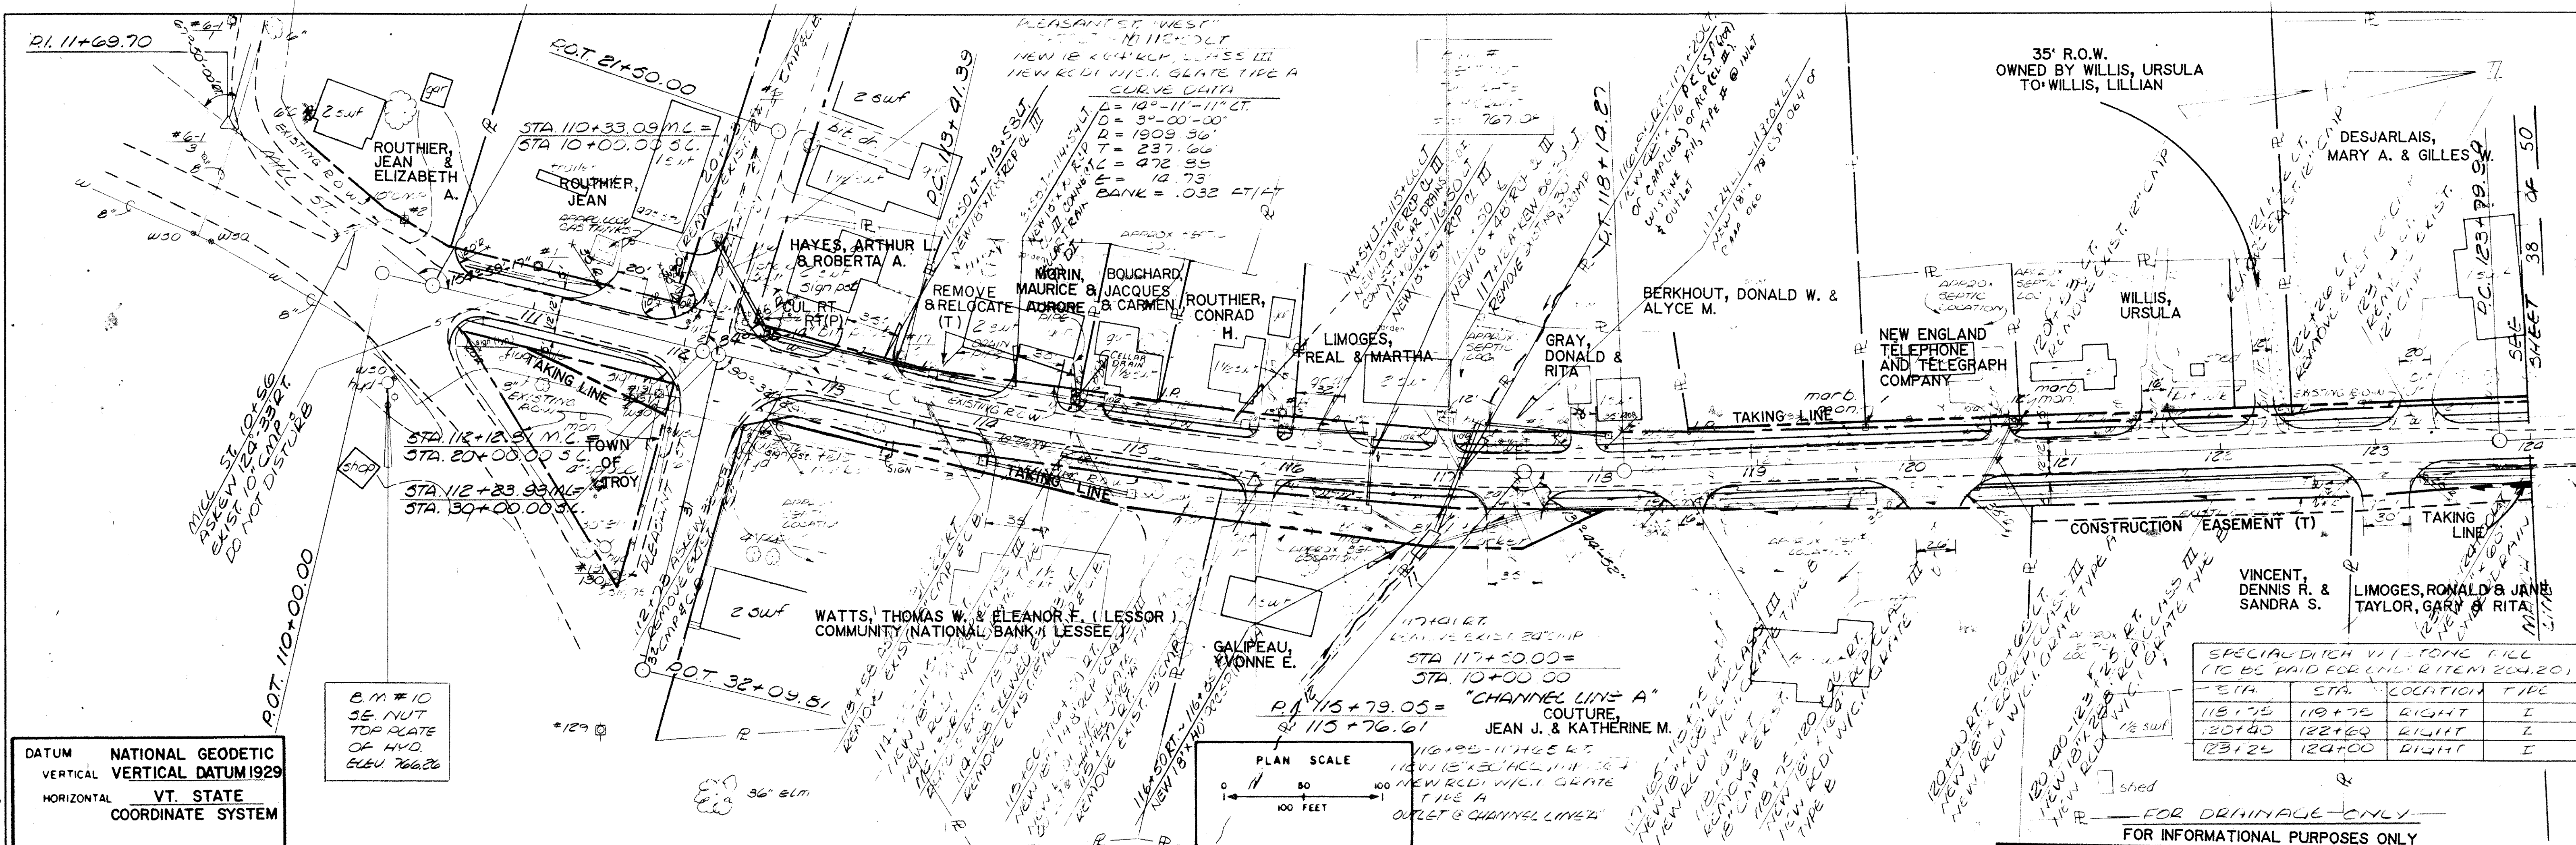

STA.	STA.	LOCATION	TYPE
115+75	119+75	RIGHT	E
120+40	122+60	RIGHT	L
123+25	124+00	RIGHT	E

THIS SHEET TO BE USED
FOR ROW INFORMATION ONLY

