

**CURVE DATA**

Δ = 12°-00'-56" LT  
 D = 1°-30'-00"  
 R = 3819.72'  
 T = 401.99'  
 L = 801.04'  
 E = 21.09'  
 BANK = .021 FT/FT.

**EROSION MATTING**

STA.	STA.	LOCATION
134+00	135+25	LEFT
135+65	136+50	LEFT

**CURVE DATA**

Δ = 22°-21'-51" LT  
 D = 3°-00'-00"  
 R = 1909.86'  
 T = 377.54'  
 C = 705.07'  
 E = 36.96'  
 BANK = .032 FT/FT.

**CONSTRUCT DRIVE**

STA.	LOCATION	TYPE	WIDTH
124+64	LEFT	GRAVEL	21 FT.
126+08	RIGHT	GRAVEL	18 FT.
127+84	RIGHT	GRAVEL	16 FT.
129+11	RIGHT	GRAVEL	22 FT.
130+38	RIGHT	GRAVEL	12 FT.

**SPECIAL DITCH WITH STONE FILL**  
 (TO BE PAID FOR UNDER ITEM 204.20)



STA.	STA.	LOCATION	TYPE
124+00	125+90	RIGHT	I
126+20	127+60	RIGHT	I
126+50	131+00	LEFT	I
128+00	128+90	RIGHT	I

**CONSTRUCT DRIVE**

STA.	LOCATION	TYPE	WIDTH
131+15	LEFT	PAVE	23 FT.
133+45	LEFT	GRAVEL	21 FT.
134+21	RIGHT	GRAVEL	35 FT.
135+50	LEFT	GRAVEL	19 FT.
136+83	LEFT	GRAVEL	25 FT.


DATUM NATIONAL GEODETIC VERTICAL DATUM 1929  
 HORIZONTAL VT. STATE COORDINATE SYSTEM

SAND BORROW DEPTH  
 126+50 - 131+00

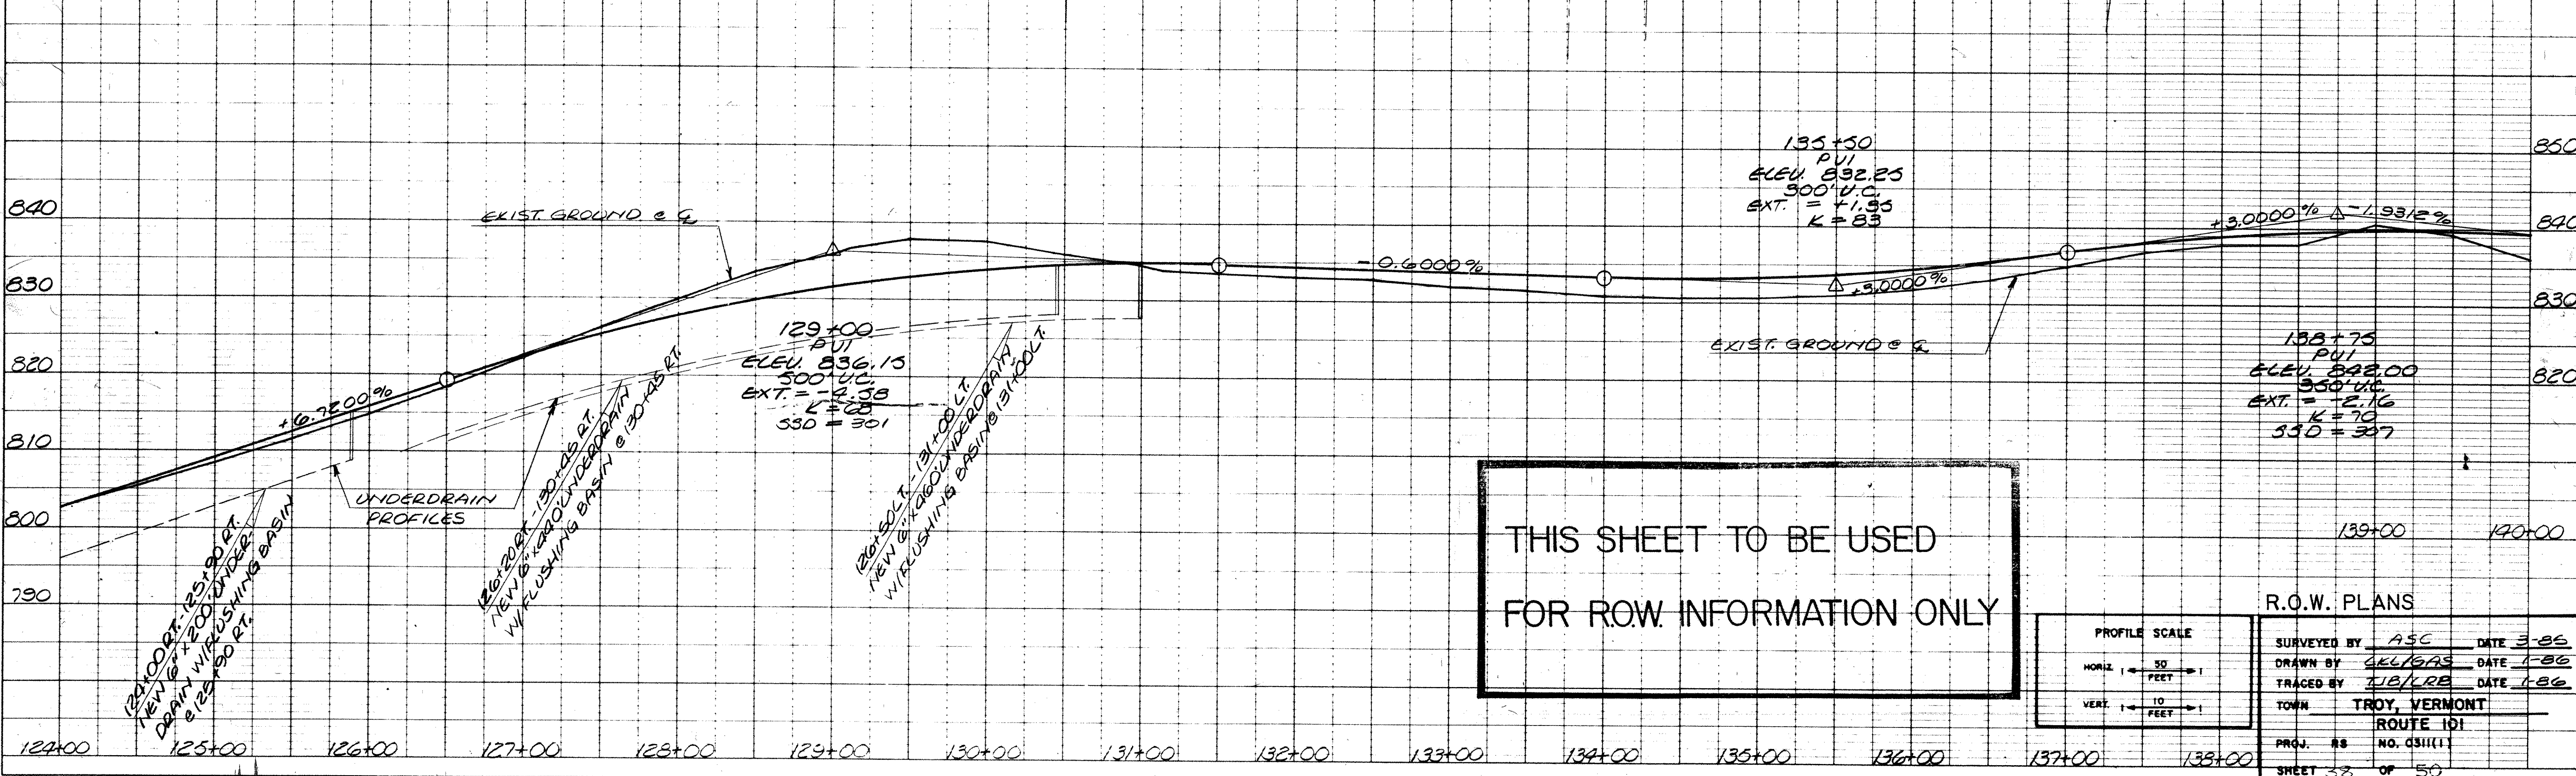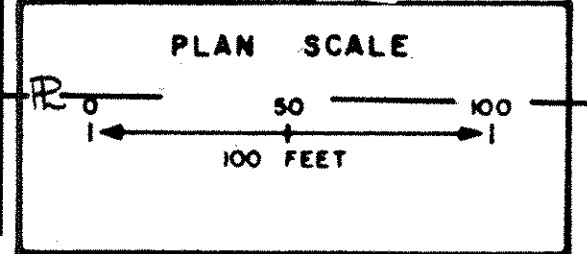

**THIS SHEET TO BE USED FOR R.O.W. INFORMATION ONLY**

R.O.W. PLANS

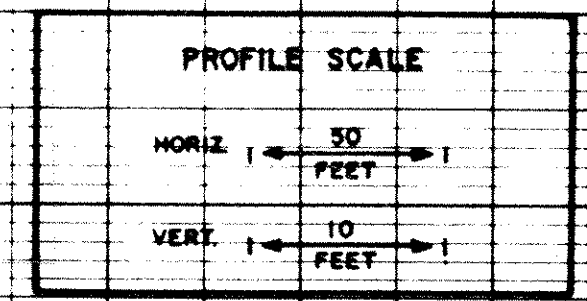

SURVEYED BY ASC DATE 3-88  
 DRAWN BY JEL/BAS DATE 1-88  
 TRACED BY J.B./RE DATE 1-88  
 TOWN TROY, VERMONT  
 ROUTE 101  
 PROJ. #8 NO. 0311(1)  
 SHEET 38 OF 50

**PLAN**  
 DATE: \_\_\_\_\_  
 BY: \_\_\_\_\_  
 CHECKED: \_\_\_\_\_  
 APPROVED: \_\_\_\_\_

**PROFILE**  
 DATE: \_\_\_\_\_  
 BY: \_\_\_\_\_  
 CHECKED: \_\_\_\_\_  
 APPROVED: \_\_\_\_\_