



CONSTRUCT DRIVE			
STA.	LOCATION	TYPE	WIDTH
159+36	LEFT	GRAVEL	12 FT.
160+92	LEFT	GRAVEL	16 FT.
170+31	LEFT	GRAVEL	16 FT.

TREATED TIMBER CURB		
STA.	STA.	LOCATION
163+85	172+00	RT.

EROSION MATTING		
STA.	STA.	LOCATION
171+25	172+00	LEFT


SPECIAL DITCH WITH STONE FILL (TO BE PAID FOR UNDER ITEM 204.20)			
STA.	STA.	LOCATION	TYPE
P.V. 1.840	REV. 159+20	LEFT	I
REV. 159+50	REV. 160+65	LEFT	I
REV. 161+12	REV. 163+84	LEFT	I
REV. 163+74	167+00	LEFT	I
167+10	170+15	LEFT	I
170+75	171+15	LEFT	I

DATE: _____
BY: _____
SHEET NO. _____
DATE: _____
BY: _____
SHEET NO. _____

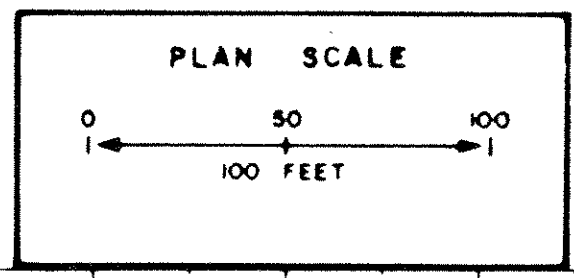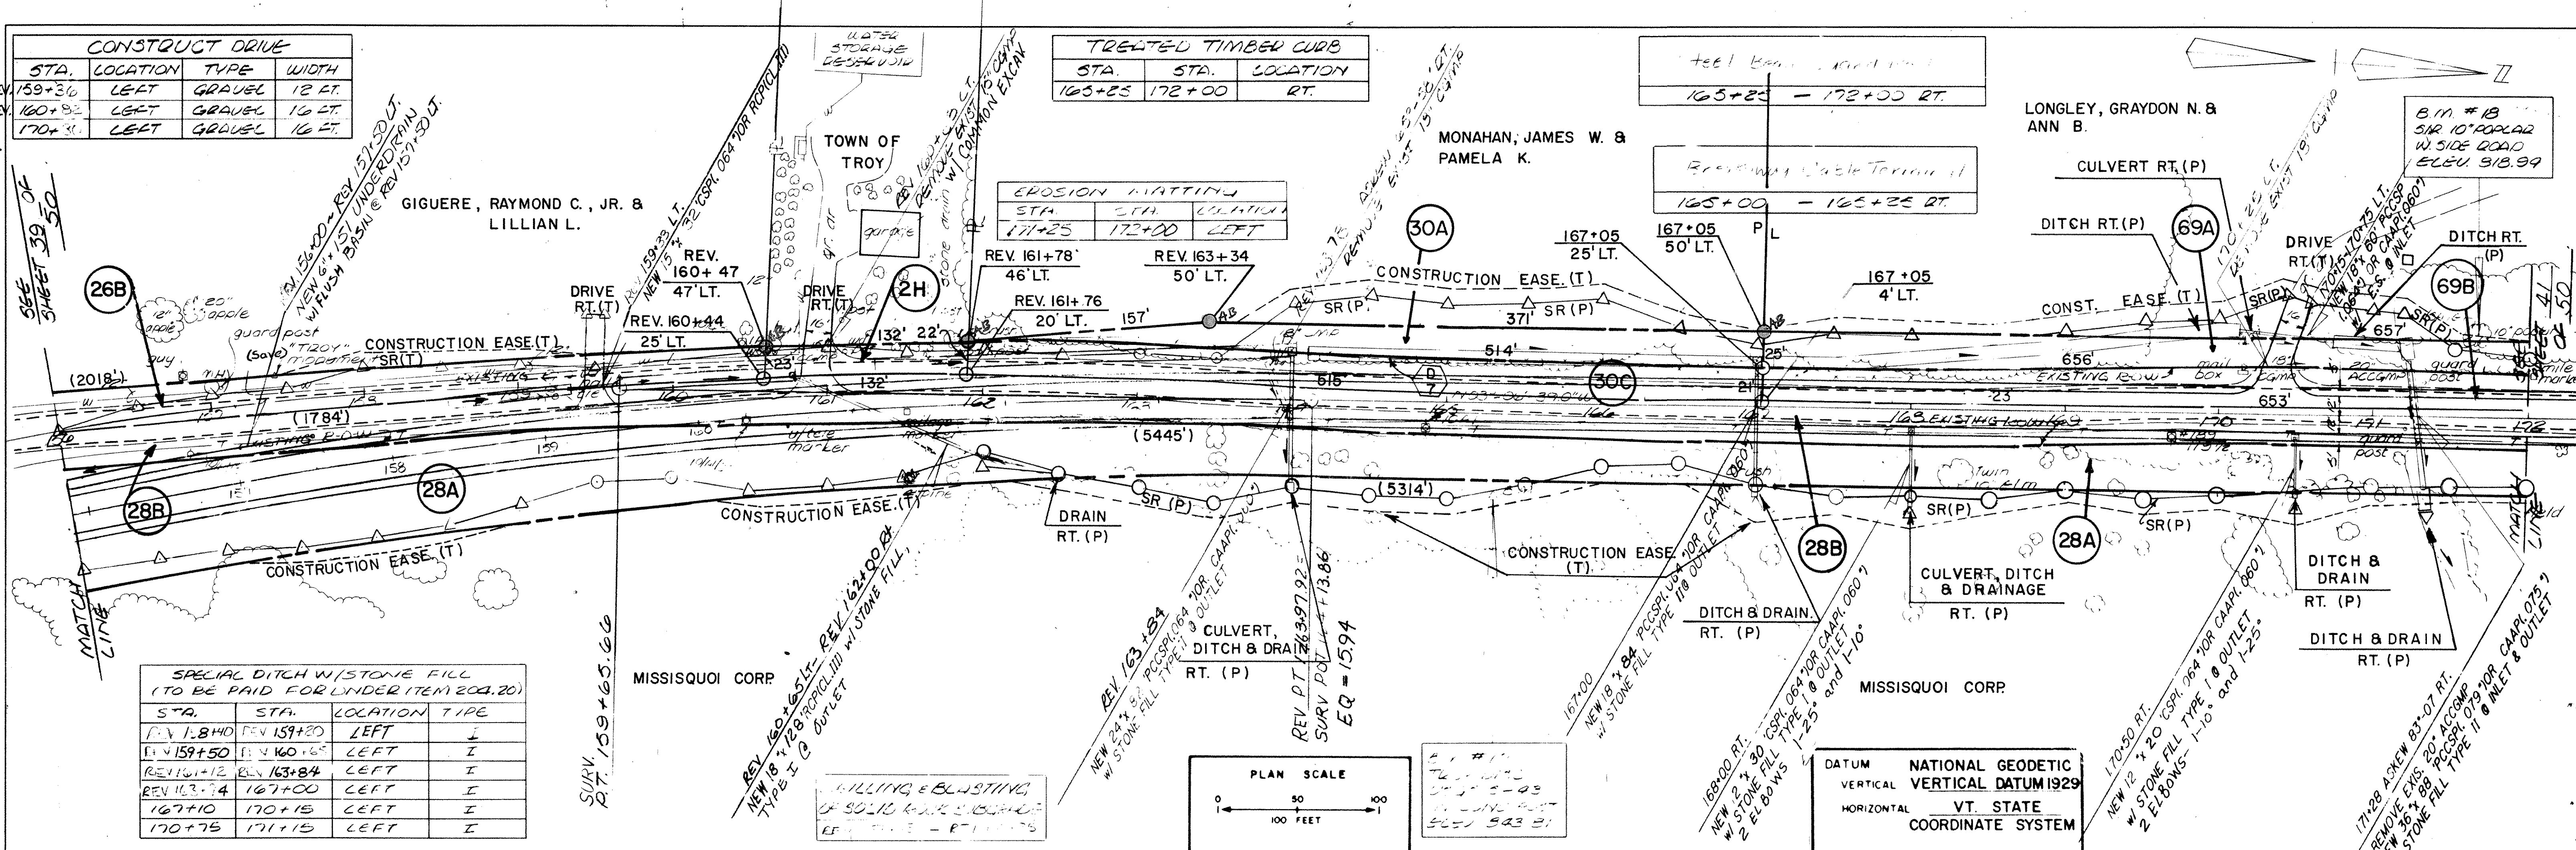


DATUM NATIONAL GEODETIC
VERTICAL VERTICAL DATUM 1929
HORIZONTAL VT. STATE
COORDINATE SYSTEM

**THIS SHEET TO BE USED
FOR ROW INFORMATION ONLY**

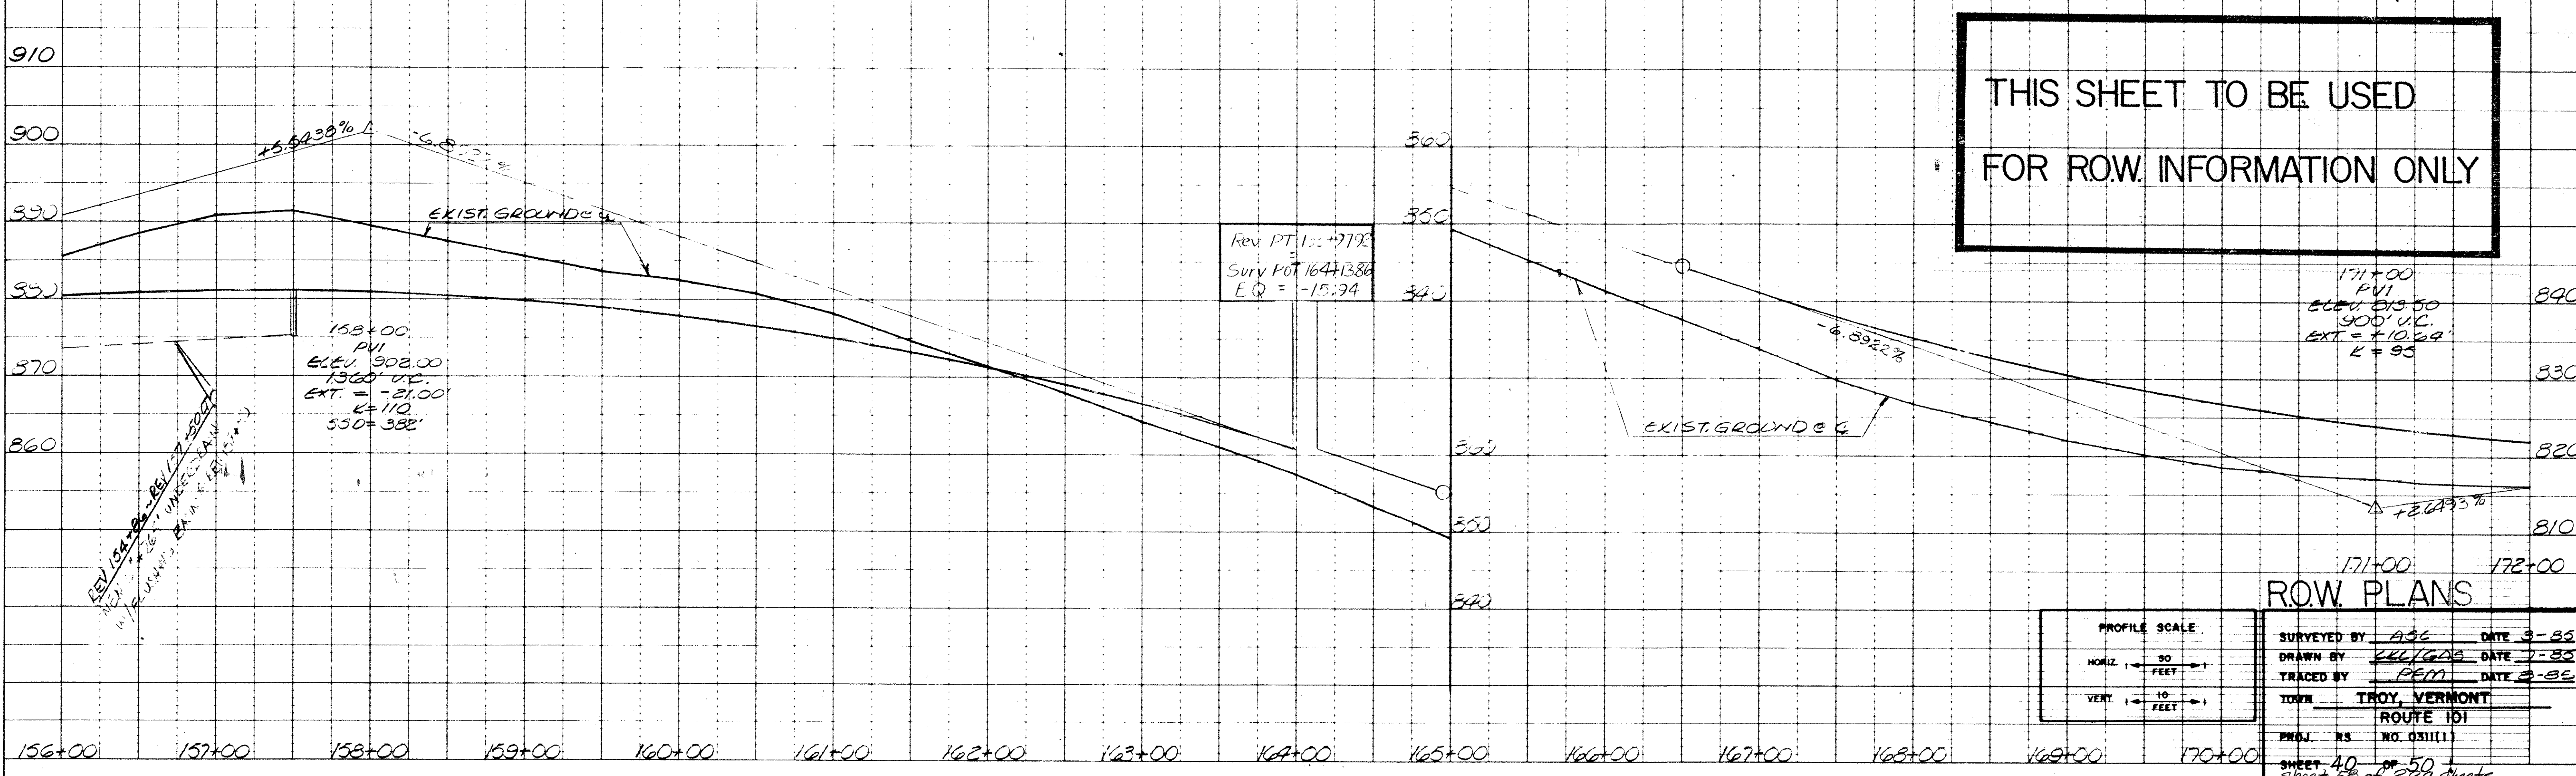

DATE: _____
BY: _____
SHEET NO. _____
DATE: _____
BY: _____
SHEET NO. _____

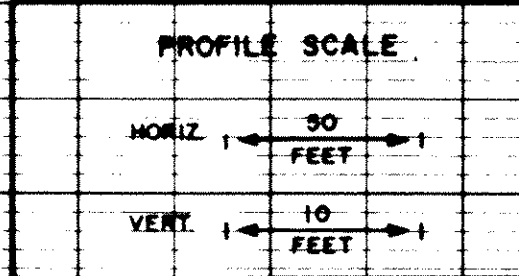

ROW PLANS

SURVEYED BY: ASC DATE: 3-85
 DRAWN BY: LL/KGS DATE: 7-85
 TRACED BY: PEM DATE: 2-85

TOWN: TROY, VERMONT
 ROUTE: 101

PROJ. NO. RS NO. 0311(1)
 SHEET 40 OF 50
 SHEET 38 OF 229 SHEETS