


DATE: _____ BY: _____
 SURVEYED: _____
 PLAN NOTE BOOK NO. _____
 CHECKED: _____
 BY: _____

DATE: _____ BY: _____
 SURVEYED: _____
 PROFILE NOTE BOOK NO. _____
 CHECKED: _____
 BY: _____

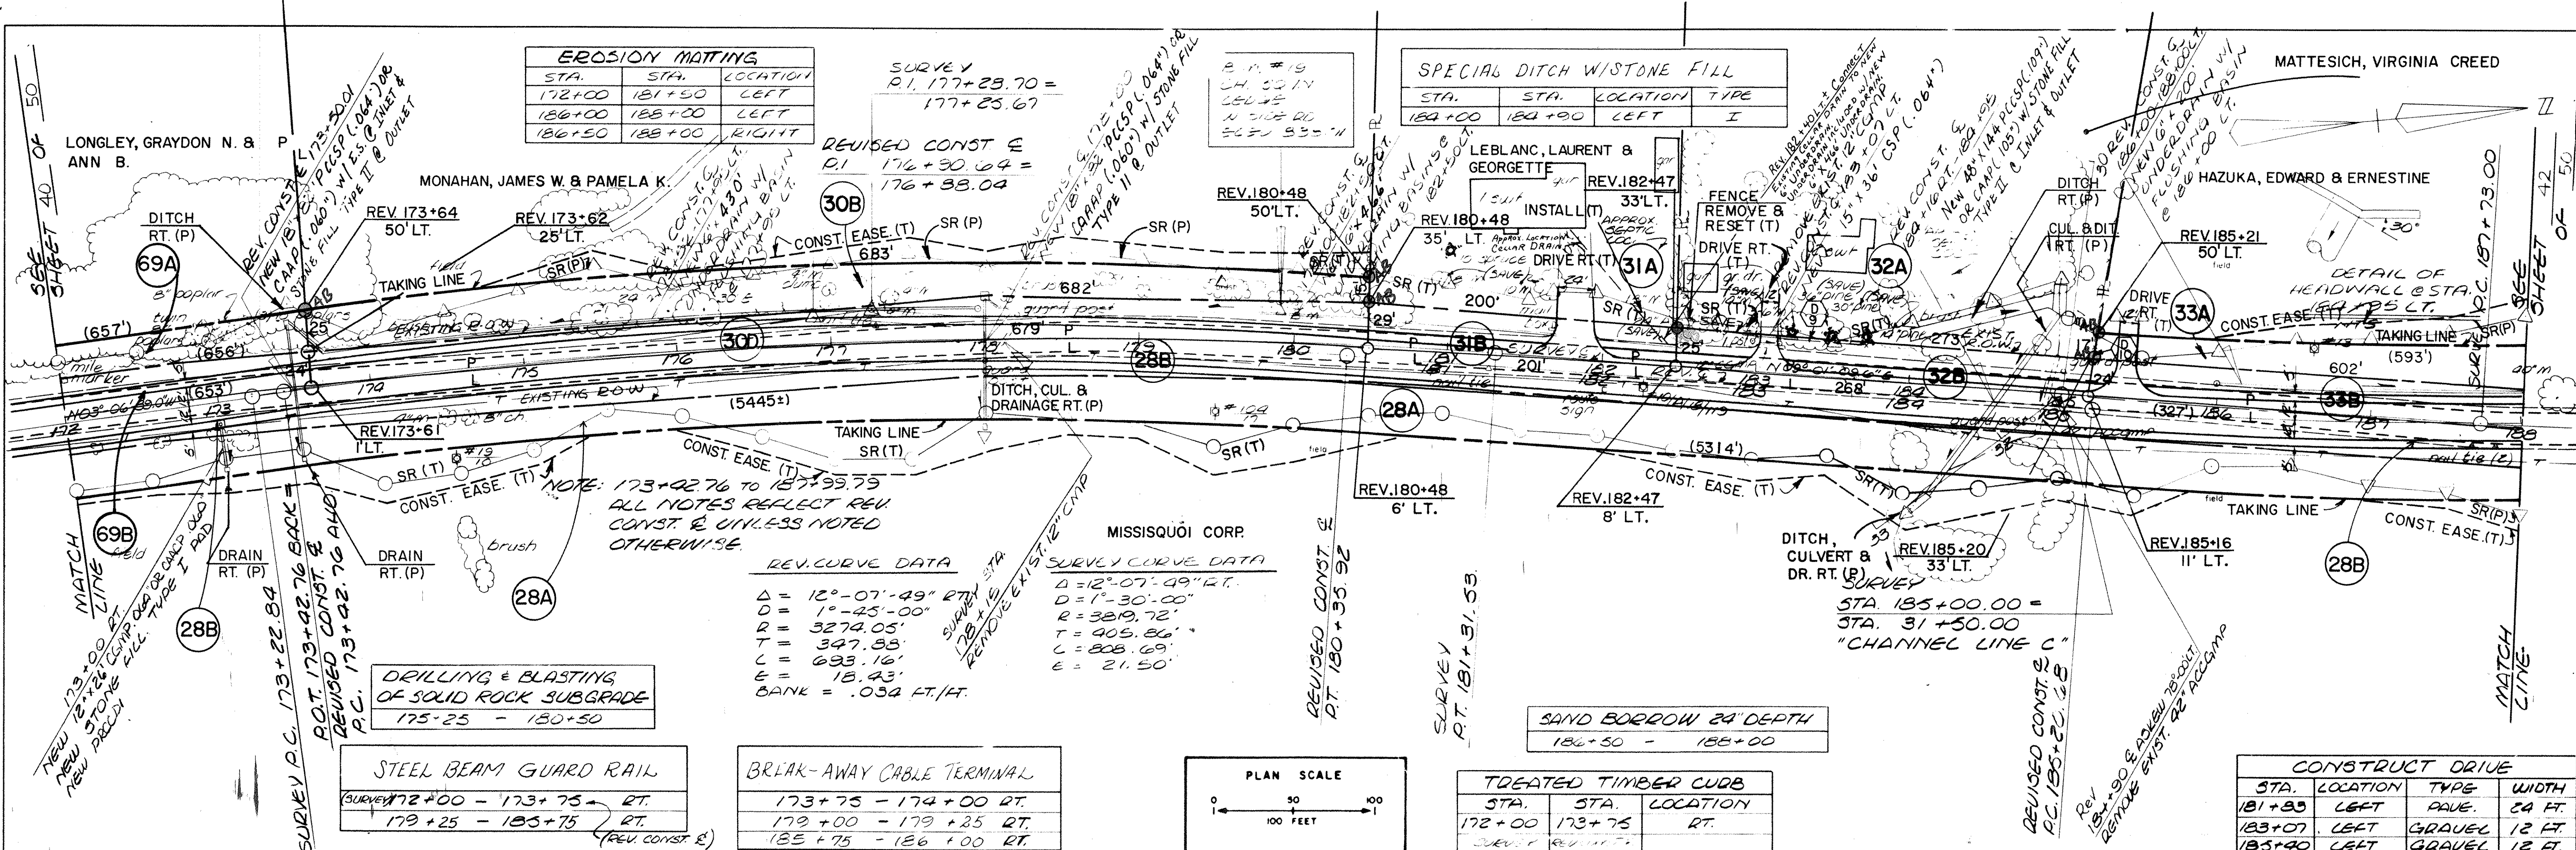

STA.	STA.	LOCATION
172+00	181+50	LEFT
186+00	185+00	LEFT
186+50	188+00	RIGHT


STA.	STA.	LOCATION	TYPE
184+00	184+90	LEFT	I

REV. CURVE DATA	SURVEY CURVE DATA
$\Delta = 12^{\circ}07'49''$ RT.	$\Delta = 12^{\circ}07'49''$ RT.
$D = 1^{\circ}25'00''$	$D = 1^{\circ}30'00''$
$R = 3274.05'$	$R = 3219.72'$
$T = 347.88'$	$T = 405.86'$
$L = 633.16'$	$L = 808.69'$
$E = 18.43'$	$E = 21.50'$
$BANK = .034$ FT./FT.	

DRILLING & BLASTING OF SOLID ROCK SUBGRADE
 175+25 - 180+50

STEEL BEAM GUARD RAIL
 SURVEY 172+00 - 173+75 RT.
 179+25 - 183+75 RT.
 (REV. CONST. E)

BRAK-AWAY CABLE TERMINAL
 173+75 - 174+00 RT.
 179+00 - 179+25 RT.
 185+75 - 186+00 RT.


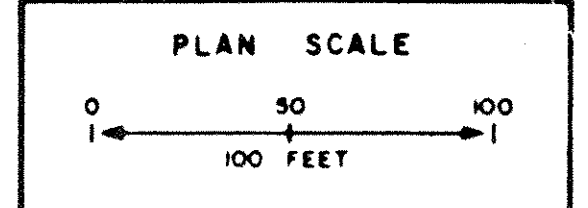


DATUM NATIONAL GEODETIC
 VERTICAL VERTICAL DATUM 1929
 HORIZONTAL VT. STATE COORDINATE SYSTEM

STA.	STA.	LOCATION
172+00	173+75	RT.

STA.	LOCATION	TYPE	WIDTH
181+35	LEFT	PAVE.	24 FT.
183+07	LEFT	GRAVEL	12 FT.
183+90	LEFT	GRAVEL	12 FT.

THIS SHEET TO BE USED FOR ROW INFORMATION ONLY

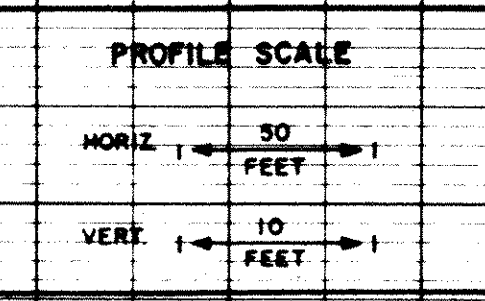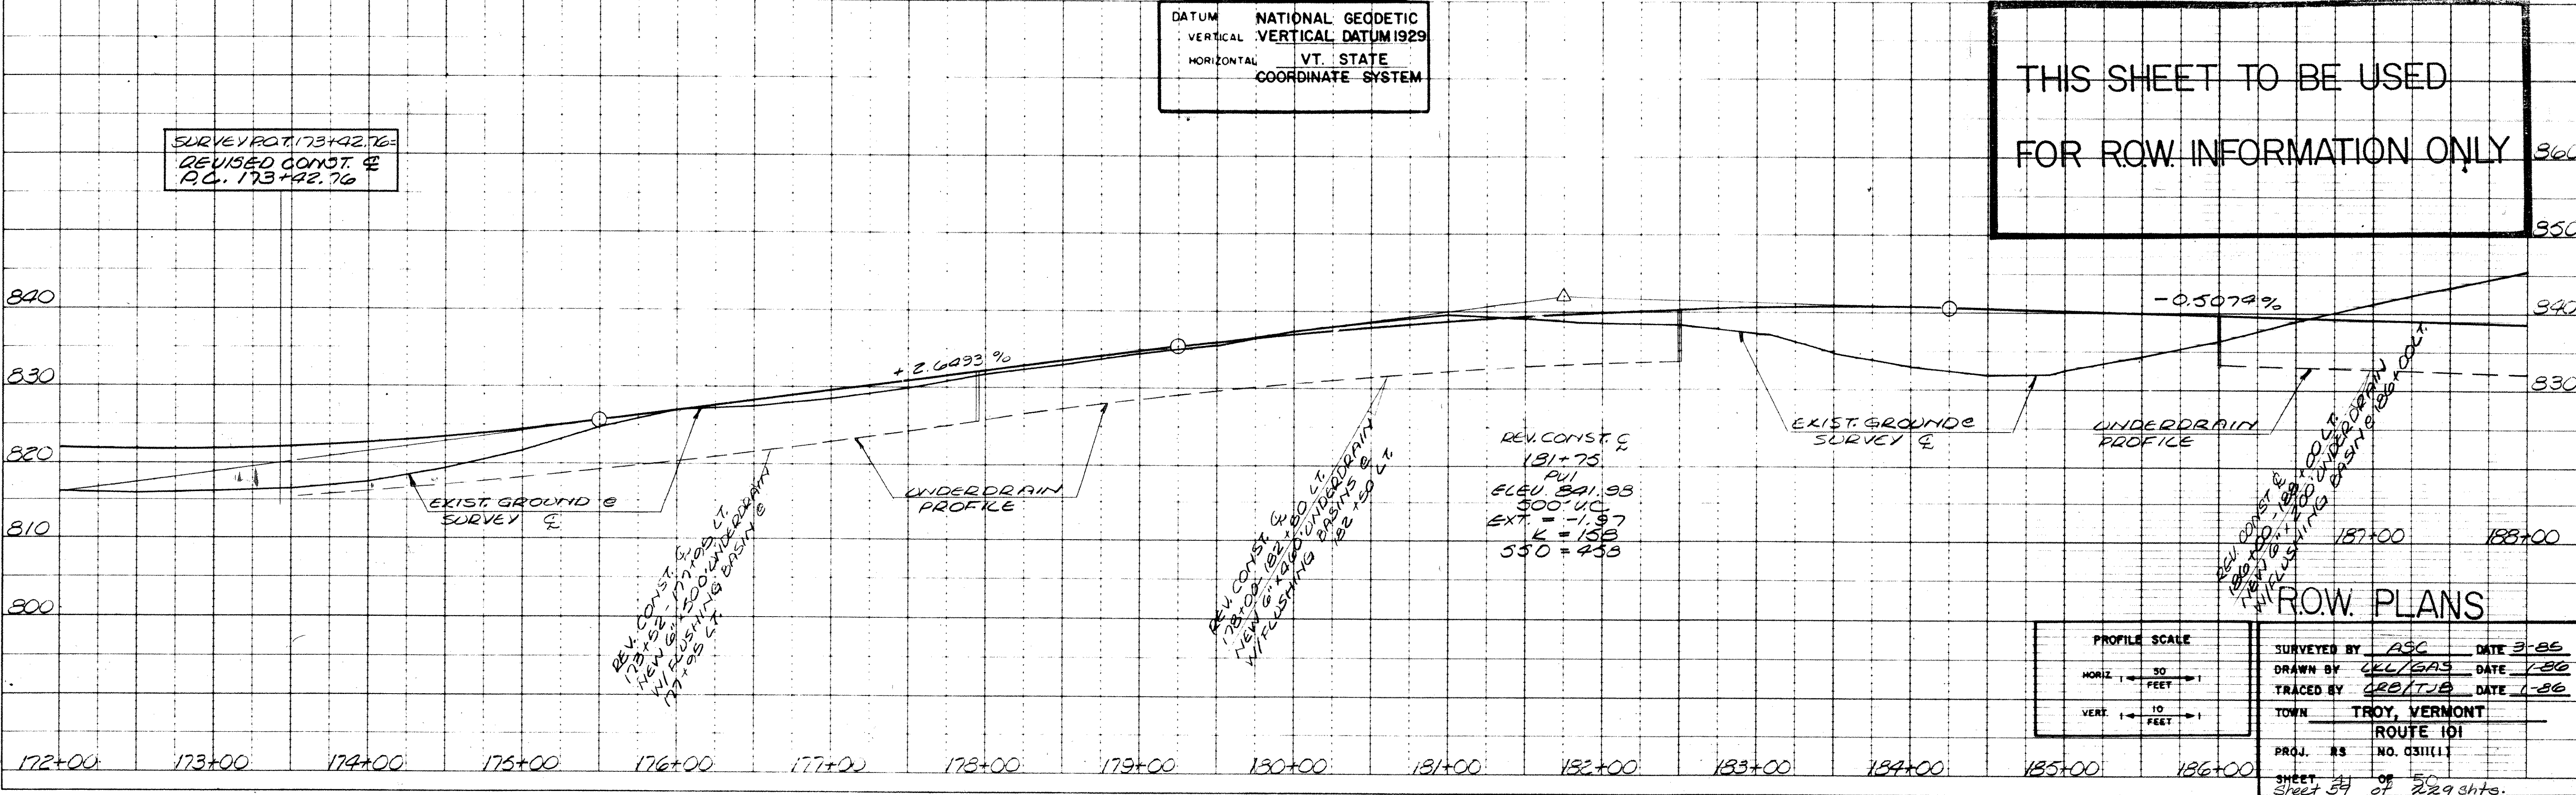

SURVEYED BY ASC DATE 3-86
 DRAWN BY KLL/BAJ DATE 7-86
 TRACED BY GBT/JB DATE 1-86
 TOWN TROY, VERMONT
 ROUTE 101
 PROJ. NO. CS11(1)
 SHEET 34 OF 229 SHTS.