

STA.	STA.	LOCATION
188+00	190+47	LEFT
188+00	191+35	RIGHT
201+00	204+00	LEFT
202+00	203+75	RIGHT

CURVE DATA	
$\Delta = 10^{\circ}-12'-03''$	CT.
$D = 10^{\circ}-30'-00''$	
$R = 3819.72'$	
$T = 475.80'$	
$L = 946.72'$	
$E = 29.52'$	
$BANK = 0.30$	FT/FT


SURVEY CURVE DATA	
$\Delta = 09^{\circ}-03'-33''$	CT.
$D = 9^{\circ}-30'-00''$	
$R = 1273.24'$	
$T = 100.57'$	
$L = 201.31'$	
$E = 3.99'$	

STA.	LOCATION	TYPE	WIDTH
190+05	LEFT	GRAVEL	16 FT.
191+55	RIGHT	GRAVEL	13 FT.
196+57	LEFT	GRAVEL	10 FT.
197+60	LEFT	GRAVEL	40 FT.
200+05	LEFT	GRAVEL	16 FT.
202+00	LEFT	GRAVEL	12 FT.



DRILLING & BLASTING OF SOLID ROCK SUBGRADE  
 196+75 - 197+75  
 200+75 - 201+25

SAND BORROW 2' DEPTH  
 185+00 - 191+00

DATUM NATIONAL GEODETIC  
 VERTICAL VERTICAL DATUM 1929  
 HORIZONTAL VT. STATE  
 COORDINATE SYSTEM

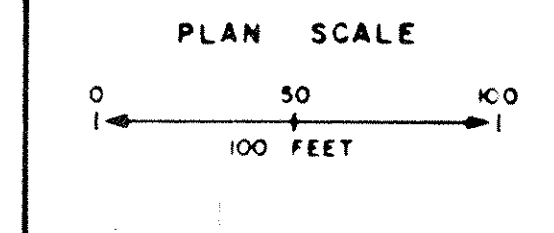

THIS SHEET TO BE USED FOR ROW INFORMATION ONLY

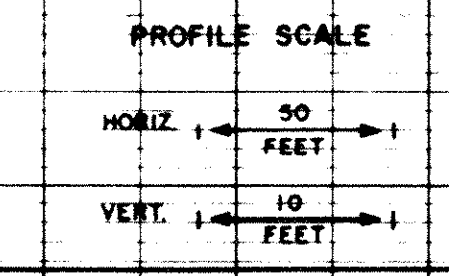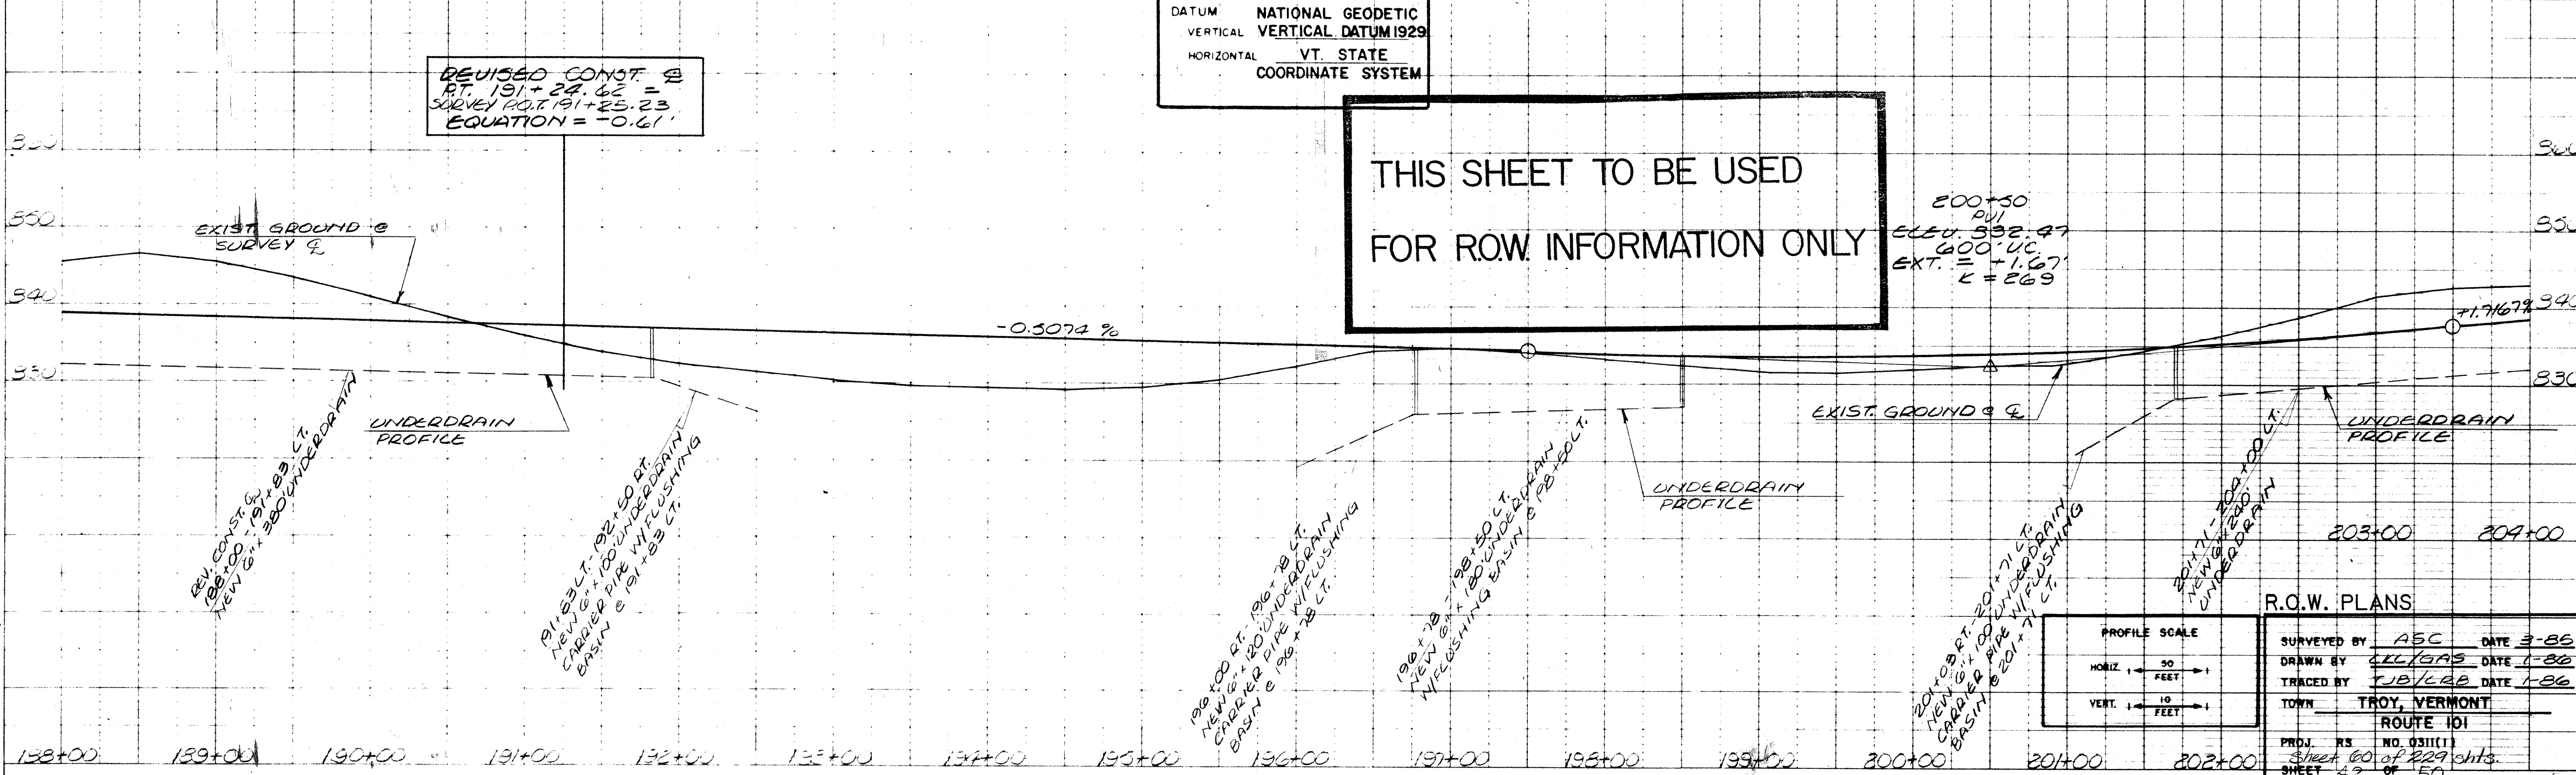

R.O.W. PLANS	
SURVEYED BY	ASC DATE 3-86
DRAWN BY	ELC/GMS DATE 1-86
TRACED BY	TJB/LEB DATE 1-86
TOWN	TROY, VERMONT
ROUTE	ROUTE 101
PROJ. NO.	NO. 0311(1)
SHEET	Sheet 60 of 229 sheets
	42 OF 50