


DATE	
BY	
NO.	
PLANNING	
DESIGN	
CONSTRUCTION	
OPERATION	
MAINTENANCE	
REVISIONS	
DATE	
BY	
NO.	
PLANNING	
DESIGN	
CONSTRUCTION	
OPERATION	
MAINTENANCE	
REVISIONS	

DATE	
BY	
NO.	
PLANNING	
DESIGN	
CONSTRUCTION	
OPERATION	
MAINTENANCE	
REVISIONS	
DATE	
BY	
NO.	
PLANNING	
DESIGN	
CONSTRUCTION	
OPERATION	
MAINTENANCE	
REVISIONS	

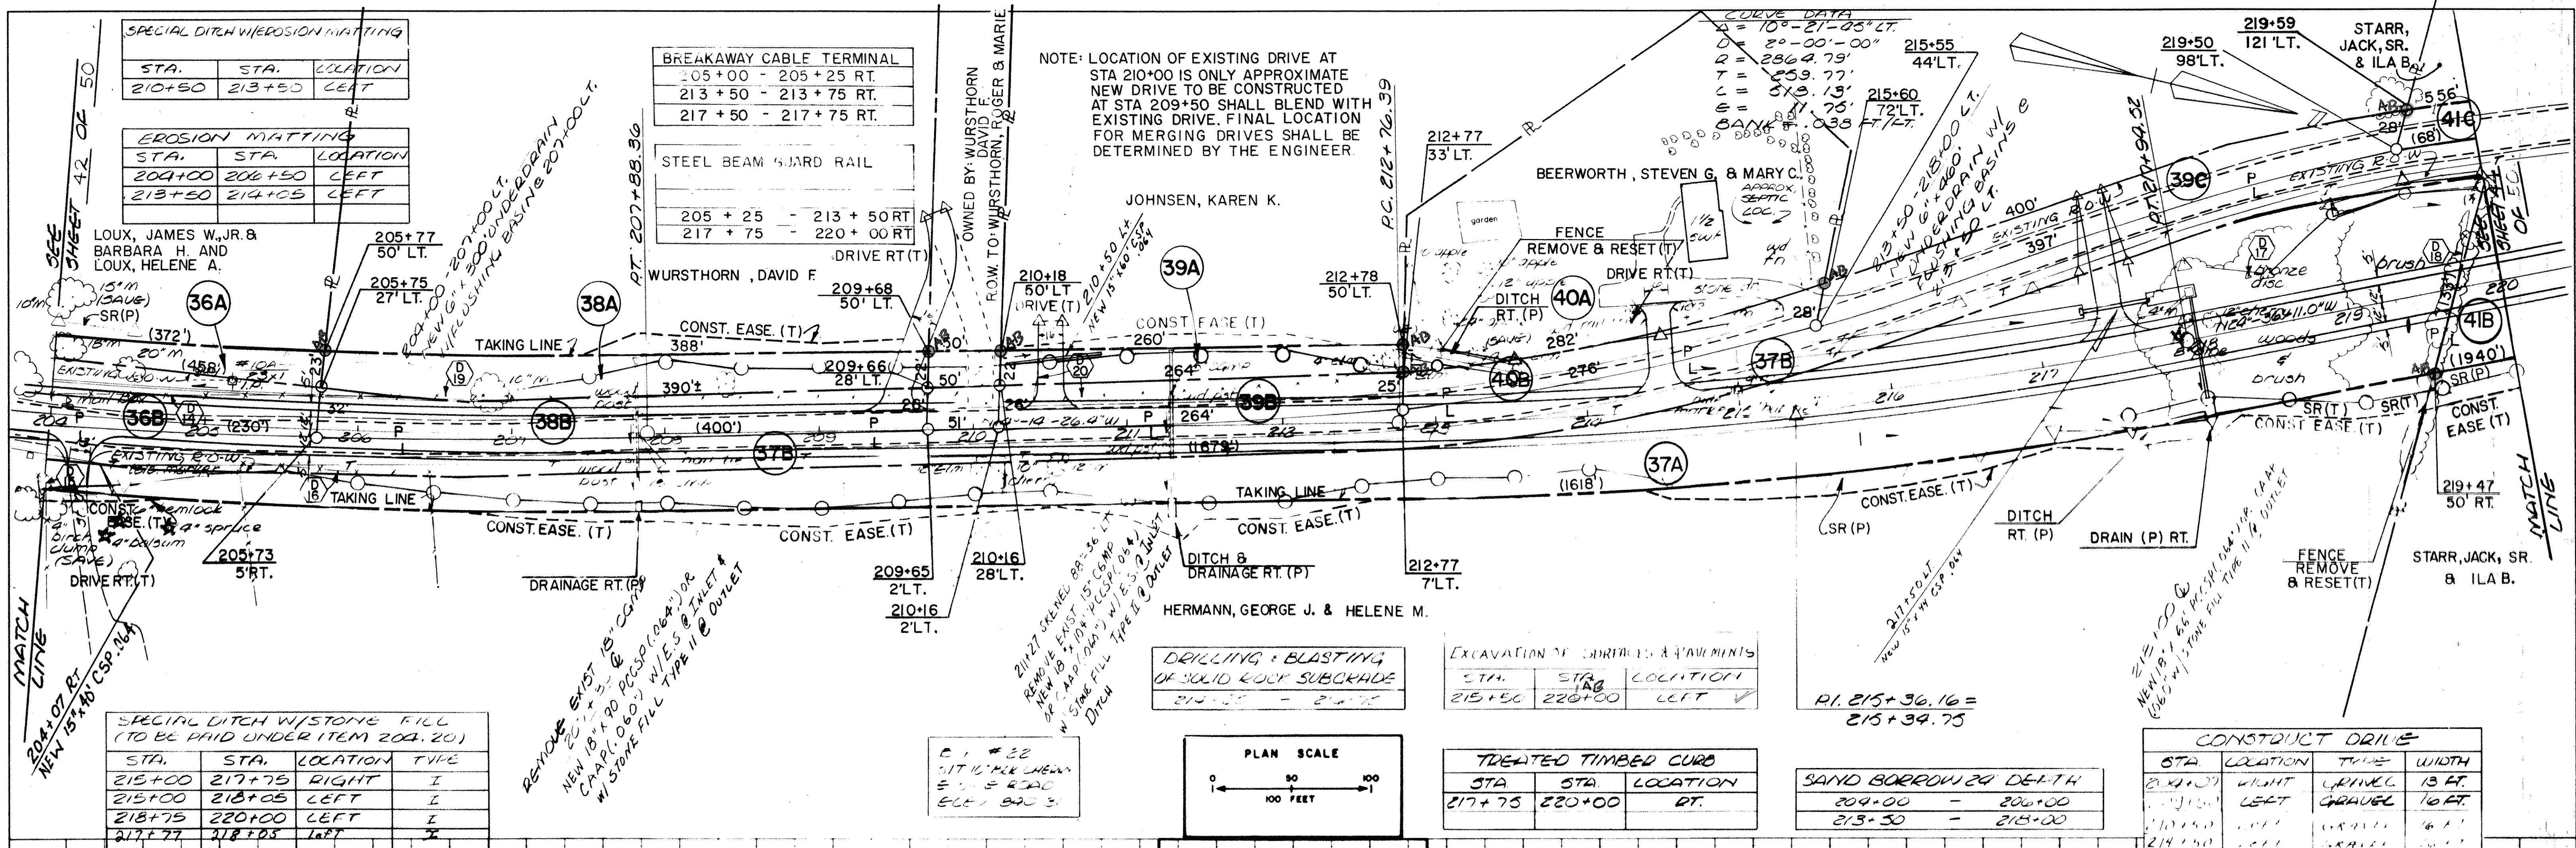

SPECIAL DITCH W/STONE FILL (TO BE PAID UNDER ITEM 204.20)

STA.	STA.	LOCATION	TYPE
215+00	217+75	RIGHT	I
215+00	218+05	LEFT	I
218+75	220+00	LEFT	I
217+77	218+05	LEFT	I

BREAKAWAY CABLE TERMINAL

05+00 - 205+25 RT.
213+50 - 213+75 RT.
217+50 - 217+75 RT.

STEEL BEAM GUARD RAIL

205+25 - 213+50 RT.
217+75 - 220+00 RT.

DRILLING & BLASTING OF SOLID ROCK SUBGRADE

STA.	STA.	LOCATION
215+50	220+00	LEFT

TREATED TIMBER CURB


STA.	STA.	LOCATION
217+75	220+00	RT.

SAND BORROW 24' DEPTH


209+00 - 209+00
215+50 - 215+00

CONSTRUCT DRIVE

STA.	LOCATION	TYPE	WIDTH
215+00	RIGHT	GRAVEL	13 FT
215+00	LEFT	GRAVEL	16 FT
218+50	LEFT	GRAVEL	16 FT
219+50	LEFT	GRAVEL	16 FT

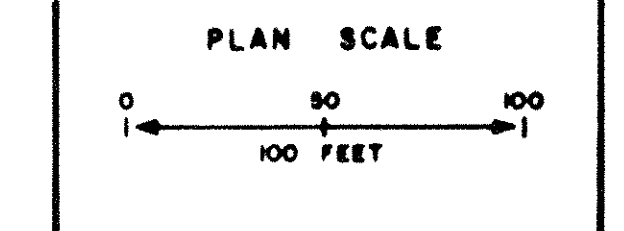

DATUM NATIONAL GEODETIC  
VERTICAL VERTICAL DATUM 1929  
HORIZONTAL VT. STATE COORDINATE SYSTEM

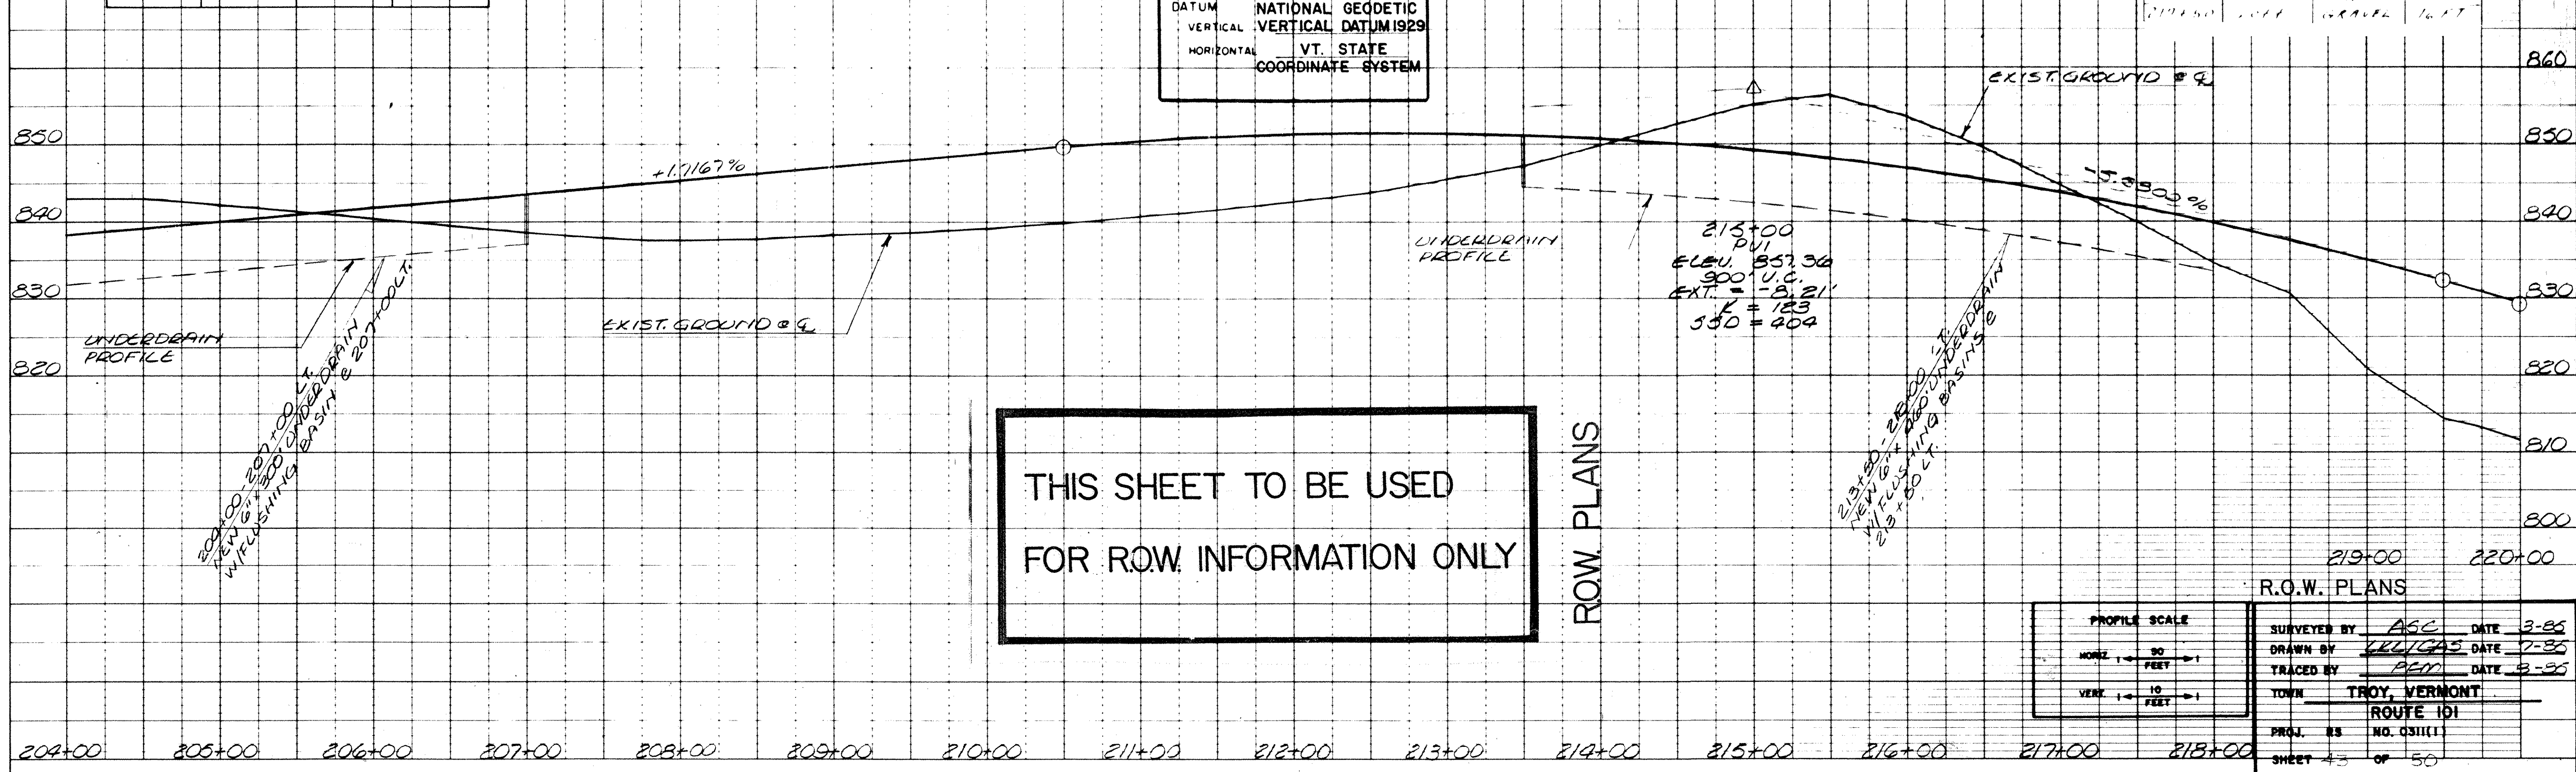

PROFILE SCALE

HORIZ	50 FEET
VERT	10 FEET

R.O.W. PLANS

SURVEYED BY	ASC	DATE	3-86
DRAWN BY	LLIGAS	DATE	7-86
TRACED BY	REN	DATE	3-86
TOWN	TROY, VERMONT		
PROJECT NO.	NO. 0311(1)		
SHEET	43	OF	50