


DATE: _____
 BY: _____
 SURVEYED: _____
 PLOTTED: _____
 NOTE BOOK NO. _____
 CHECKED: _____
 AT OF ANY CHECKED: _____


DATE: _____
 BY: _____
 SURVEYED: _____
 PLOTTED: _____
 NOTE BOOK NO. _____
 CHECKED: _____
 AT OF ANY CHECKED: _____

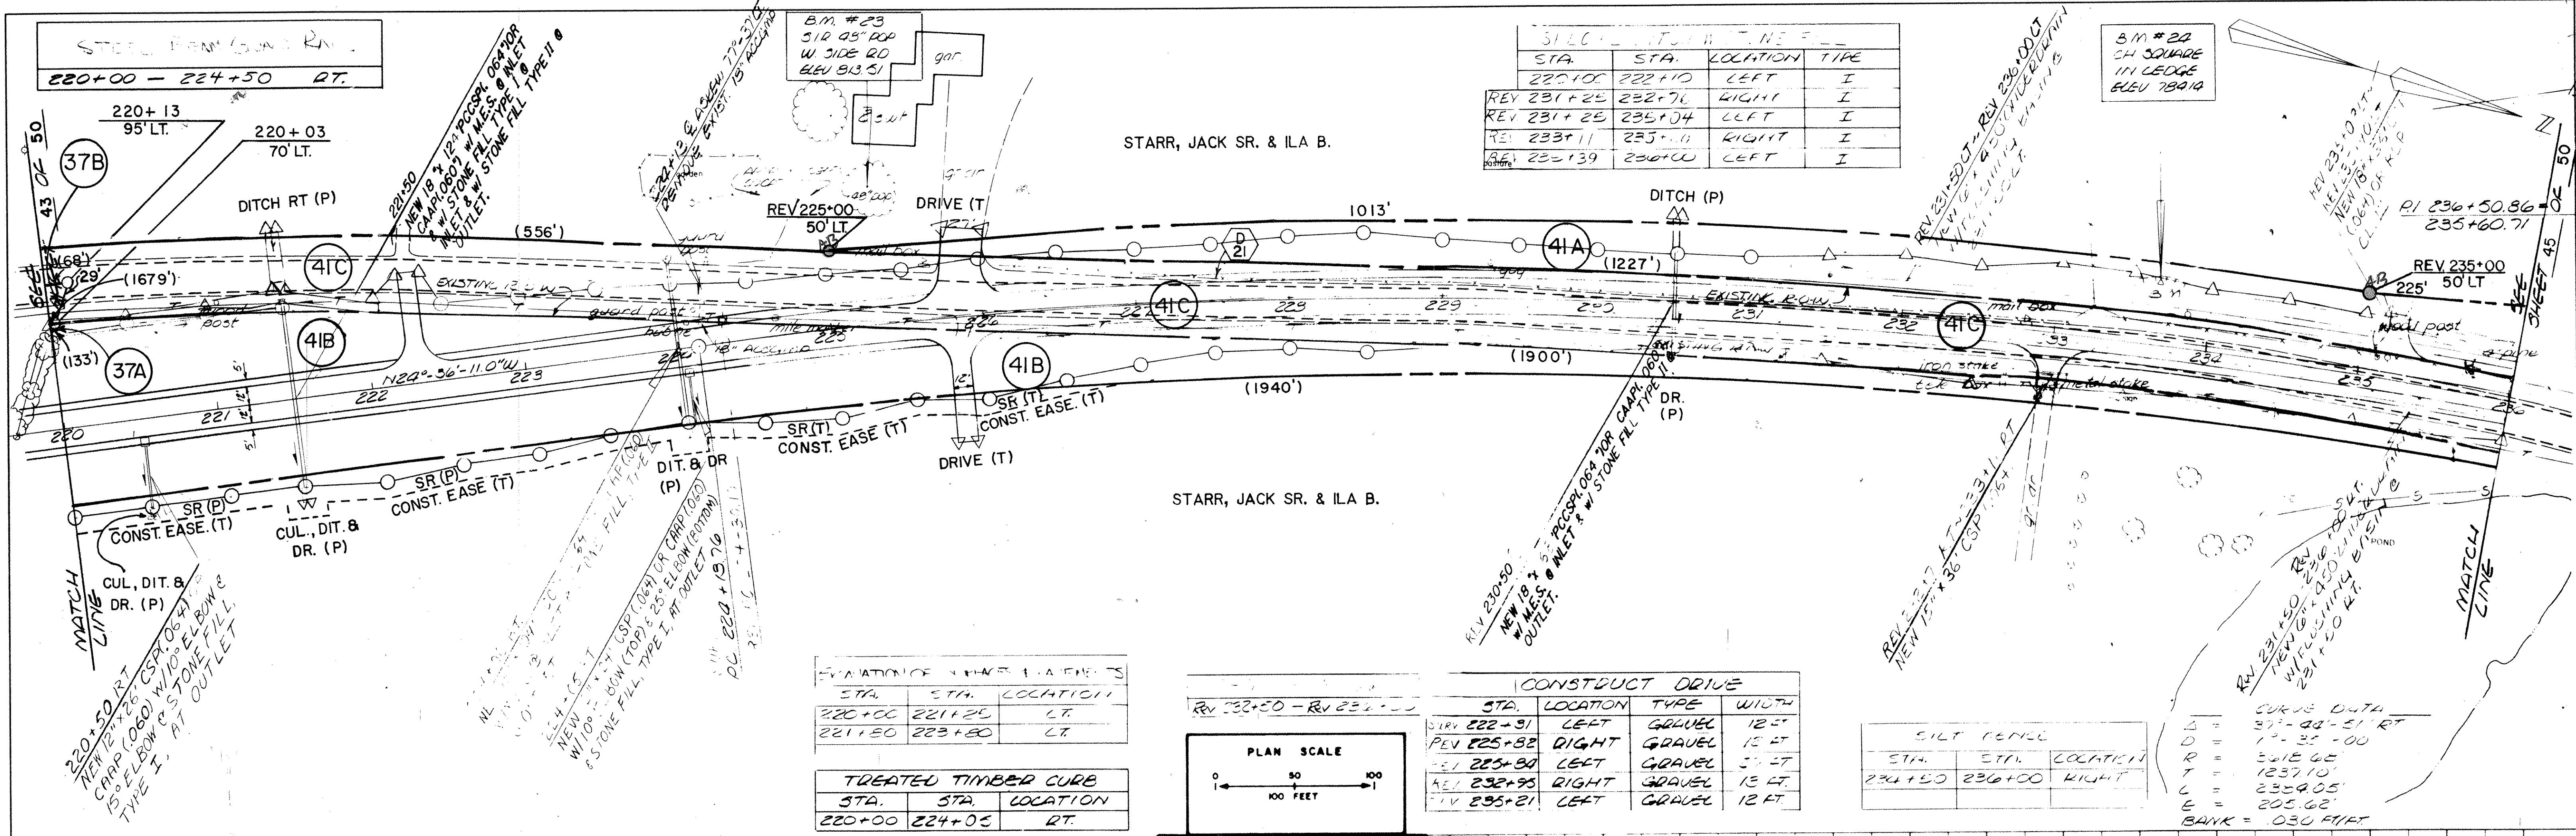

STA.	STA.	LOCATION	TYPE
222+10	222+10	LEFT	I
REV 231+25	232+70	RIGHT	I
REV 231+25	235+04	LEFT	I
REV 233+11	235+11	RIGHT	I
REV 235+139	236+00	LEFT	I

STA.	STA.	LOCATION
220+00	221+25	LT.
221+50	223+50	LT.

STA.	STA.	LOCATION
220+00	224+05	RT.

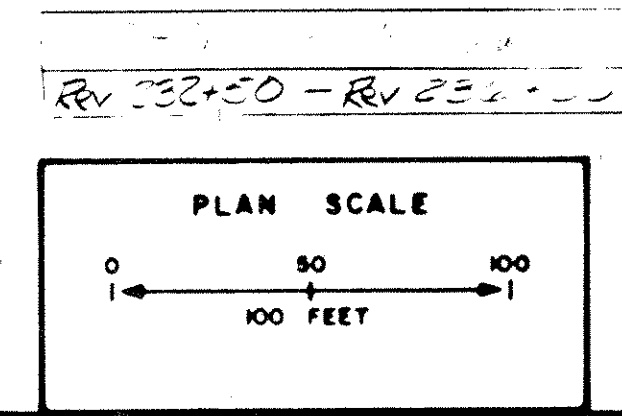


STA.	LOCATION	TYPE	WIDTH
REV 222+31	RIGHT	GRAVEL	12 FT
REV 225+32	RIGHT	GRAVEL	15 FT
REV 225+34	LEFT	GRAVEL	5 FT
REV 228+35	RIGHT	GRAVEL	15 FT
REV 235+21	LEFT	GRAVEL	12 FT

STA.	STA.	LOCATION
234+50	236+00	RIGHT

DATUM: NATIONAL GEODETIC
 VERTICAL: VERTICAL DATUM 1929
 HORIZONTAL: VT. STATE COORDINATE SYSTEM

THIS SHEET TO BE USED FOR ROW INFORMATION ONLY

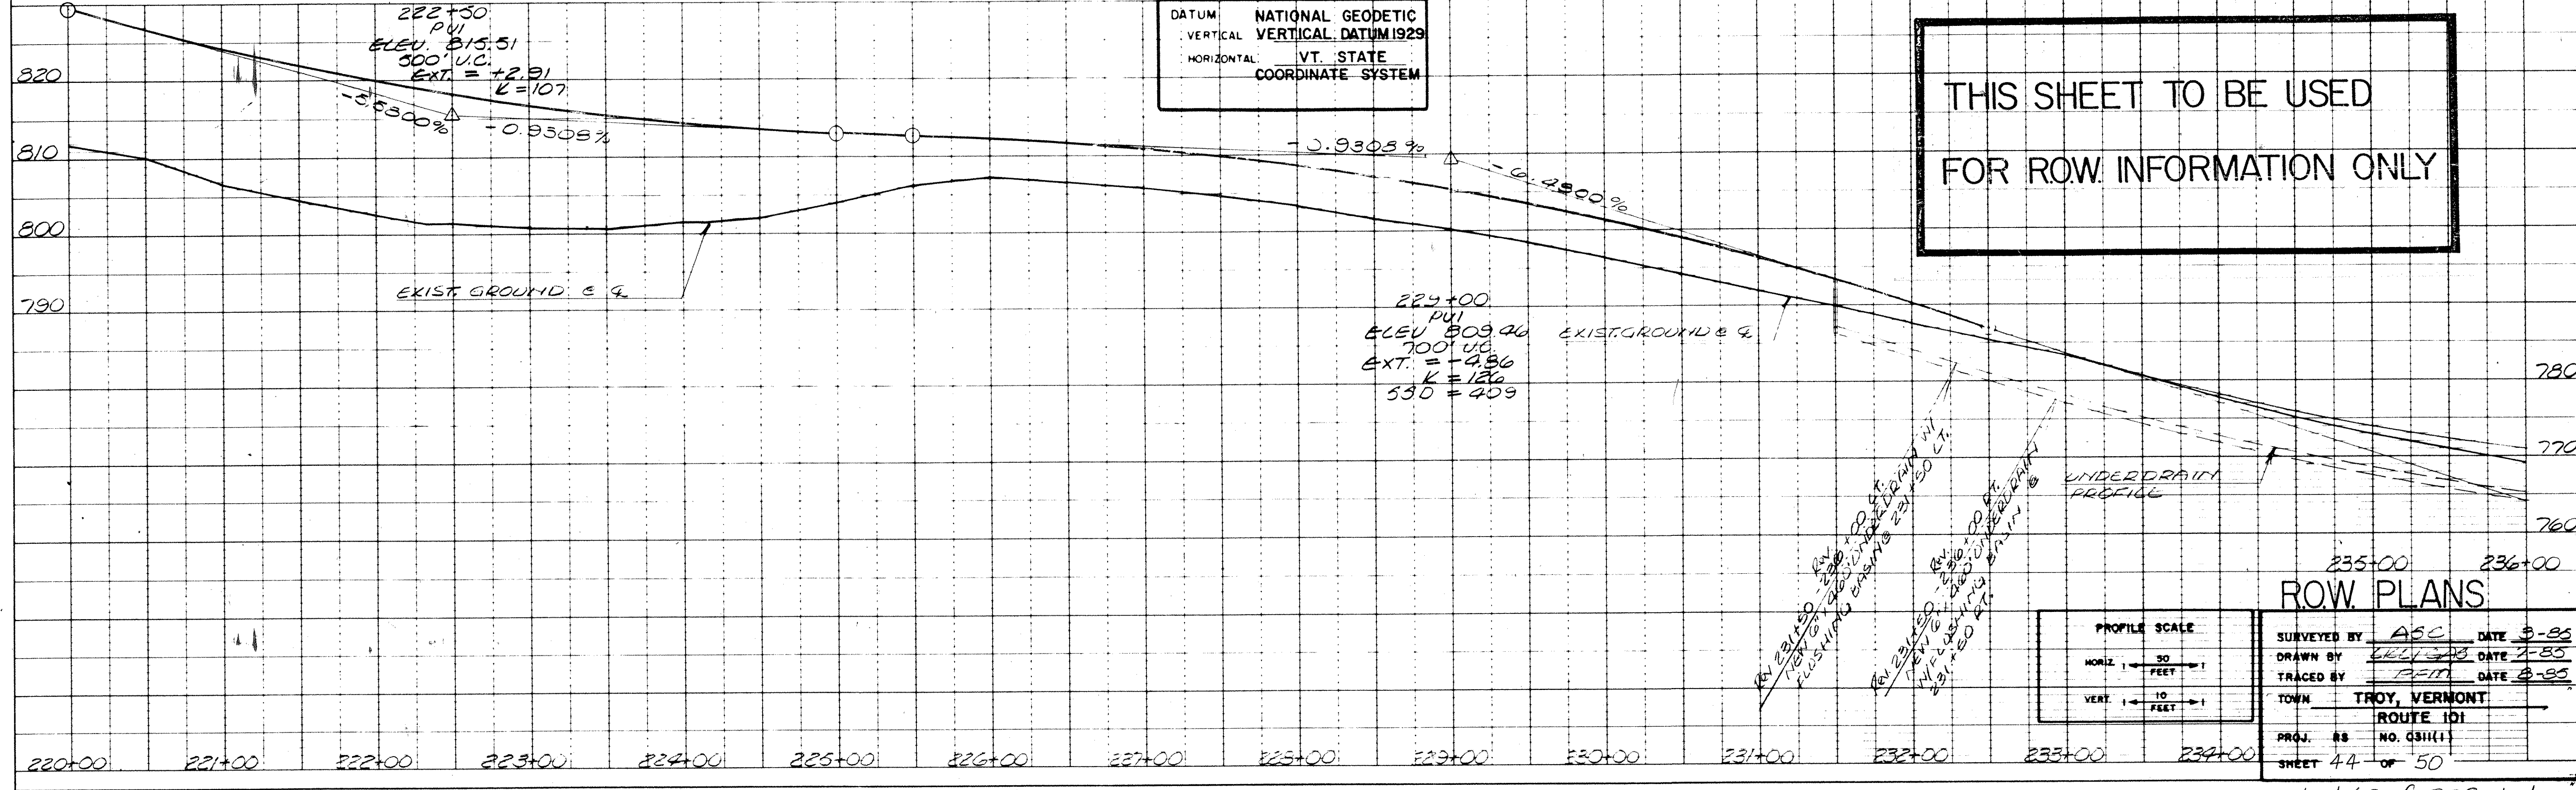

ROW PLANS

SURVEYED BY: ASC DATE: 3-85
 DRAWN BY: DATE: 7-85
 TRACED BY: DATE: 3-85
 TOWN: TROY, VERMONT
 PROJ. NO. 88 NO. 0311(1)
 SHEET 44 OF 50

