


DATE	
BY	
REVISIONS	
NO.	
DATE	
BY	
REVISIONS	
NO.	

DATE	
BY	
REVISIONS	
NO.	
DATE	
BY	
REVISIONS	
NO.	

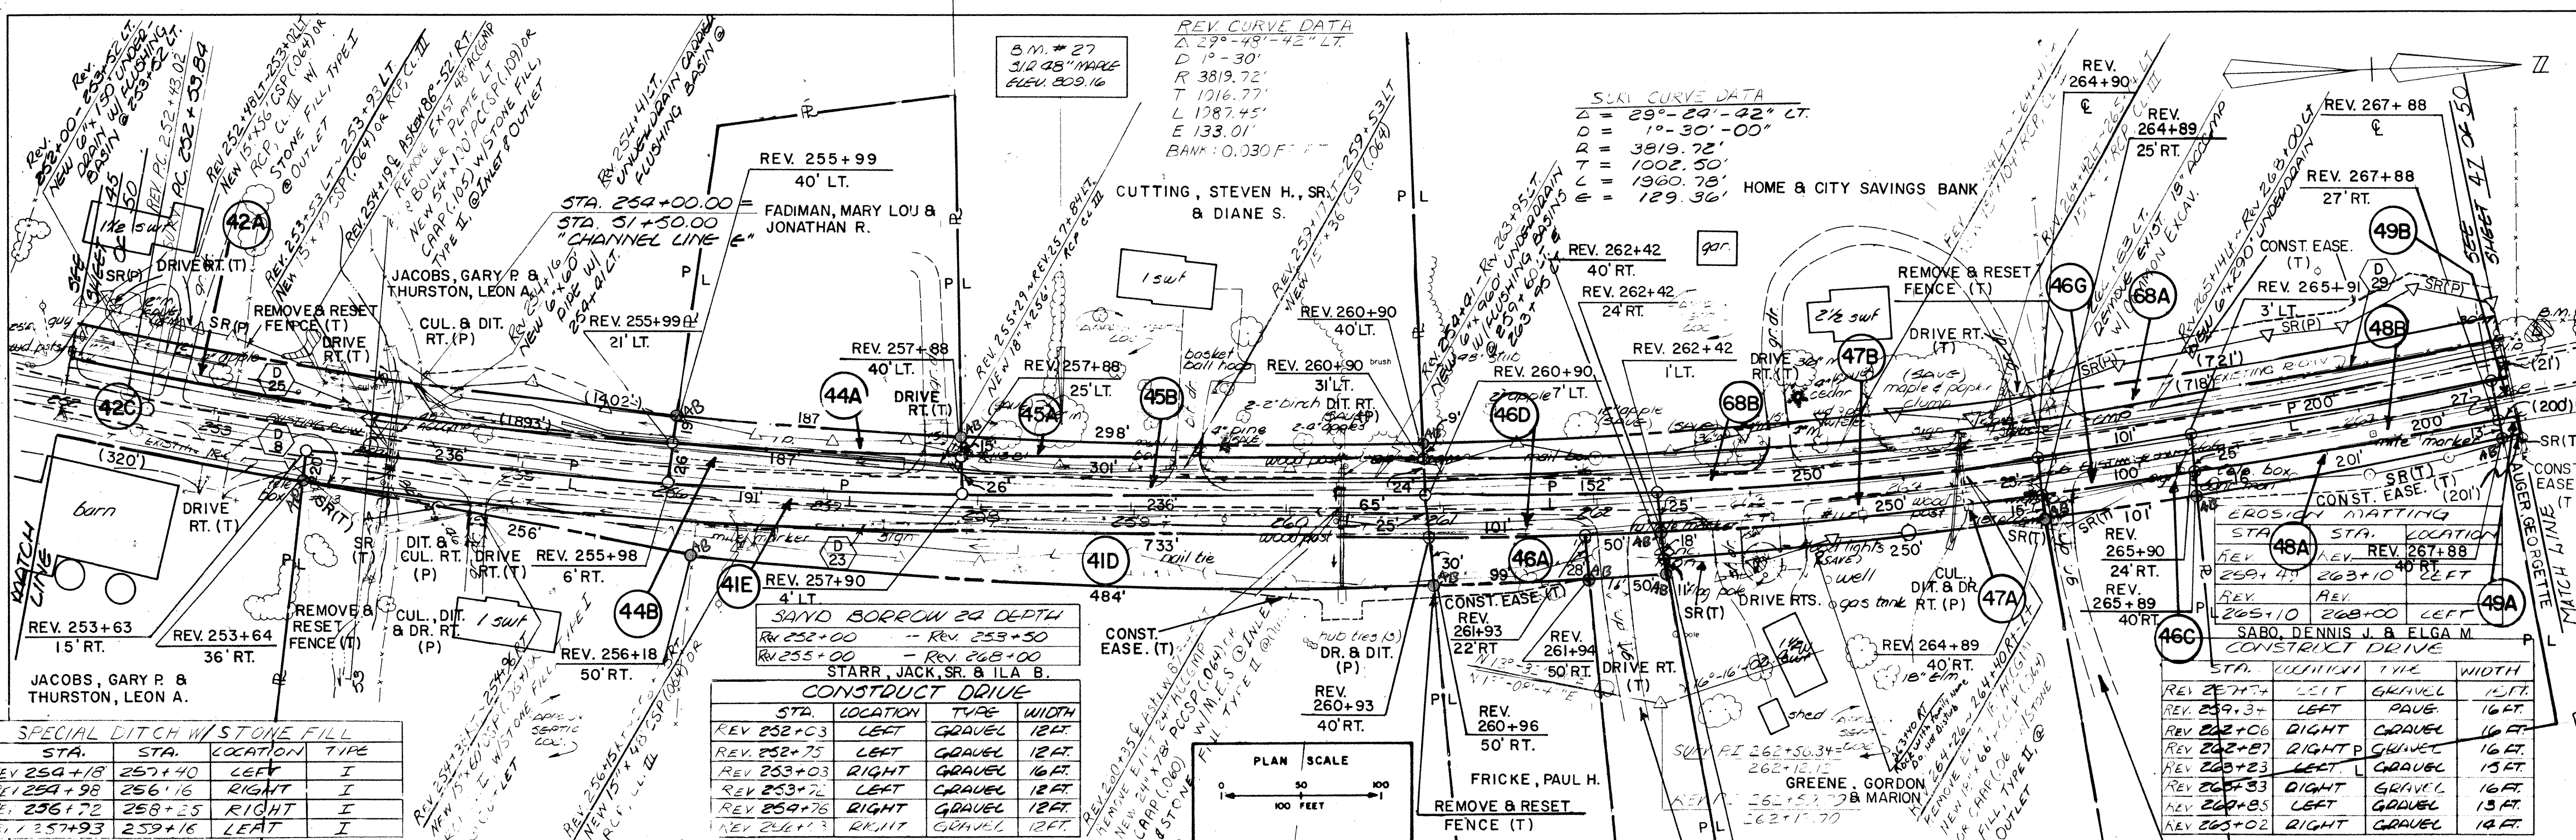

**SPECIAL DITCH W/STONE FILL**



STA.	STA.	LOCATION	TYPE
REV 254+18	257+40	LEFT	I
REV 254+98	256+16	RIGHT	I
REV 256+72	258+25	RIGHT	I
REV 257+93	259+16	LEFT	I

**CONSTRUCT DRIVE**


STA.	LOCATION	TYPE	WIDTH
REV 252+03	LEFT	GRAVEL	12 FT.
REV 252+75	LEFT	GRAVEL	12 FT.
REV 253+03	RIGHT	GRAVEL	16 FT.
REV 253+76	LEFT	GRAVEL	12 FT.
REV 254+76	RIGHT	GRAVEL	12 FT.
REV 256+73	RIGHT	GRAVEL	12 FT.

STA.	LOCATION	TYPE	WIDTH
REV 257+74	LEFT	GRAVEL	15 FT.
REV 259+34	LEFT	PAVE	16 FT.
REV 262+06	RIGHT	GRAVEL	16 FT.
REV 262+27	RIGHT	GRAVEL	16 FT.
REV 263+23	LEFT	GRAVEL	15 FT.
REV 264+33	RIGHT	GRAVEL	16 FT.
REV 264+85	LEFT	GRAVEL	13 FT.
REV 265+02	RIGHT	GRAVEL	14 FT.

DATUM  
 VERTICAL: NATIONAL GEODETIC VERTICAL DATUM 1929  
 HORIZONTAL: VT. STATE COORDINATE SYSTEM

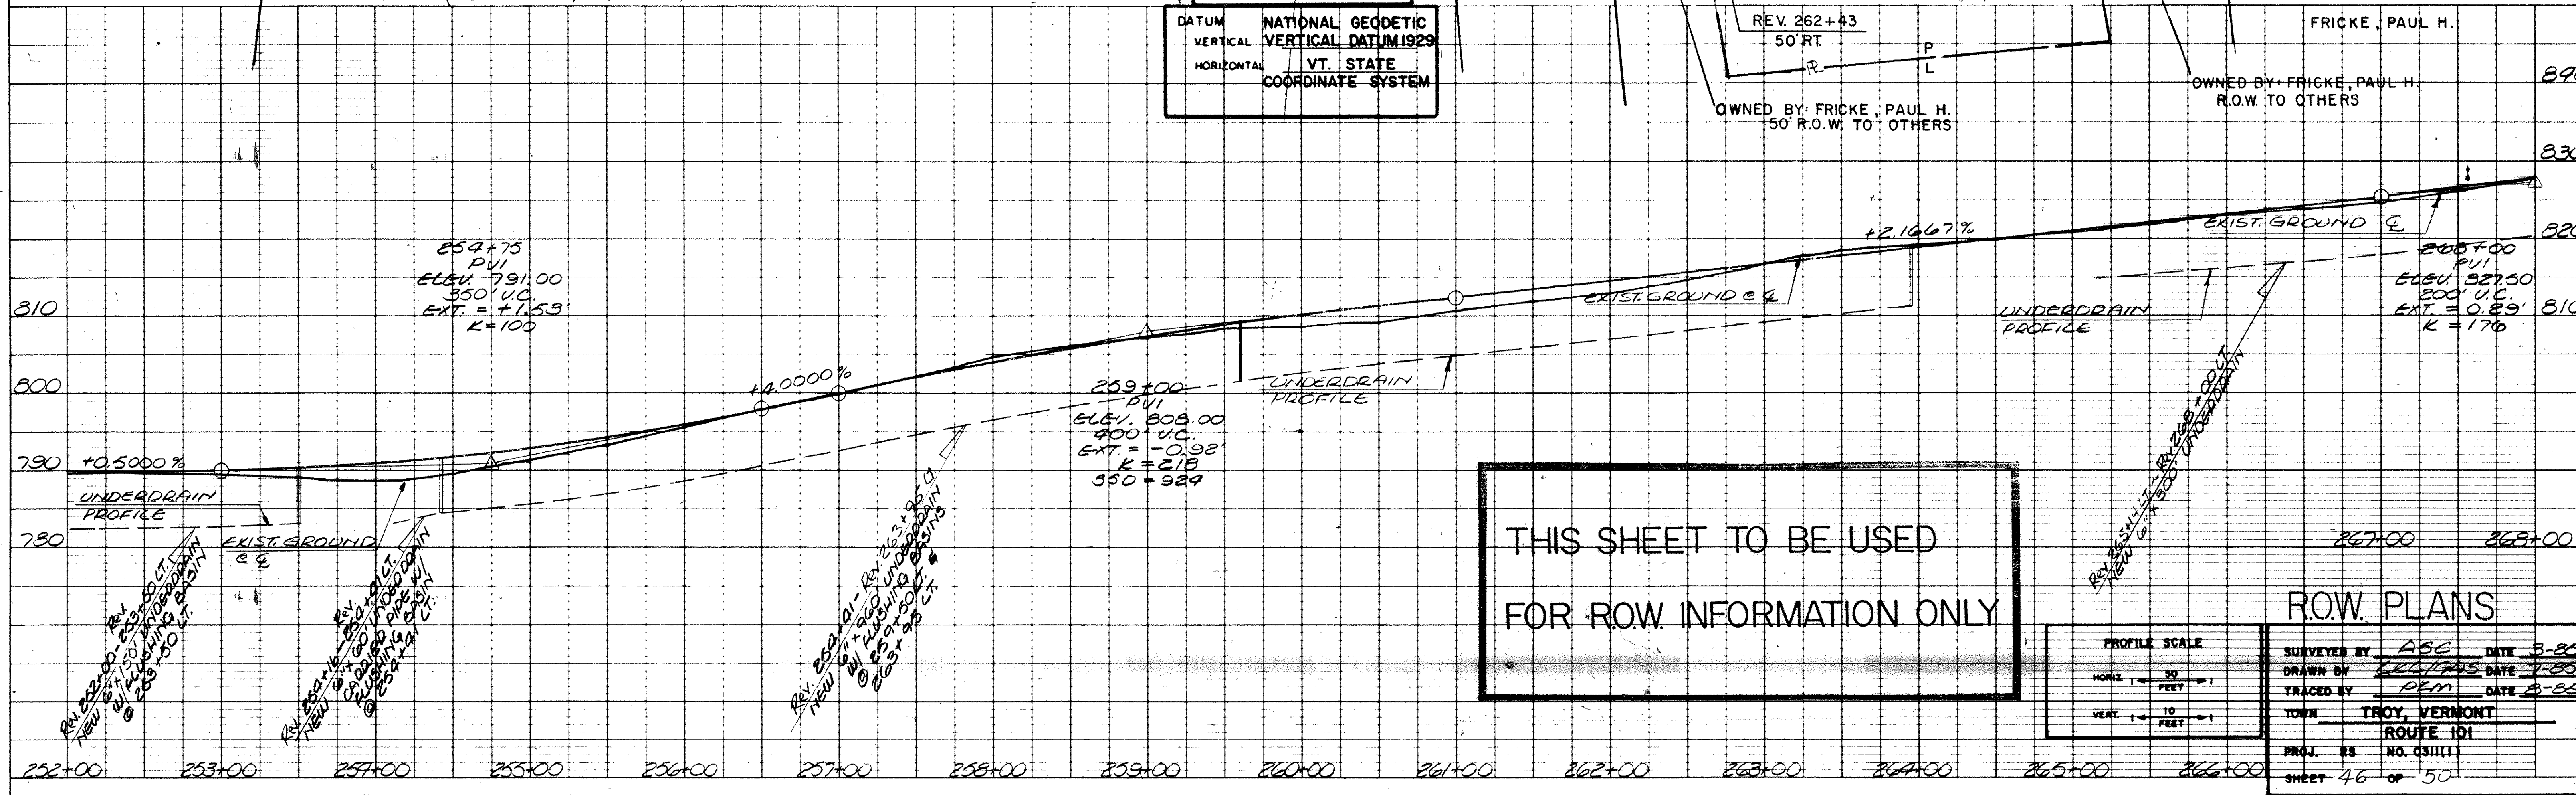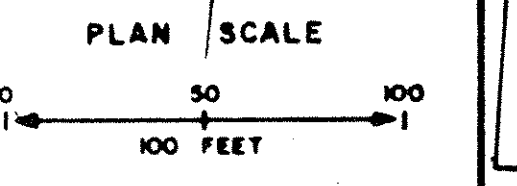

**THIS SHEET TO BE USED FOR ROW INFORMATION ONLY**

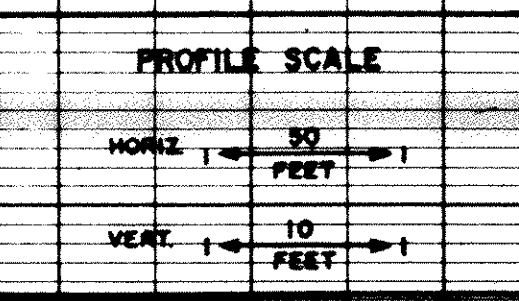

**ROW PLANS**

SURVEYED BY	ASC	DATE	3-85
DRAWN BY	LD/GRS	DATE	7-85
TRACED BY	REM	DATE	8-85
TOWN	TROY, VERMONT		
	ROUTE 101		
PROJ. NO.	NO. 031111		
SHEET	46	OF	50