

CONSTRUCT DRIVE			
STA	LOCATION	TYPE	WIDTH
284+30	LEFT	GRAVEL	12 FT.
297+00	LEFT	GRAVEL	16 FT.
294+65	LEFT	GRAVEL	25 FT.



**CURVE DATA**  
 D = 15°-12'-32" LT.  
 D = 2°-30'-00"  
 L = 2291.83'  
 T = 305.98'  
 L = 603.32'  
 E = 20.33'  
 BANK = .006 FT./FT.

B.M. # 32  
 312 36.57M  
 ELEV 317.89

B.M. # 33  
 310 24" MARK  
 ELEV 319.25

PLAN  
 SURVEYED BY  
 ADJUSTMENT CHECKED BY  
 NOTE BOOK NO.

PROFILE  
 SURVEYED BY  
 GRADES CHECKED BY  
 NOTE BOOK NO.

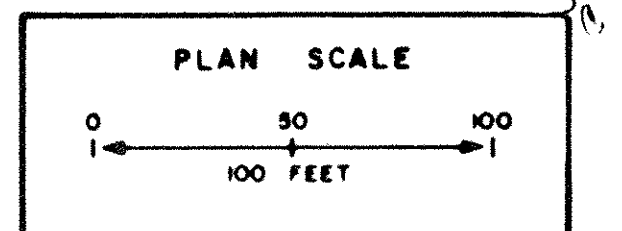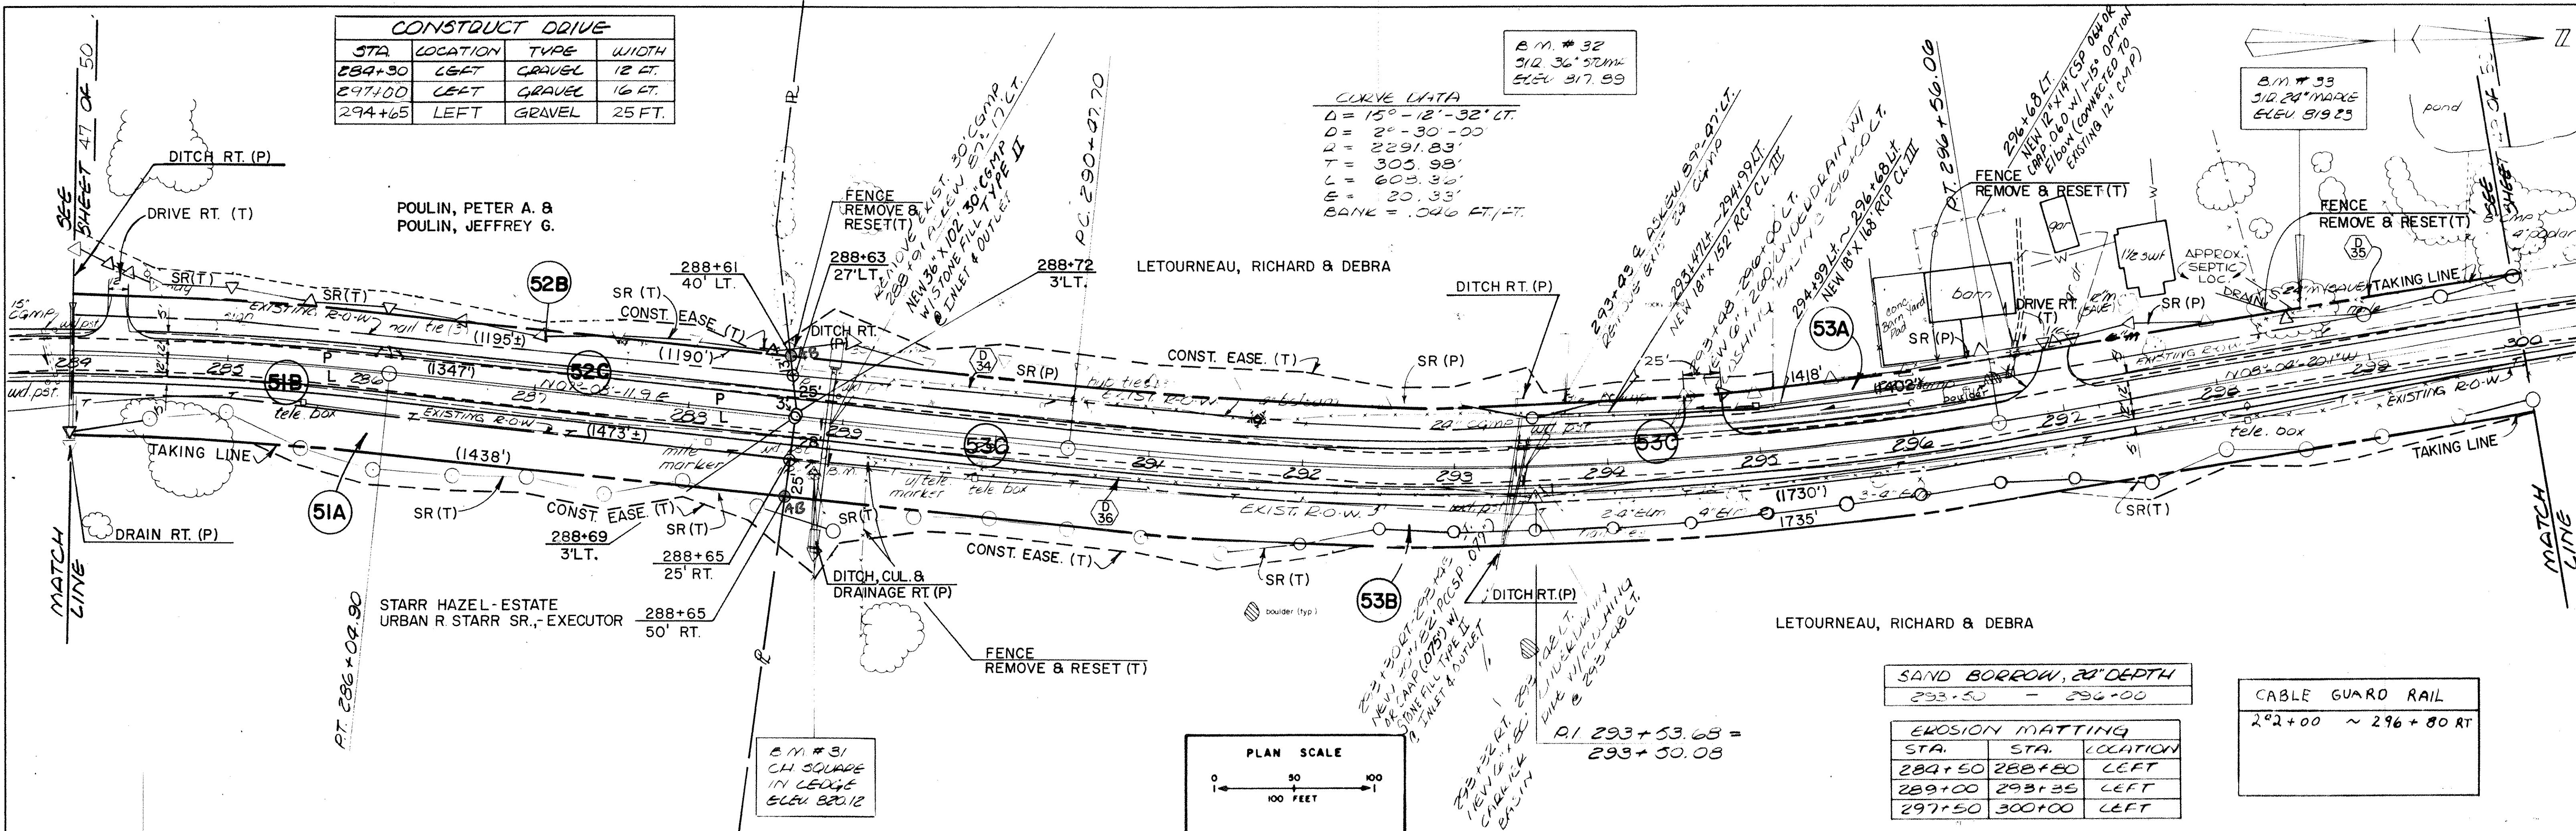


DATUM NATIONAL GEODETIC  
 VERTICAL VERTICAL DATUM 1929  
 HORIZONTAL VT. STATE  
 COORDINATE SYSTEM


SAND BORROW, 20' DEPTH  
 293+50 - 296+00

CABLE GUARD RAIL  
 292+00 ~ 296+80 RT

EROSION MATTING		
STA.	STA.	LOCATION
284+50	288+80	LEFT
289+00	293+35	LEFT
297+50	300+00	LEFT

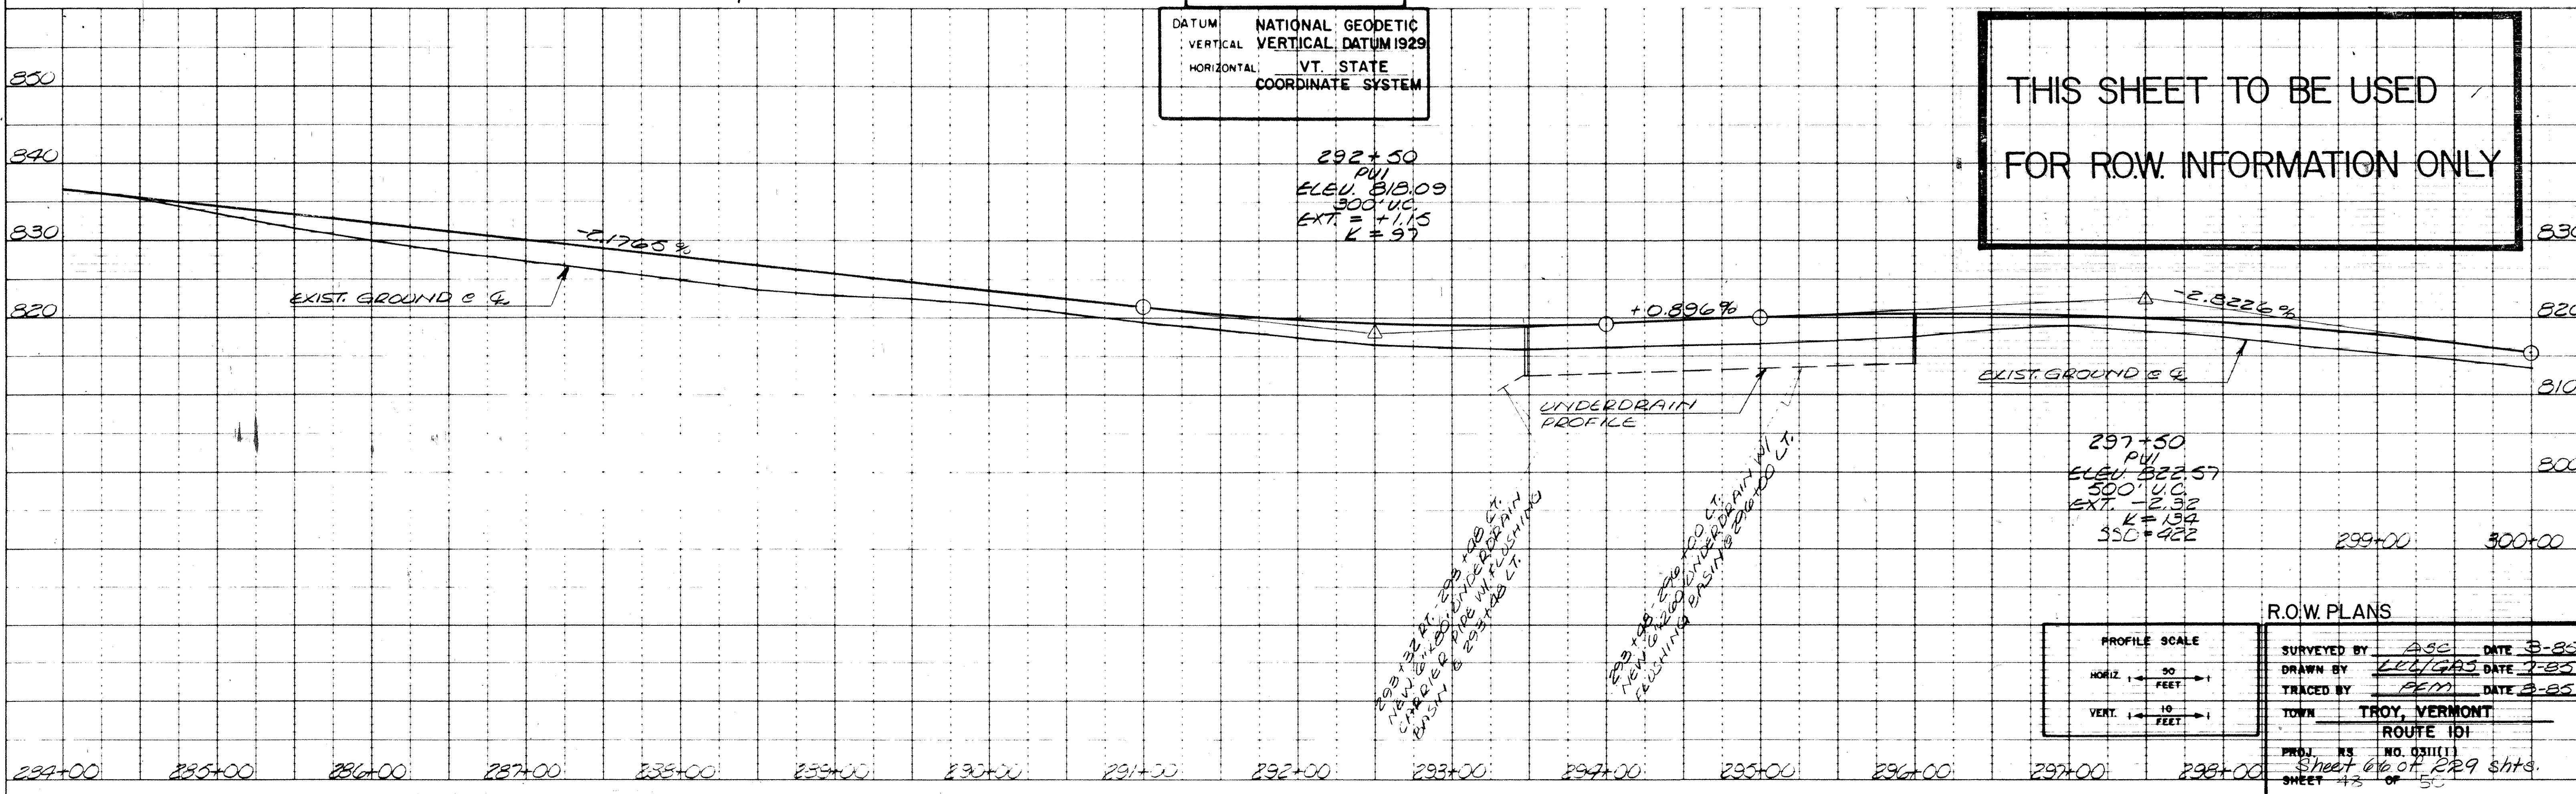

**THIS SHEET TO BE USED FOR ROW INFORMATION ONLY**

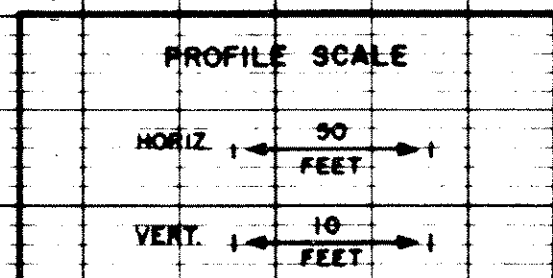

**R.O.W. PLANS**  
 SURVEYED BY ASC DATE 3-85  
 DRAWN BY LELIGAS DATE 7-85  
 TRACED BY PEM DATE 3-85  
 TOWN TROY, VERMONT  
 ROUTE 101  
 PROJ. NO. NO. 0311(1)  
 Sheet 6 of 229 shts.  
 SHEET 43 OF 50