

SPECIAL DITCH W/STONE FILL

STA.	STA.	LOCATION	TYPE
300+50	304+15	LEFT	I
304+50	305+30	LEFT	I
307+50	309+40	LEFT	I
312+50	314+00	LEFT	I

B.M. #35  
3/2" 12" STUMP  
ELEV. 794.16

CURVE DATA

$\Delta$	$= 14^{\circ} 09' 51''$ LT.
$\Delta$	$= 30^{\circ} 15' 00''$
$R$	$= 1762.95'$
$L$	$= 219.03'$
$L$	$= 435.32'$
$L$	$= 13.55'$
BANK	$= .056$ FT./FT.


CURVE DATA

$\Delta$	$= 07^{\circ} 35' 39''$ RT.
$\Delta$	$= 2^{\circ} 30' 00''$
$R$	$= 2291.83'$
$L$	$= 152.11'$
$L$	$= 303.77'$
$L$	$= 5.04'$
BANK	$= .046$ FT./FT.

CONSTRUCT DRIVE

STA.	LOCATION	TYPE	WIDTH
304+31	LEFT	PAVE	12 FT.
312+36	RIGHT	GRAVEL	12 FT.
305+66	Left	Gravel	12 FT.
307+20	Right	Gravel	16 FT.

SAND BORROW, 24' DEPTH  
311+00 - 312+00

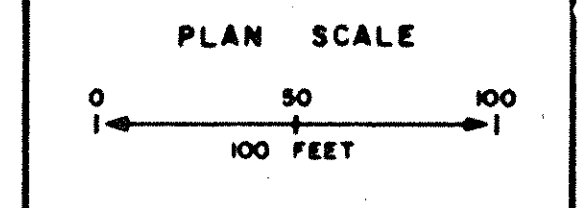


DATUM  
VERTICAL NATIONAL GEODETIC VERTICAL DATUM 1929  
HORIZONTAL VT. STATE COORDINATE SYSTEM

DRILLING = BLASTING OF SOLID ROCK SUBGRADE  
311+75 - 314+75

EROSION MATTING

STA.	STA.	LOCATION
300+00	300+50	LEFT
314+00	316+00	LEFT

THIS SHEET TO BE USED FOR ROW INFORMATION ONLY

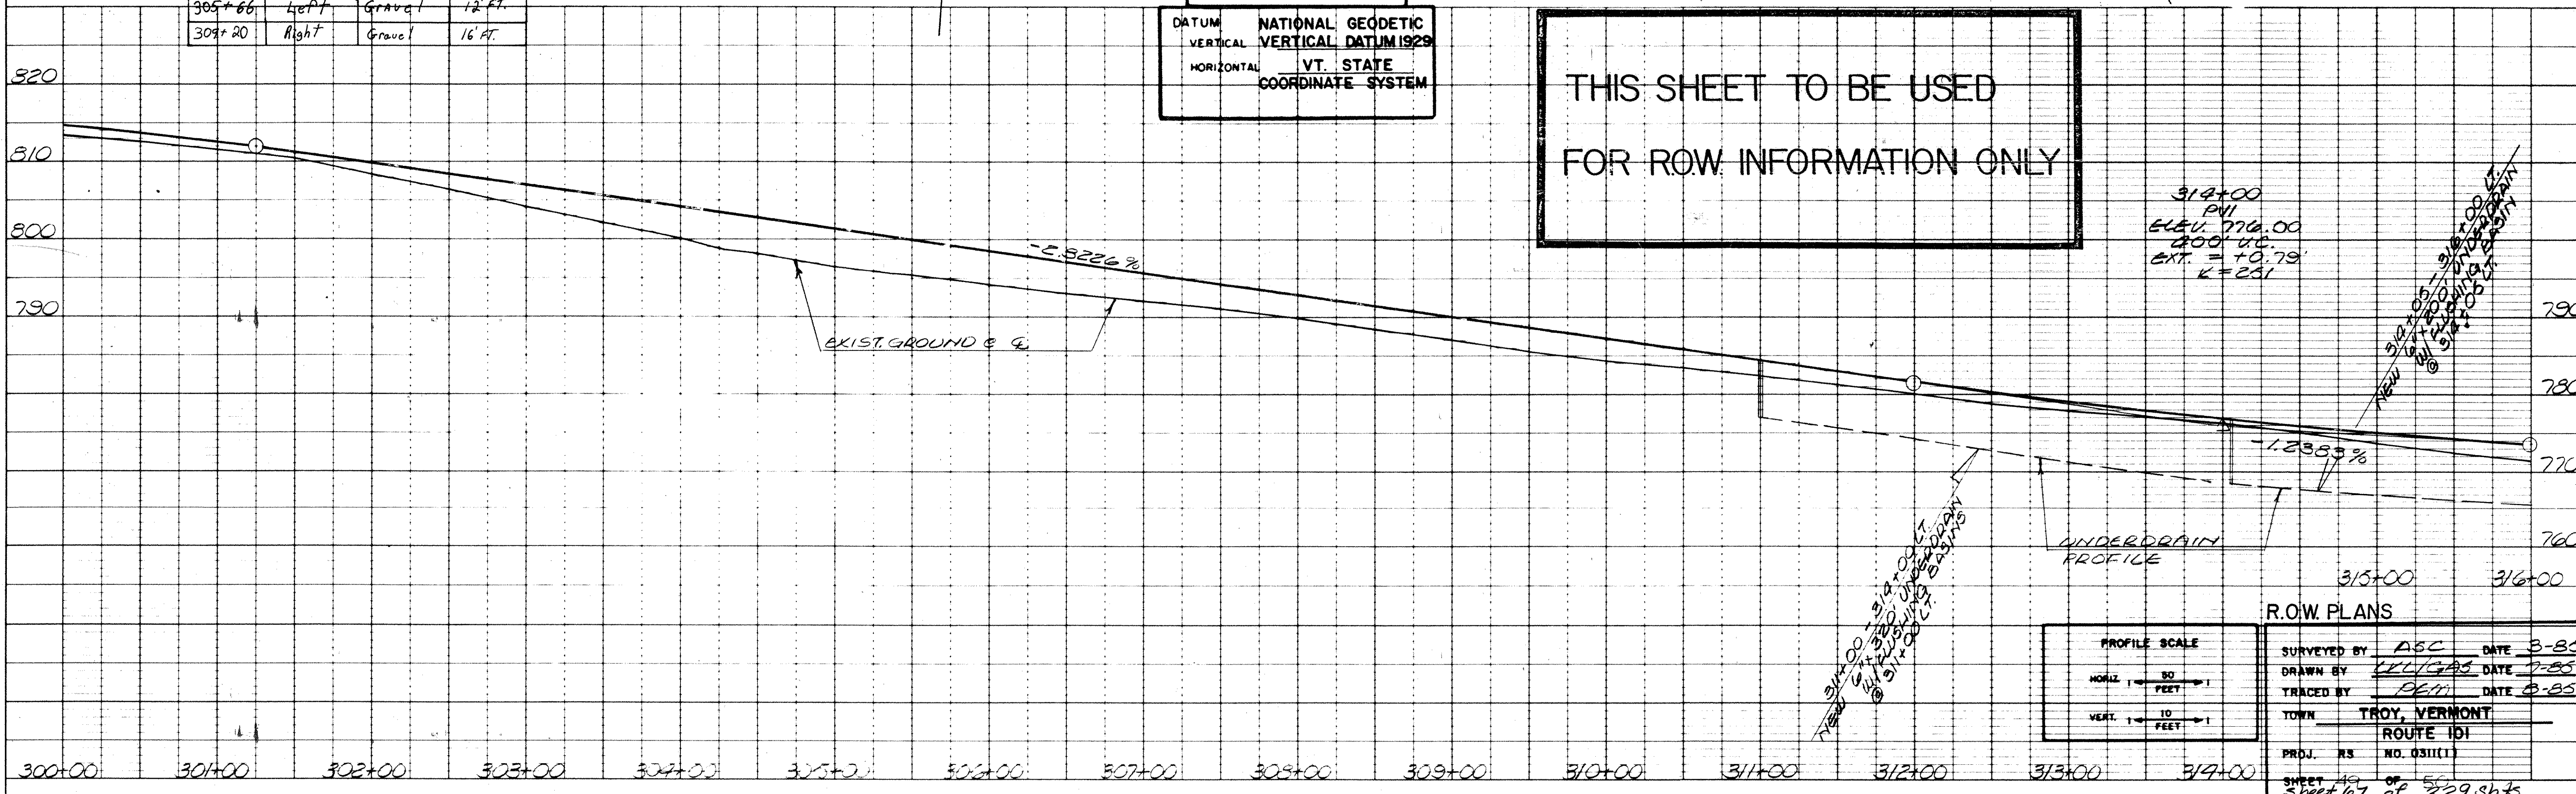

R.O.W. PLANS

SURVEYED BY	ASC	DATE	3-85
DRAWN BY	LL/LGAS	DATE	7-85
TRACED BY	DEM	DATE	8-85
TOWN	TROY, VERMONT		
ROUTE	ROUTE 101		
PROJ. NO.	NS NO. 0311(1)		
SHEET	49	OF	50
			Sheet 67 of 229 sheets

PLAN  
DATE  
BY  
SURVEYED  
CHECKED  
NOTE BOOK NO.  
BY WHY CHECKED

PROFILE  
DATE  
BY  
SURVEYED  
CHECKED  
NOTE BOOK NO.  
BY WHY CHECKED