



DATE	
BY	
REVISION	
NO.	
PLAN	
DATE	
BY	
REVISION	
NO.	
NOTE BOOK	
NO.	

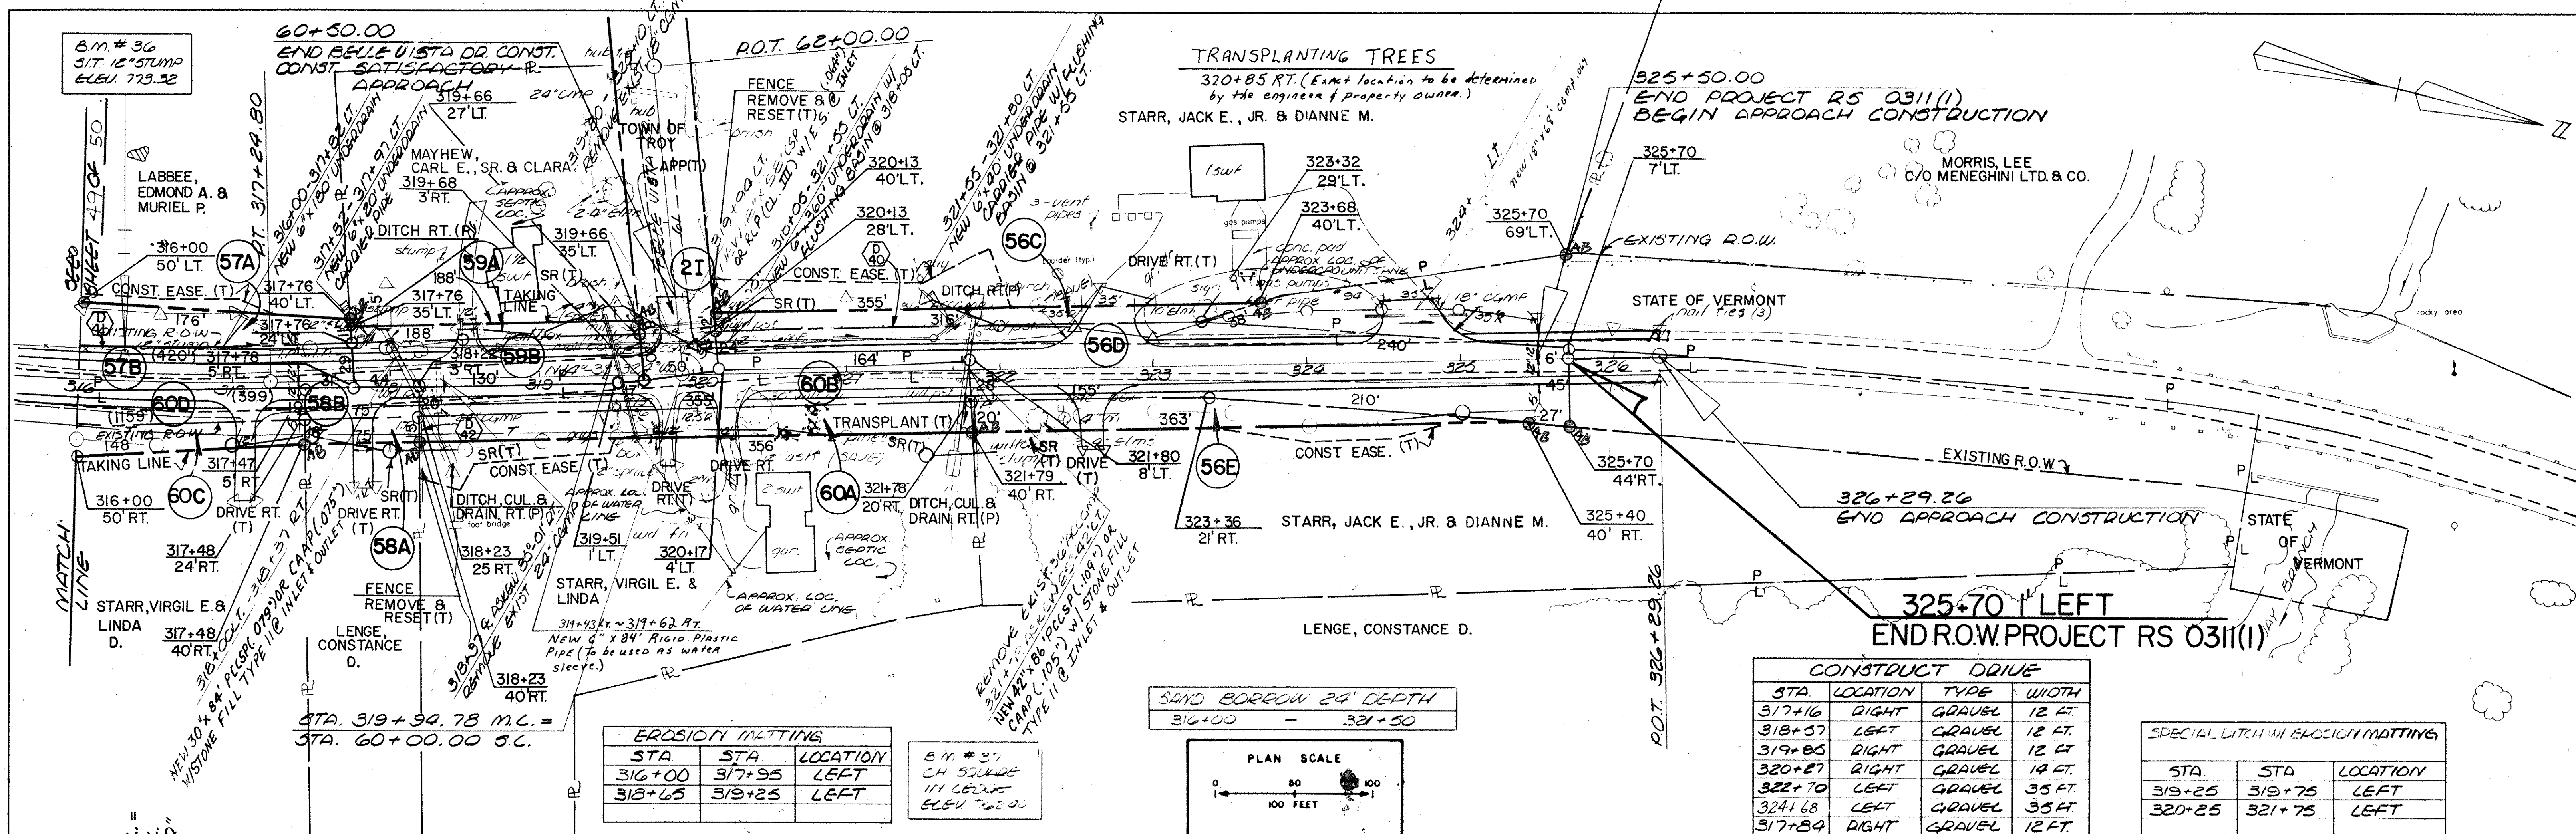

EROSION MATTING		
STA	STA	LOCATION
316+00	317+95	LEFT
318+65	319+25	LEFT


SAND BORROW 24' DEPTH	
STA	STA
316+00	321+50

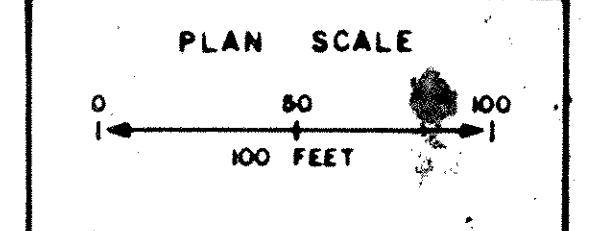

DATUM NATIONAL GEODETIC VERTICAL DATUM 1929  
HORIZONTAL VT. STATE COORDINATE SYSTEM

CONSTRUCT DRIVE			
STA	LOCATION	TYPE	WIDTH
317+16	RIGHT	GRAVEL	12 FT.
318+37	LEFT	GRAVEL	12 FT.
319+85	RIGHT	GRAVEL	12 FT.
320+27	RIGHT	GRAVEL	14 FT.
322+70	LEFT	GRAVEL	35 FT.
324+68	LEFT	GRAVEL	35 FT.
317+84	RIGHT	GRAVEL	12 FT.
322+61	Right	Gravel	14 FT.

SPECIAL LITCH WITH EROSION MATTING		
STA	STA	LOCATION
319+25	319+75	LEFT
320+25	321+75	LEFT

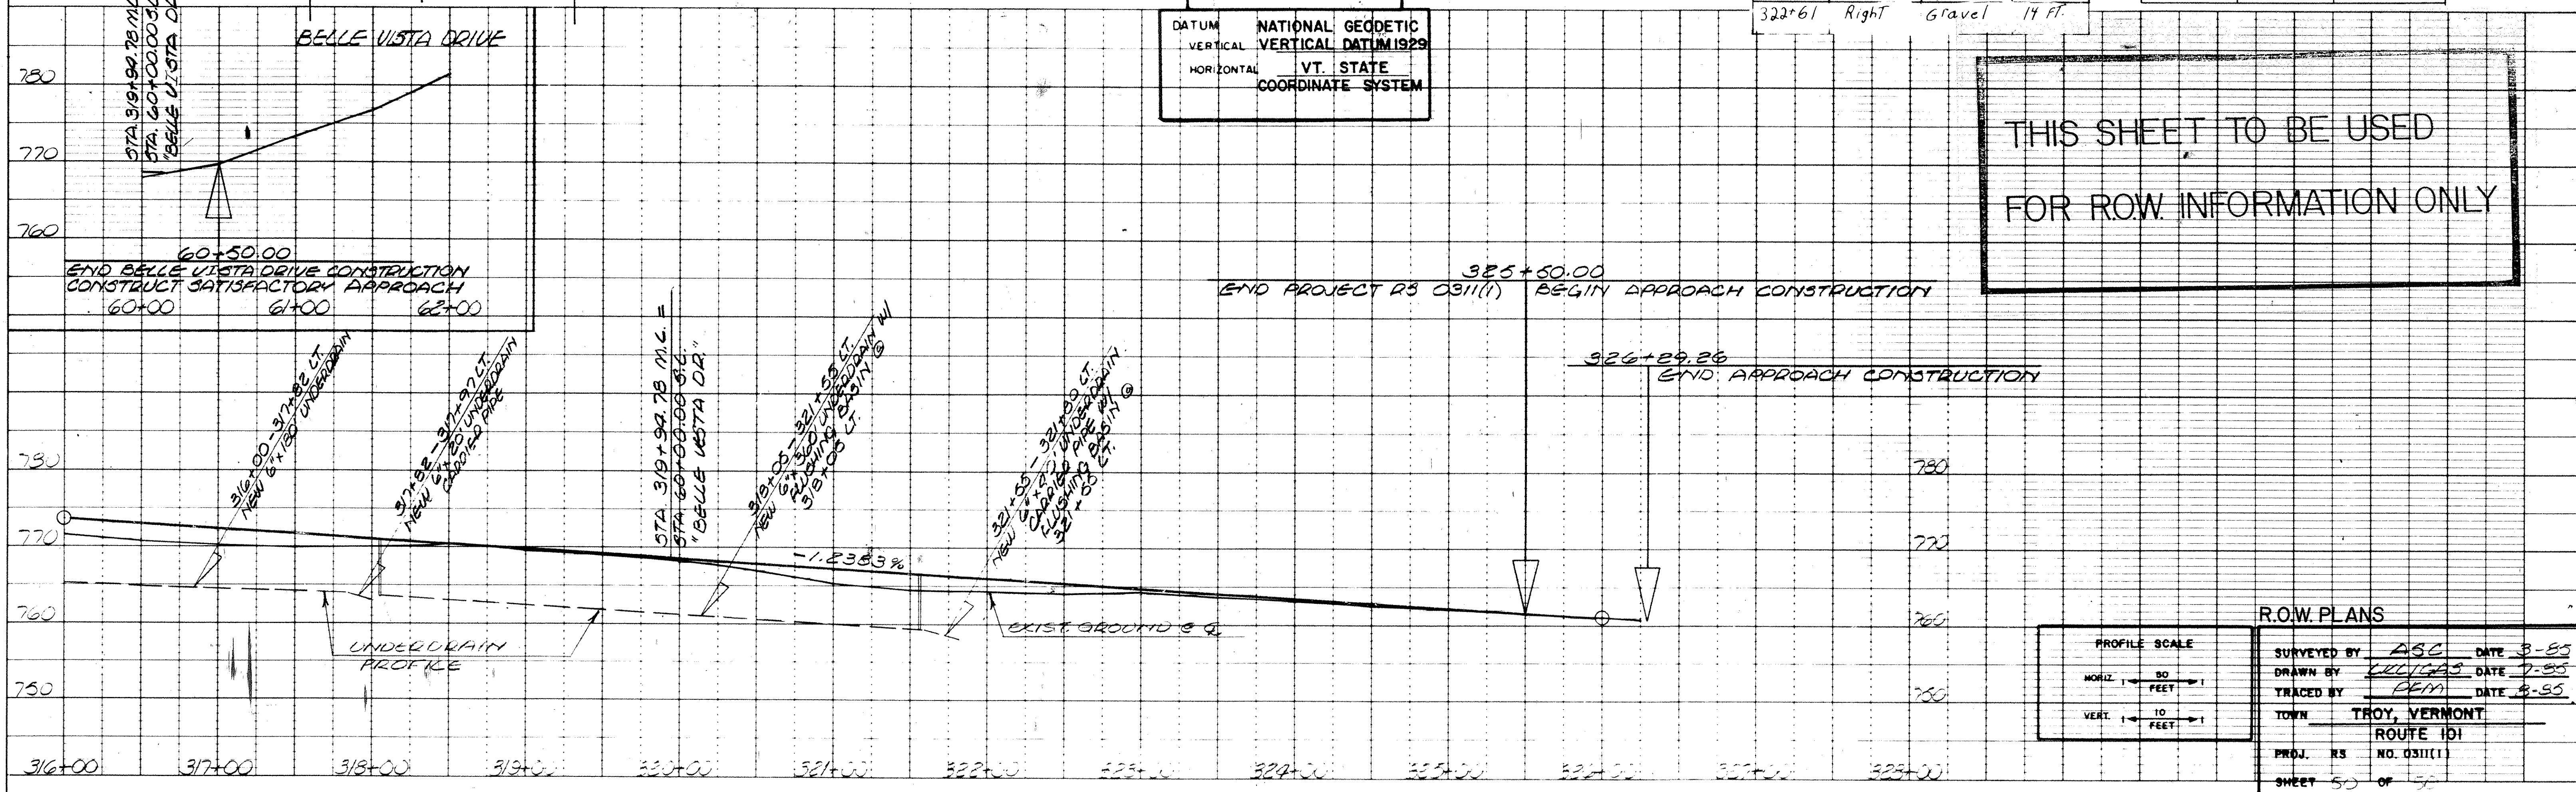

THIS SHEET TO BE USED FOR ROW INFORMATION ONLY

R.O.W. PLANS	
SURVEYED BY	ASC DATE 3-85
DRAWN BY	ELC/GAS DATE 7-85
TRACED BY	ELM DATE 8-85
TOWN	TROY, VERMONT
ROUTE ID	
PROJ. NO.	RS NO. 0311(1)
SHEET	50 OF 50