

CONSTRUCT DRIVE			
STA.	LOCATION	TYPE	WIDTH
159+36	LEFT	GRAVEL	12 FT.
160+82	LEFT	GRAVEL	16 FT.
170+40	LEFT	GRAVEL	16 FT.

TREATED TIMBER CURB		
STA.	STA.	LOCATION
163+00	172+00	RT.

STEEL BEAM GUARD RAIL	
STA.	LOCATION
163+00 RT.	172+00


RELOCATE MAILBOX SINGLE SUPPORT
170+15 LT. TO 170+05 LT.

CONSTRUCT MAILBOX PULLOUT
169+80 LT. ~ 170+25 LT.

B.M. #13
SIR. 10" PIPER
W. SIDE ROAD
ELEV. 818.99

SPECIAL DITCH W/STONE FILL			
STA.	STA.	LOCATION	TYPE
REV 158+40	REV 159+20	LEFT	I
REV 159+50	REV 160+65	LEFT	I
REV 161+12	REV 163+84	LEFT	I
REV 163+94	167+00	LEFT	I
167+10	170+10	LEFT	I
170+88	171+15	LEFT	I



DRILLING & BLASTING
OF SOLID ROCK SUBGRADE
REV 161+75 - REV 166+25

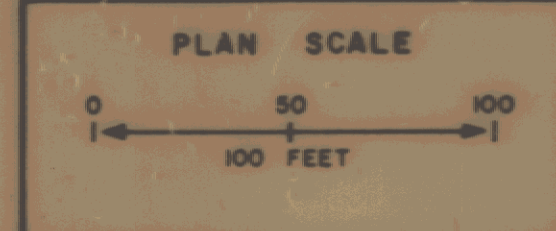

B.M. #17
TROY D13C
V043 5-43
IN CONC. POST
ELEV. 843.81

DATUM NATIONAL GEODETIC
VERTICAL VERTICAL DATUM 1929
HORIZONTAL VT. STATE
COORDINATE SYSTEM

171+28 ASKED 88+07 RT.
REMOVE EXIS. 20" CONC.
NEW 24" x 24" CONC. POST. 0.9' FOR CARP. 0.75' IN STONE FILL TYPE II & OUTLET

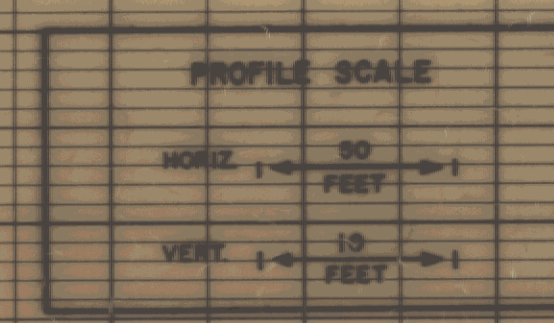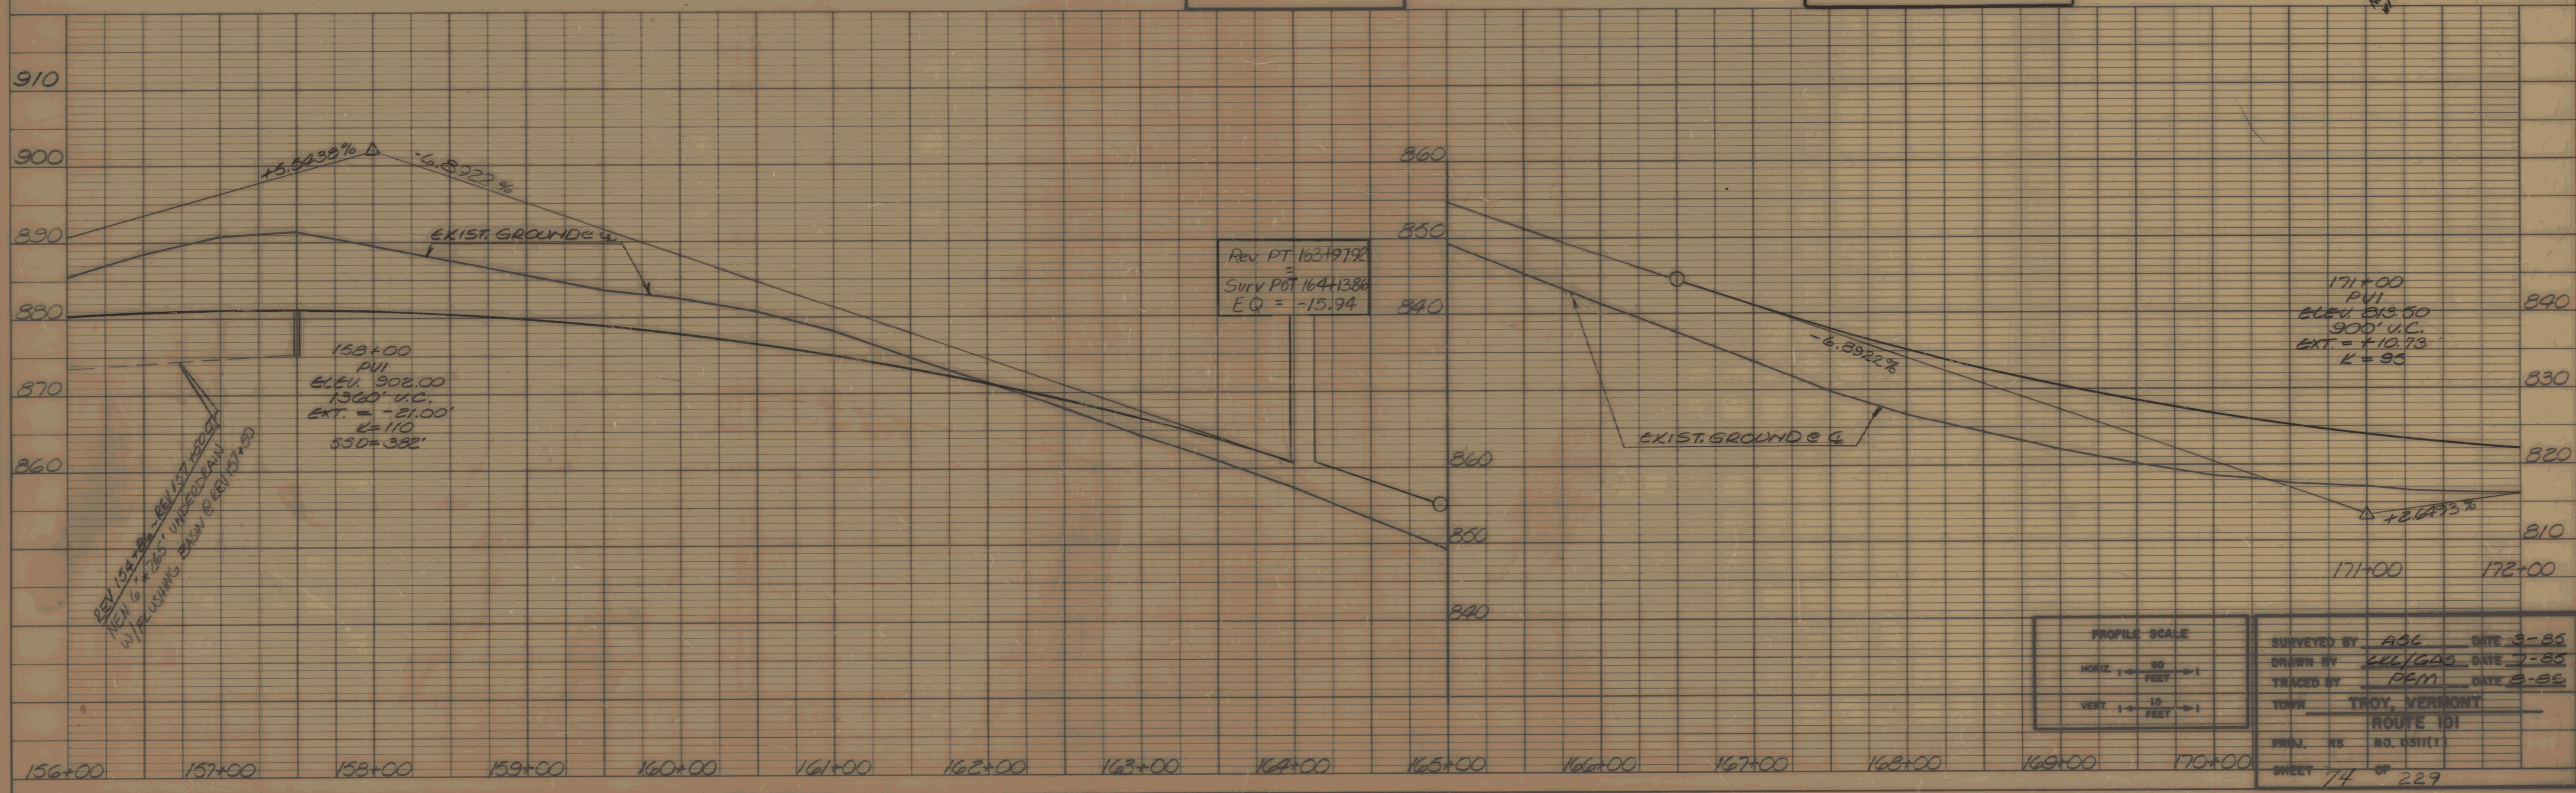

SURVEYED BY ASL DATE 3-85
DRAWN BY KLL/GAS DATE 7-85
TRACED BY PEM DATE 8-85
TOWN TROY, VERMONT
ROUTE 101
SHEET 74 OF 229