

TEMPORARY 4" REFLECTORIZED YELLOW
(DOUBLE SOLID LINE)
140+00 - 141+89 E
142+29 - 156+00 E

DURABLE 24" STOP BAR
T.H. "24" RT.
DURABLE LETTER IN WORD MARKING
T.H. "24" RT. "STOP"

REMOVING SIGNS
143+22 RT. (1)
147+00 E (2)
143+75 LT+RT. (2)
TOTAL THIS SHEET 5

SETTING SALVAGED POSTS
143+75 LT 1 EA.
143+75 RT 1 EA.
ERECTING SALVAGED SIGNS
143+75 LT 1 EA.
143+75 RT 1 EA.

TEMPORARY 4" REFLECTORIZED WHITE LINES
(FINAL COURSE ONLY) EDGE LINES
140+00 - 156+00 12' LT.
140+00 - 141+63 12' RT.
M.L. 141+63 - S.L. 40+42 12' RT. - 9' RT.
S.L. 40+33 - M.L. 156+00 9' LT. - 12' RT.

SEE SHEET 106
SPEED LIMIT 40
R & S SPEED LIMIT 40

SEE SHEET 94 OF 229

MATCH LINE

MATCH LINE


MATCH LINE

MATCH LINE

LEGAL LOAD LIMIT
24,000
POUNDS

STOP (NEW)

R & S SPEED LIMIT 50
S SPEED LIMIT 50

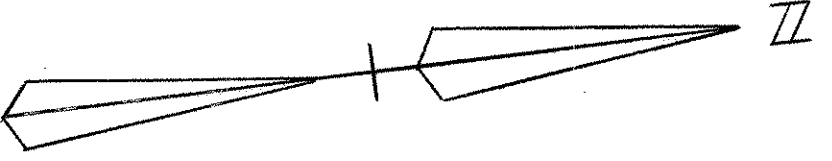

TEMPORARY 4" REFLECTORIZED YELLOW
(DOUBLE SOLID LINE)
156+00 - 172+00 E

TEMPORARY 4" REFLECTORIZED WHITE LINES
(FINAL COURSE ONLY) EDGE LINES
156+00 - 172+00 12' LT. & RT.

NOTE: REMOVE ALL EXISTING SIGNS UNLESS OTHERWISE NOTED TYPE "A" SIGN REMOVAL CENTERLINE MARKINGS (DOUBLE YELLOW LINE) SHALL BE APPLIED USING TEMPORARY MARKINGS ON EACH PAVEMENT COURSE. QUANTITIES REFLECT TWO APPLICATIONS.

SCALE: 1" = 50 FEET

SIGN LOCATION AND PAVE. MARKING SHEET

SURVEYED BY	DATE
DRAWN BY LKL/GAS	DATE 08-85
TRACED BY TJB/PEM	DATE 08-85
TOWN TROY, VERMONT	
PROJ. RS NO. 0311(1)	
SHEET 94 OF 229	