


DATE
BY
SURVEYED
PLATTED
NOTE BOOK
NO.
AREAS CHECKED

DATE
BY
ORIGINAL SURVEY
PLATTED
NOTE BOOK
NO.
AREAS CHECKED

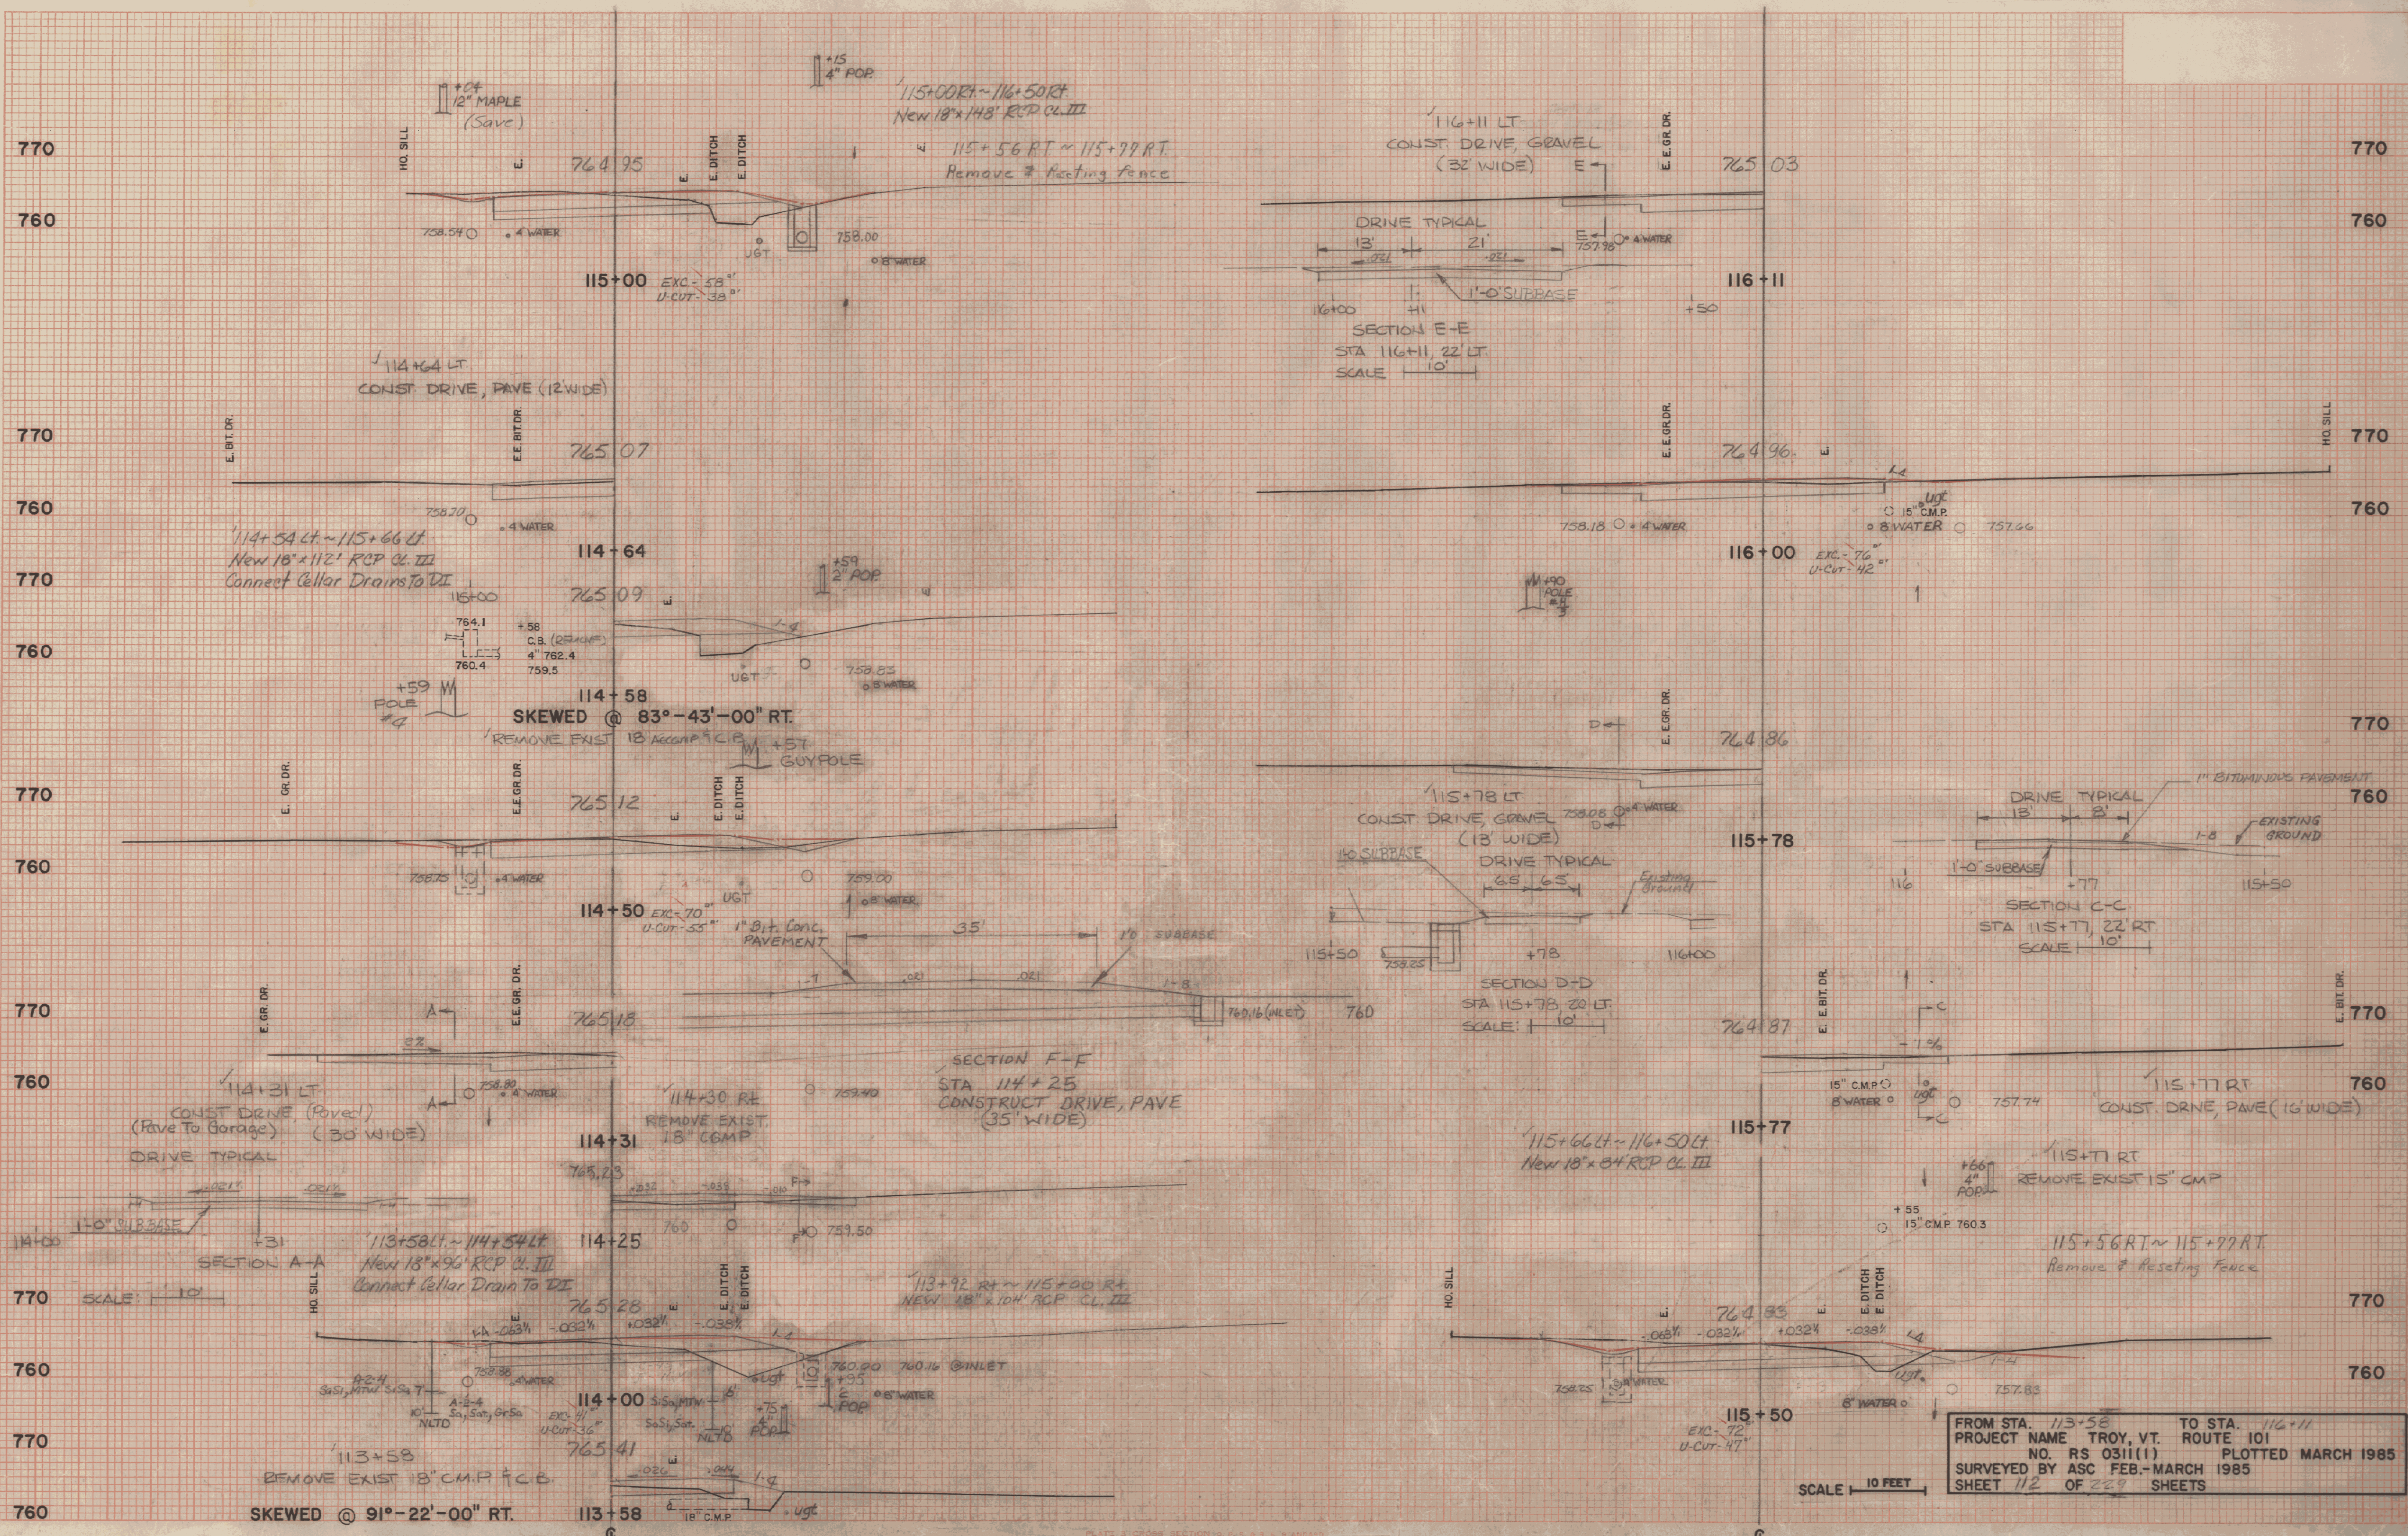

FROM STA. 113+58 TO STA. 116+11
 PROJECT NAME TROY, VT. ROUTE 101
 NO. RS 0311(1) PLOTTED MARCH 1985
 SURVEYED BY ASC FEB.-MARCH 1985
 SHEET 12 OF 229 SHEETS

SCALE 10 FEET

Plotted By TJB
 Plotted 11-25-91
 Planimetered 1-7-92
 New 11792 Feb

SHEET 12 OF 229 SHEETS