


DATE	BY
FINAL SURVEY	PLANNED
NOTED	NOTED
NO.	NO.

DATE	BY
ORIGINAL SURVEY	PLANNED
NOTED	NOTED
NO.	NO.

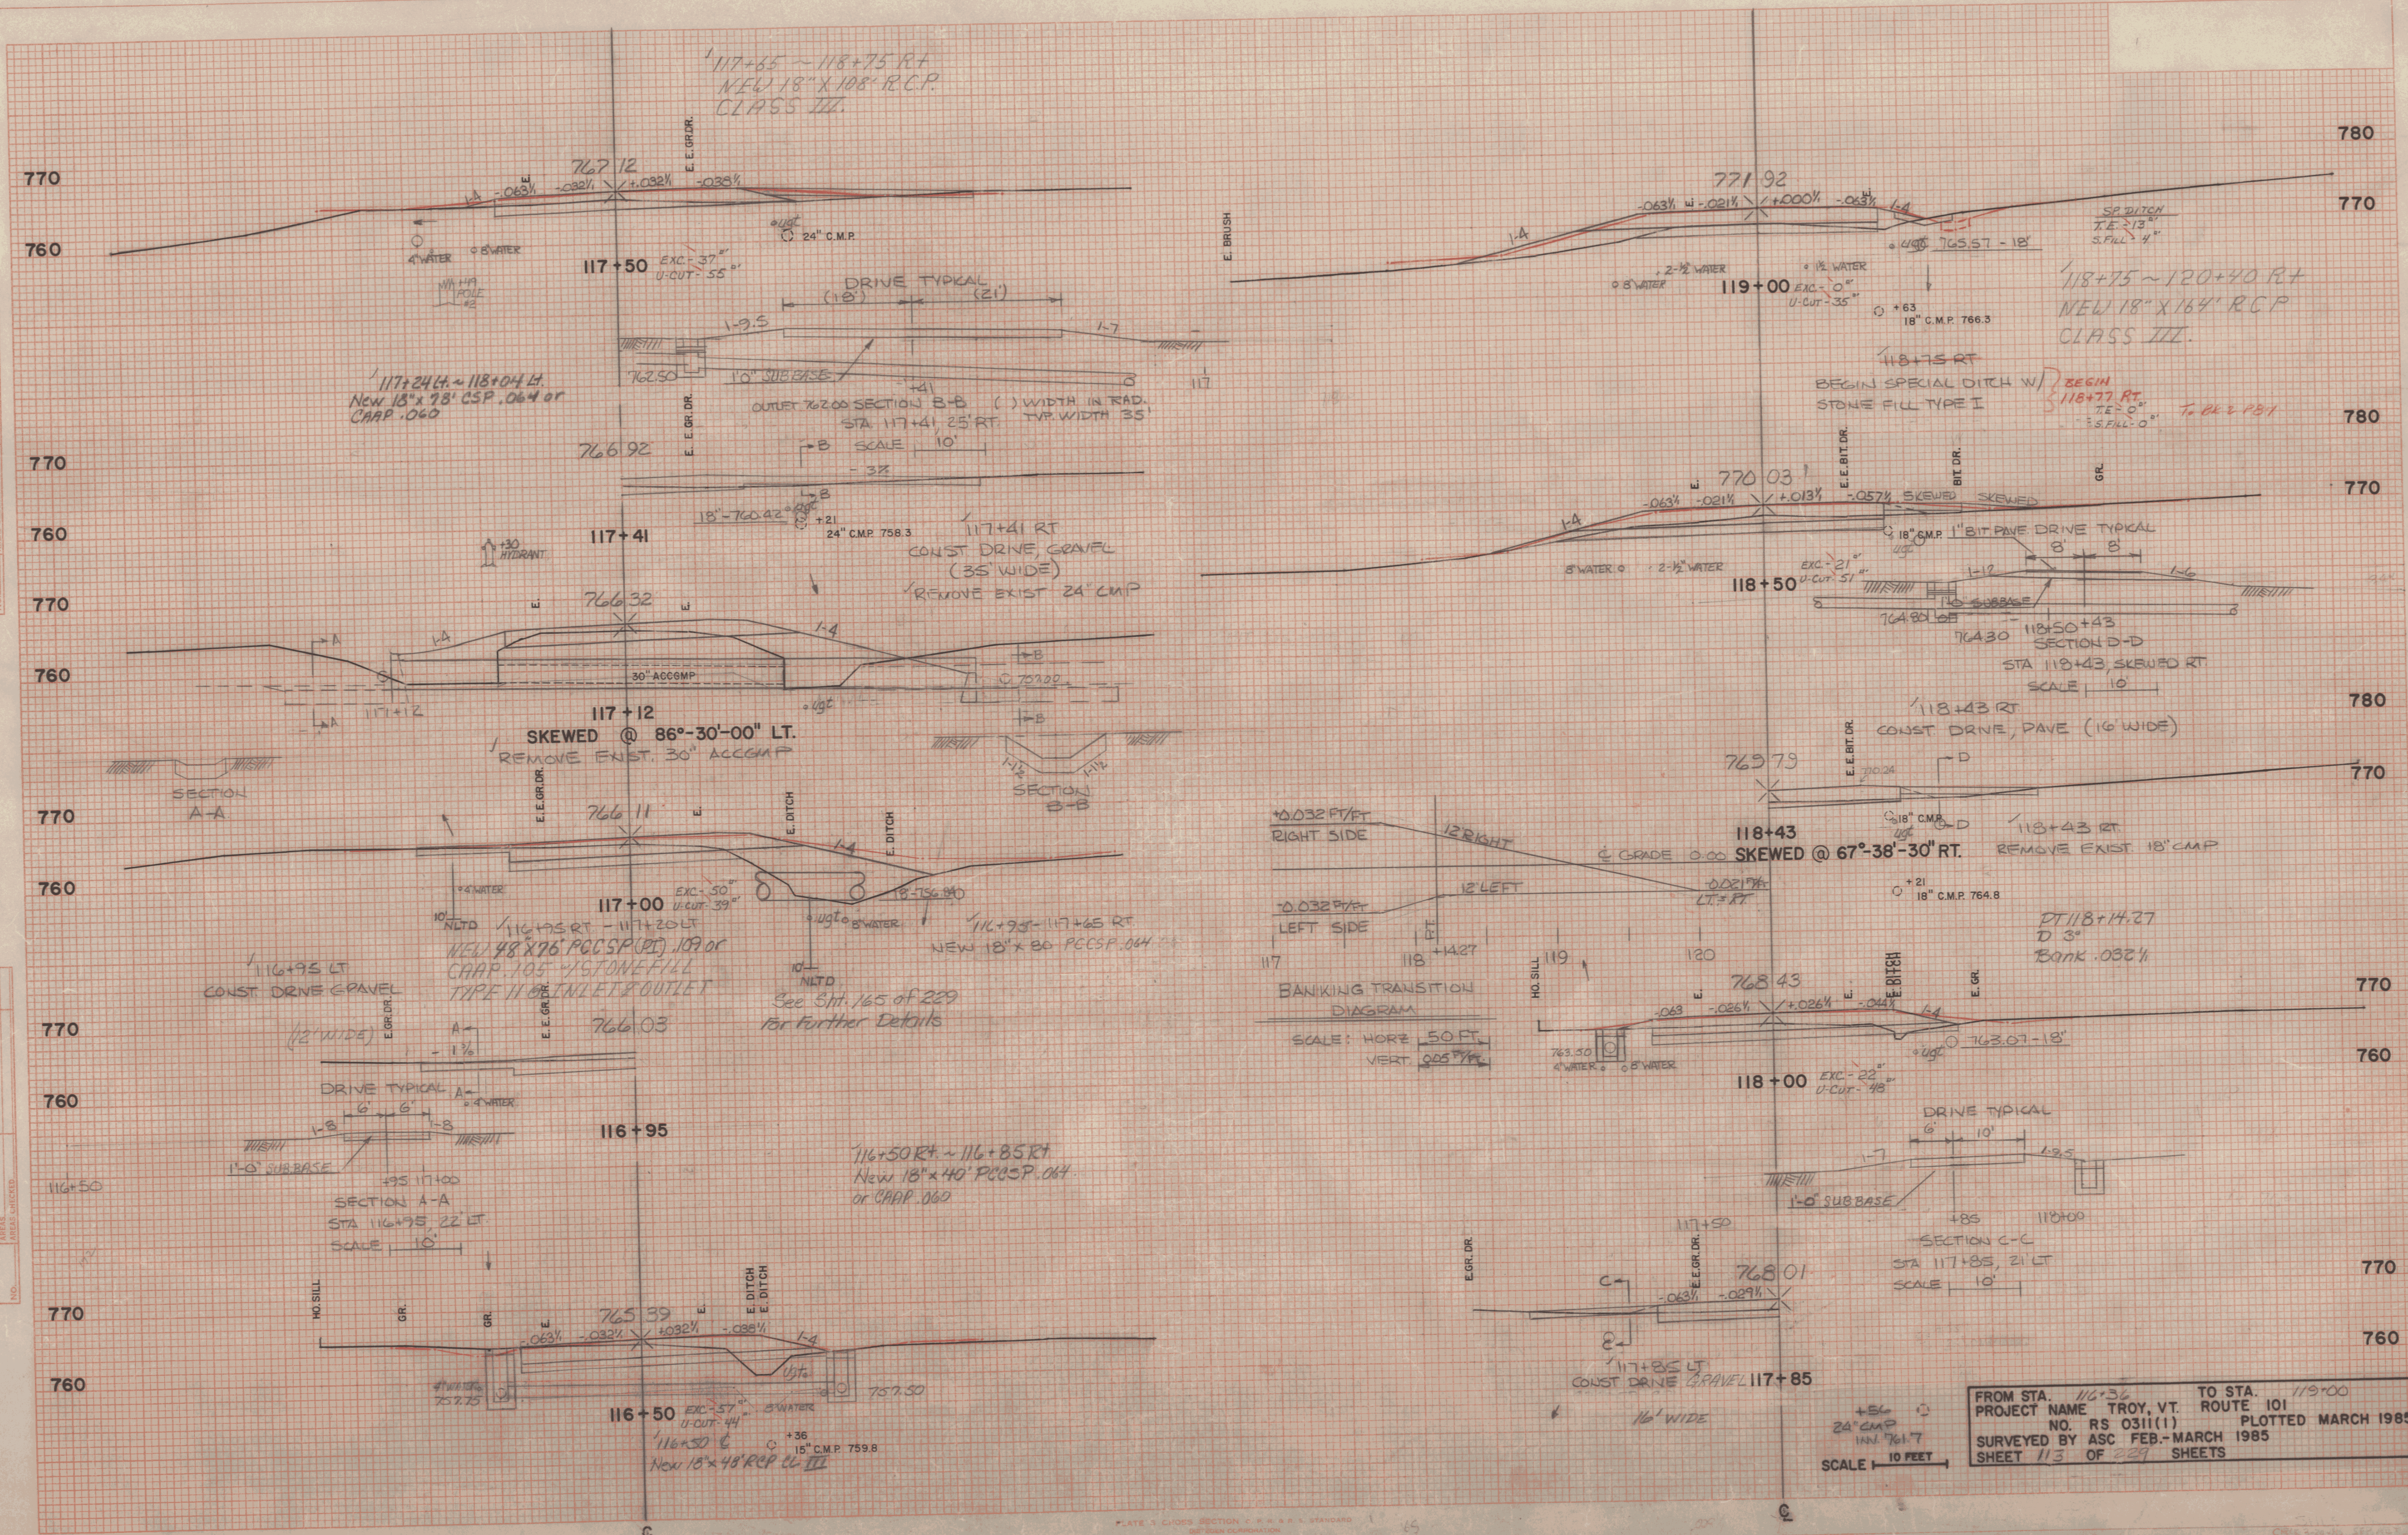

FROM STA. 116+36 TO STA. 119+00
 PROJECT NAME TROY, VT. ROUTE 101
 NO. RS 0311(1) PLOTTED MARCH 1985
 SURVEYED BY ASC FEB.-MARCH 1985
 SHEET 113 OF 229 SHEETS

PLOTTED 11-25-81
 RAINIERE 1-7-82
 PLAN 1-17-82