


DATE	
BY	
SURVEYED	
NOTED	
NO.	

DATE	
BY	
SURVEYED	
NOTED	
NO.	

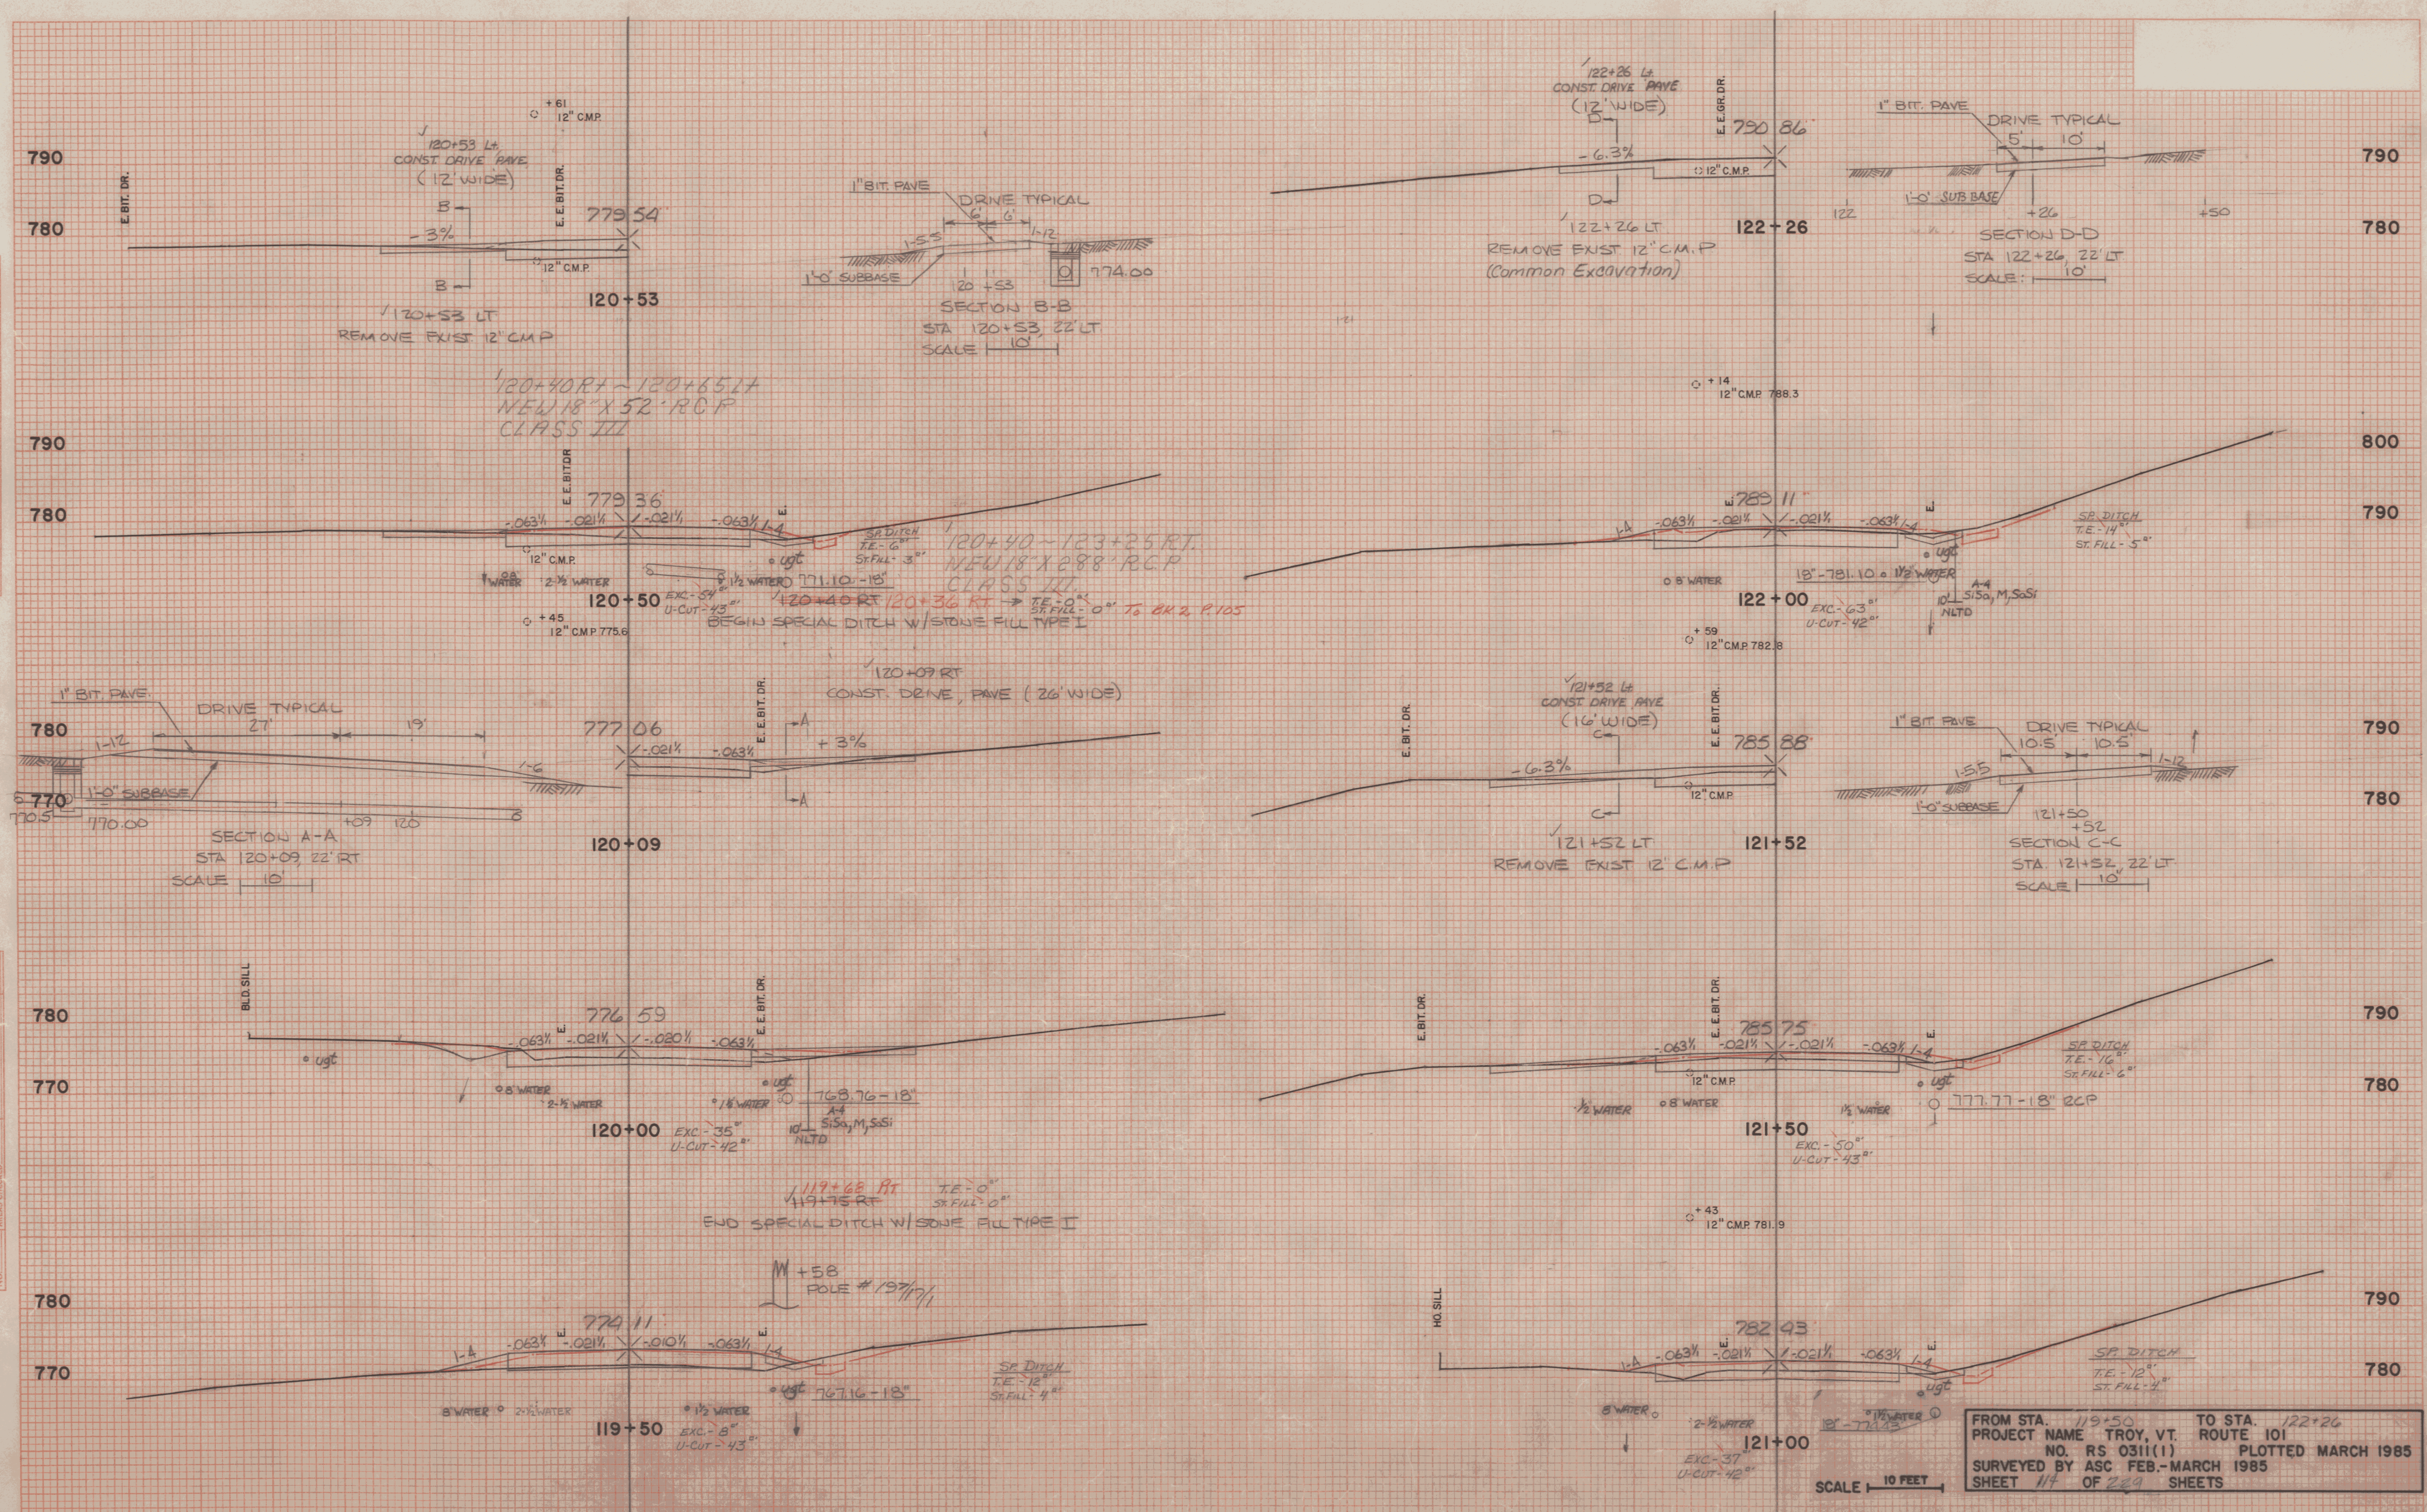

FROM STA. 119+50 TO STA. 122+26
 PROJECT NAME TROY, VT. ROUTE 101
 NO. RS 0311(1) PLOTTED MARCH 1985
 SURVEYED BY ASC FEB.-MARCH 1985
 SHEET 114 OF 229 SHEETS

PLATE 3 CROSS SECTION D.P.R. & STANDARD
 DETROIT CORPORATION

BUCKET BY TUE 12/85
 PLOT BY CLE
 PLANIMETERED 1-7-92
 PLOTTED 1-12-92