
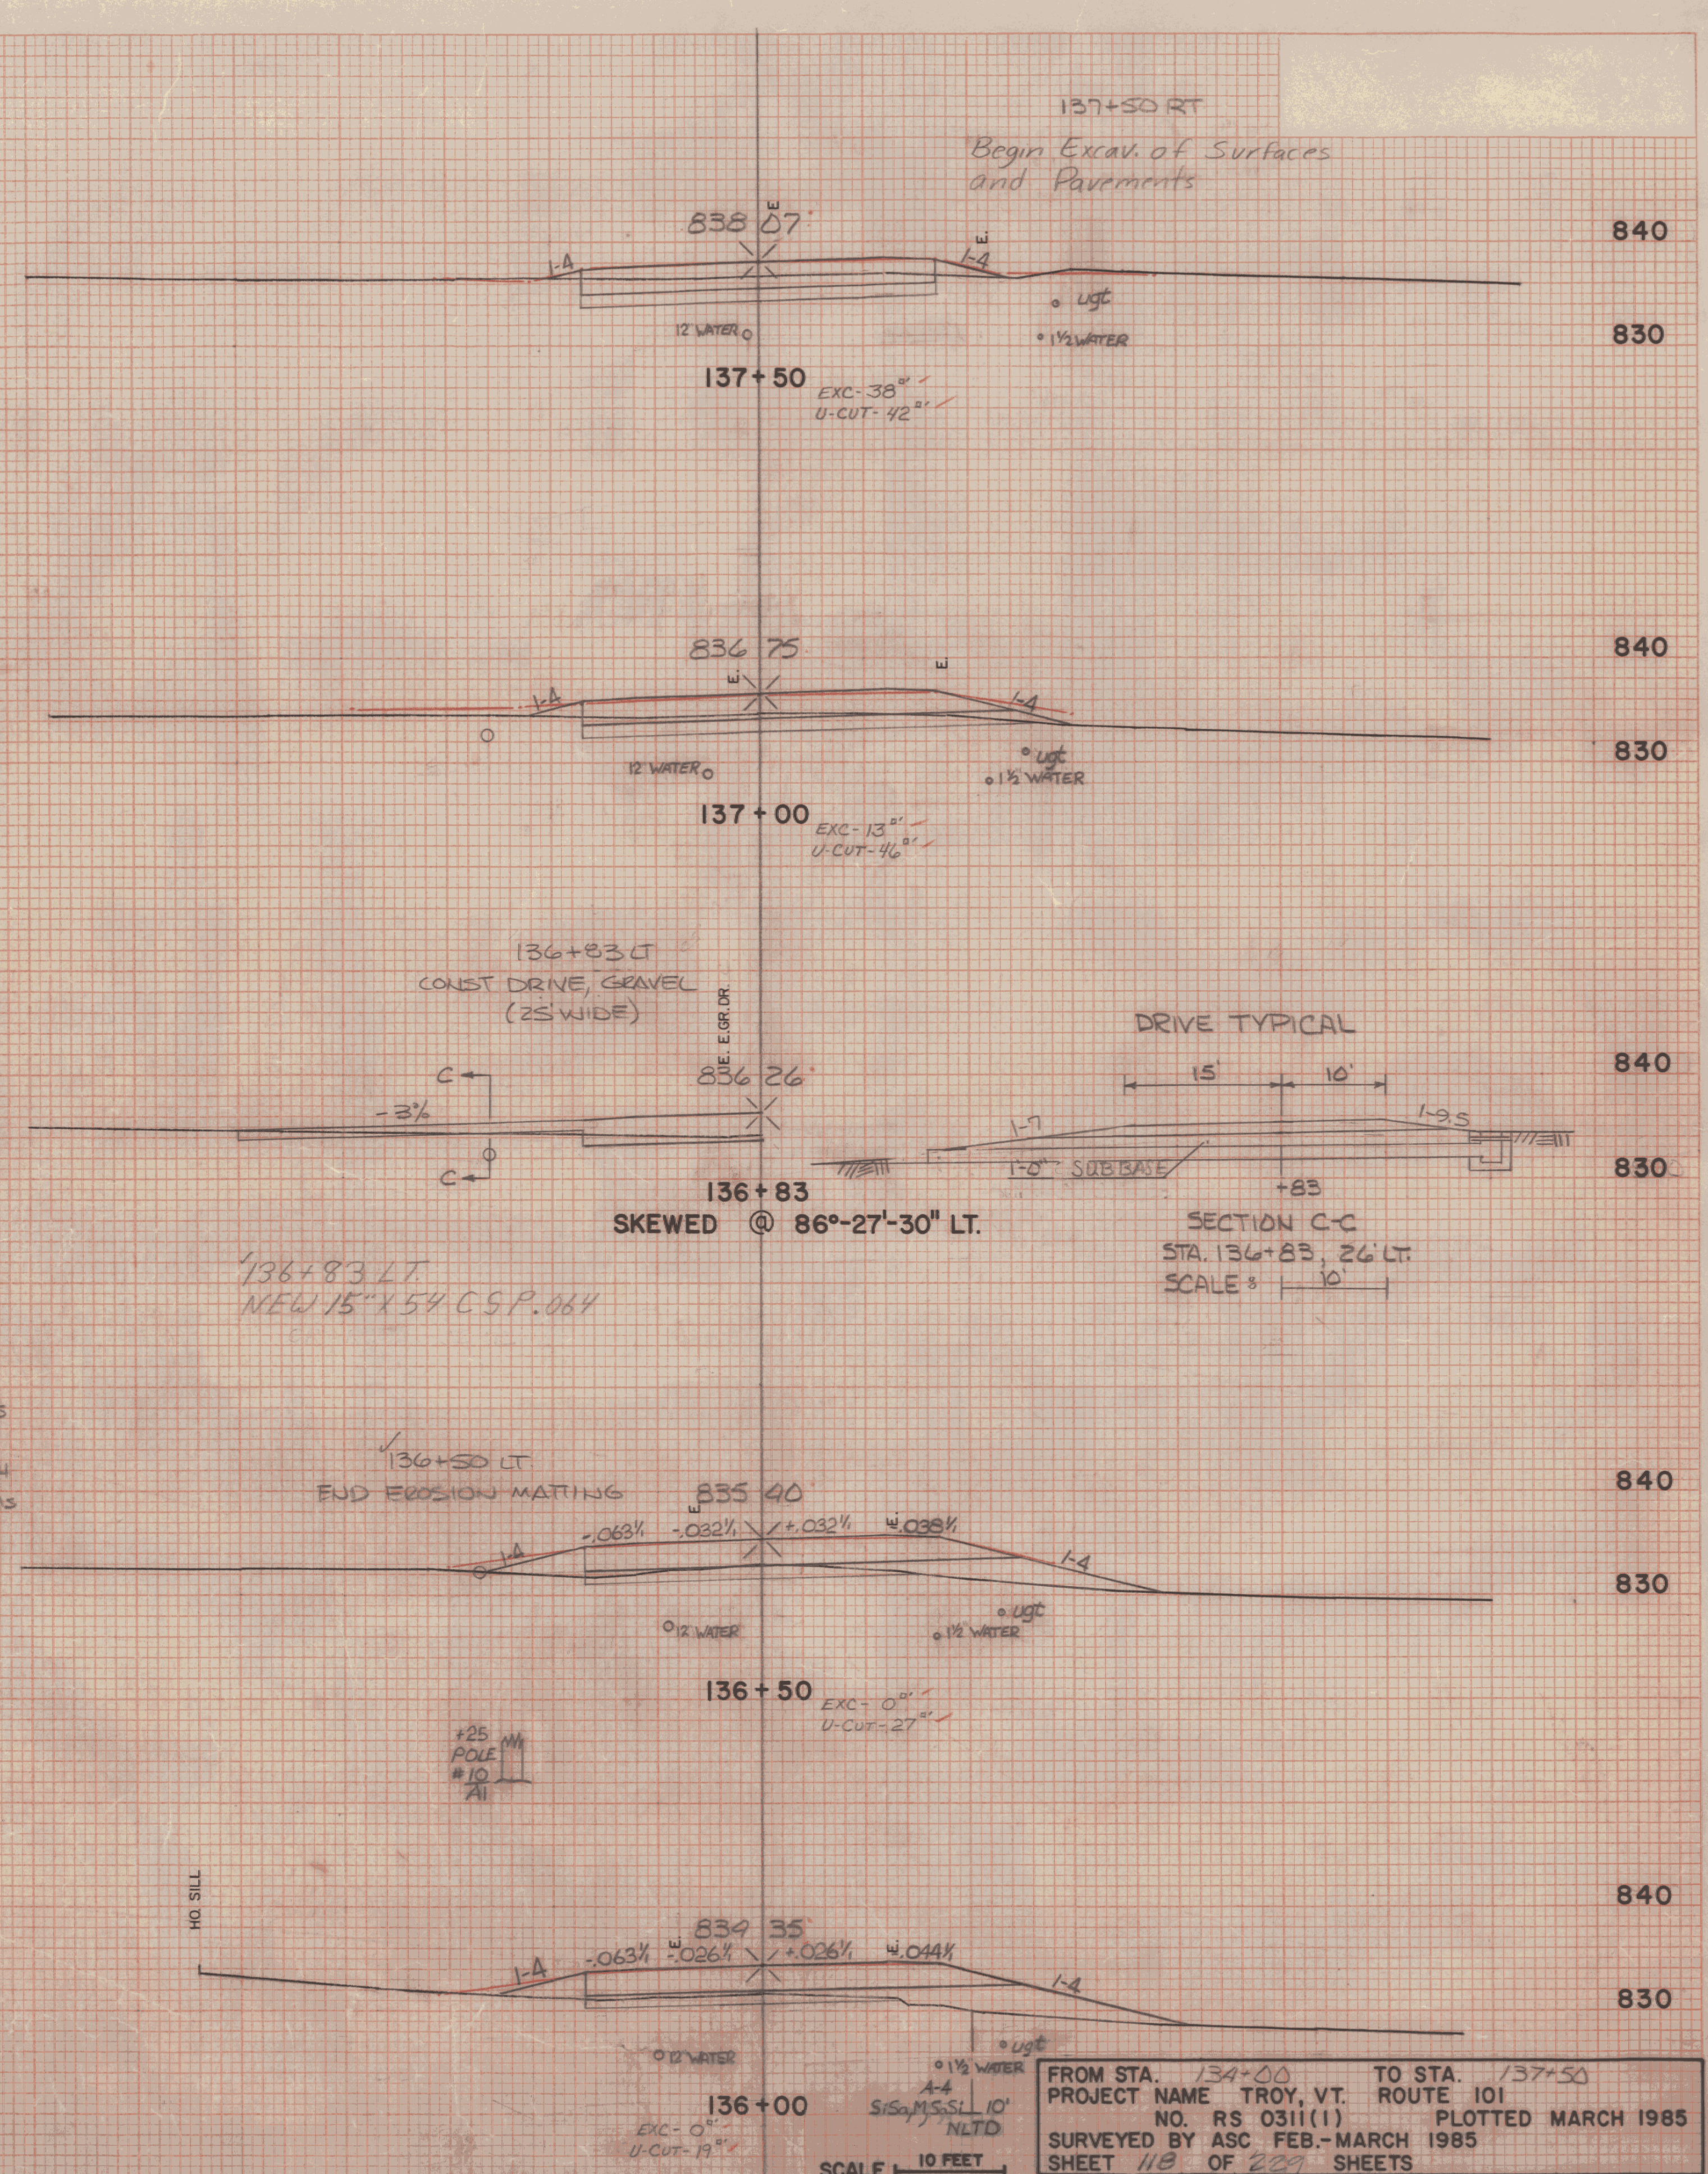


DATE	BY
SURVEYED	PLANNED
NOTED	NOTED
NO.	NO.

DATE	BY
SURVEYED	PLANNED
NOTED	NOTED
NO.	NO.

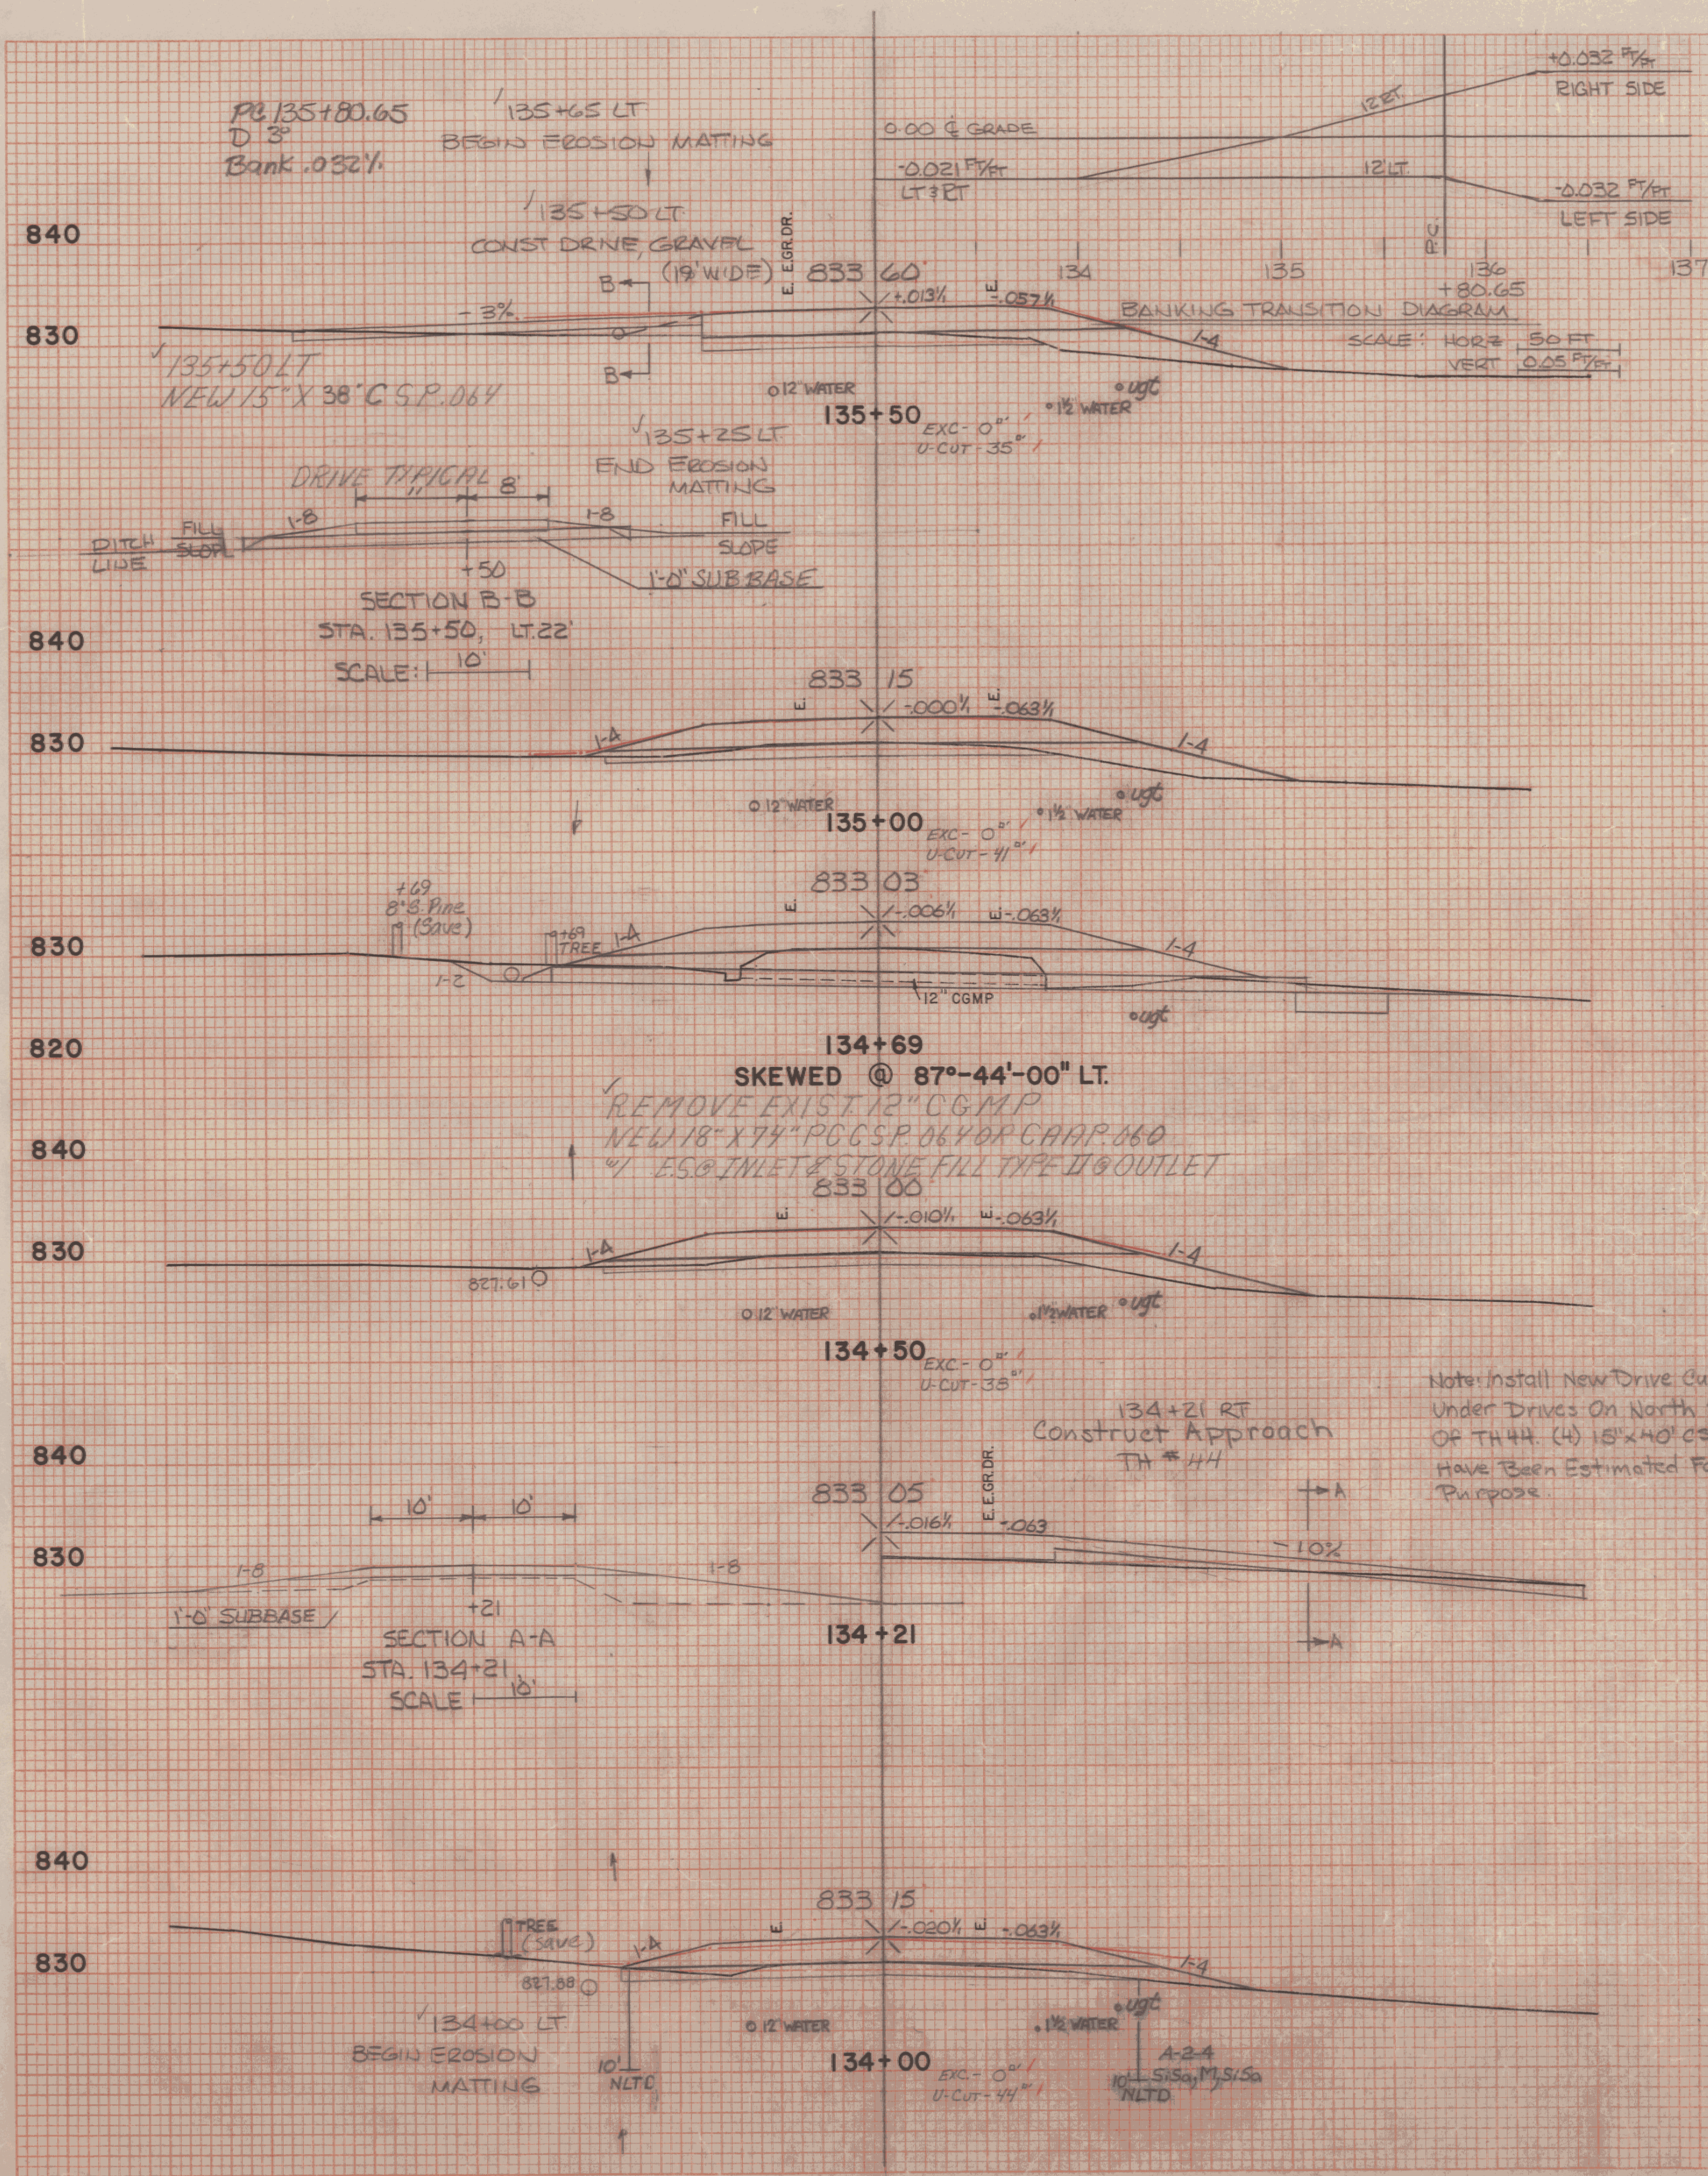

FROM STA. 134+00 TO STA. 137+50
PROJECT NAME TROY, VT. ROUTE 101
NO. RS 0311(1) PLOTTED MARCH 1985
SURVEYED BY ASC FEB.-MARCH 1985
SHEET 118 OF 229 SHEETS