


FINAL SURVEY PLOTTED DATE
 SURVEYED BY
 NOTE BOOK NO.
 AREAS CHECKED

ORIGINAL SURVEY PLOTTED DATE
 SURVEYED BY
 NOTE BOOK NO.
 AREAS CHECKED

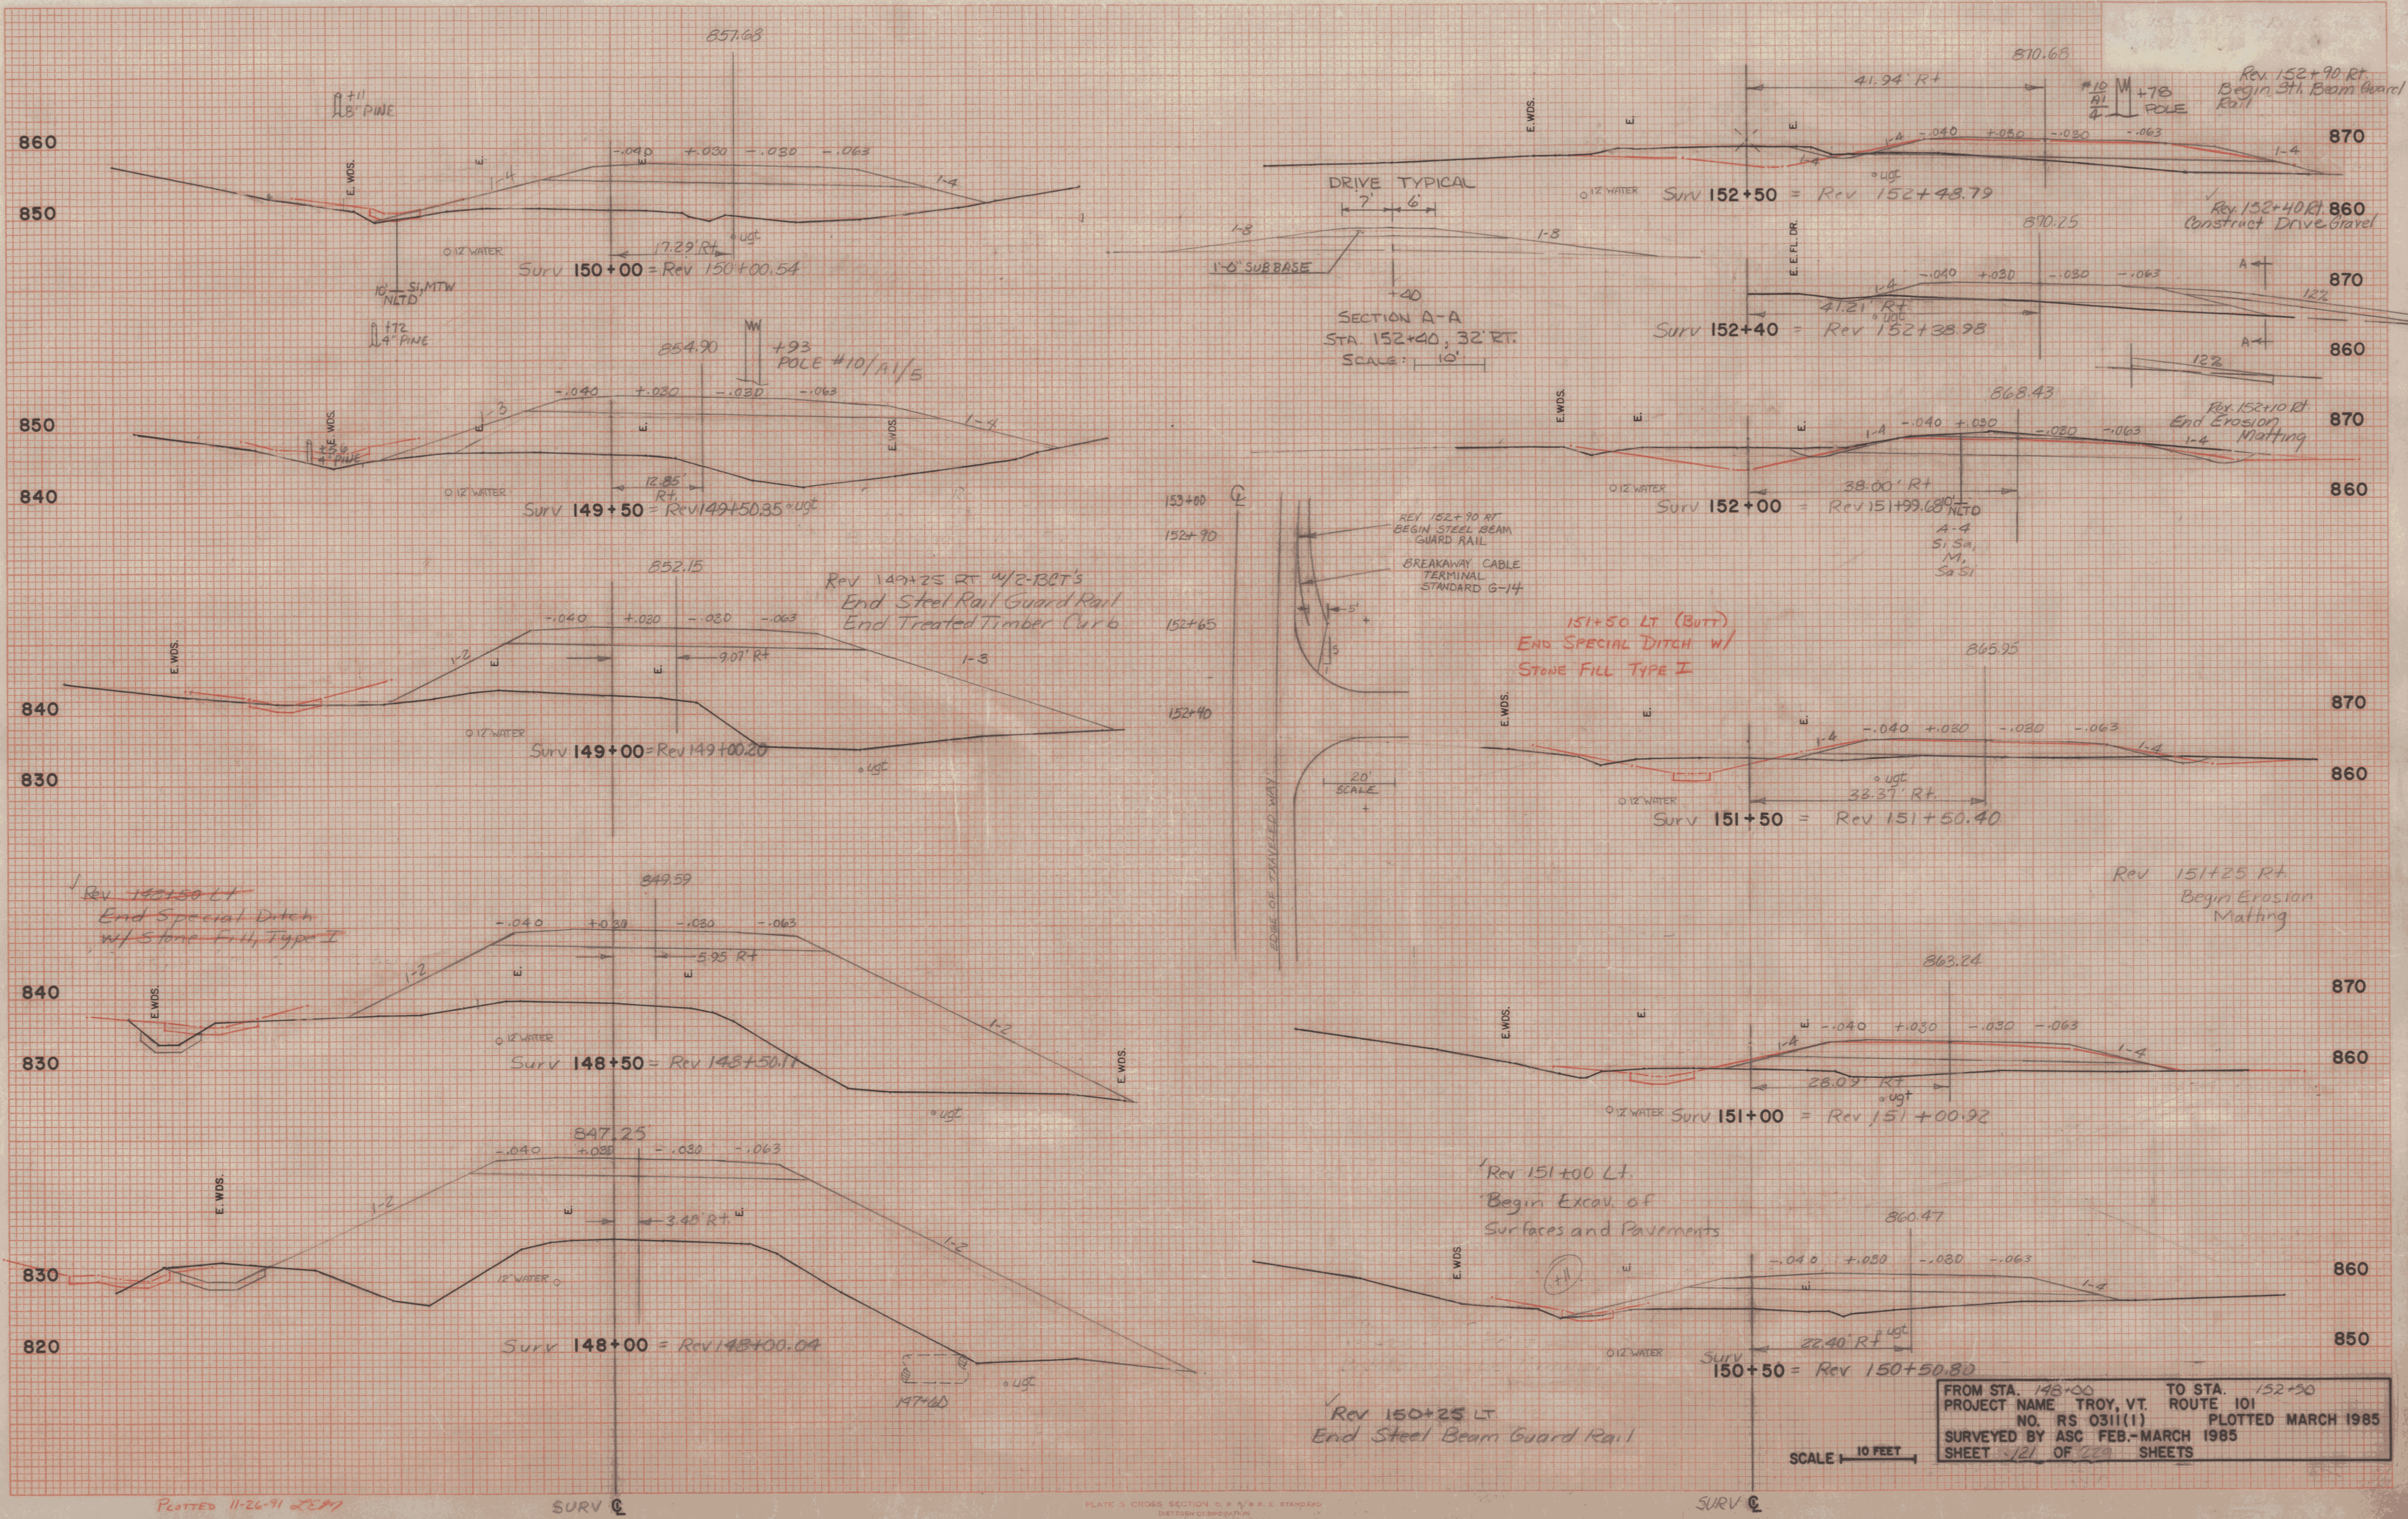

Plotted 11-26-91 ZEP

SURV C

PLATE 3 CROSS SECTION C * 1/8" = 1' STAIRS
 DET. FOR CROSS SECTION

SURV C

SCALE 1" = 10 FEET

FROM STA. 148+00 TO STA. 152+00
 PROJECT NAME TROY, VT. ROUTE 101
 NO. RS 0311(1) PLOTTED MARCH 1985
 SURVEYED BY ASC FEB.-MARCH 1985
 SHEET 121 OF 229 SHEETS