


DATE _____ BY _____
 ORIGINAL SURVEY PLOTTING TEMPLATE AREA CHECKED
 FINAL SURVEY PLOTTING TEMPLATE AREA CHECKED
 NO. _____

DATE _____ BY _____
 ORIGINAL SURVEY PLOTTING TEMPLATE AREA CHECKED
 FINAL SURVEY PLOTTING TEMPLATE AREA CHECKED
 NO. _____

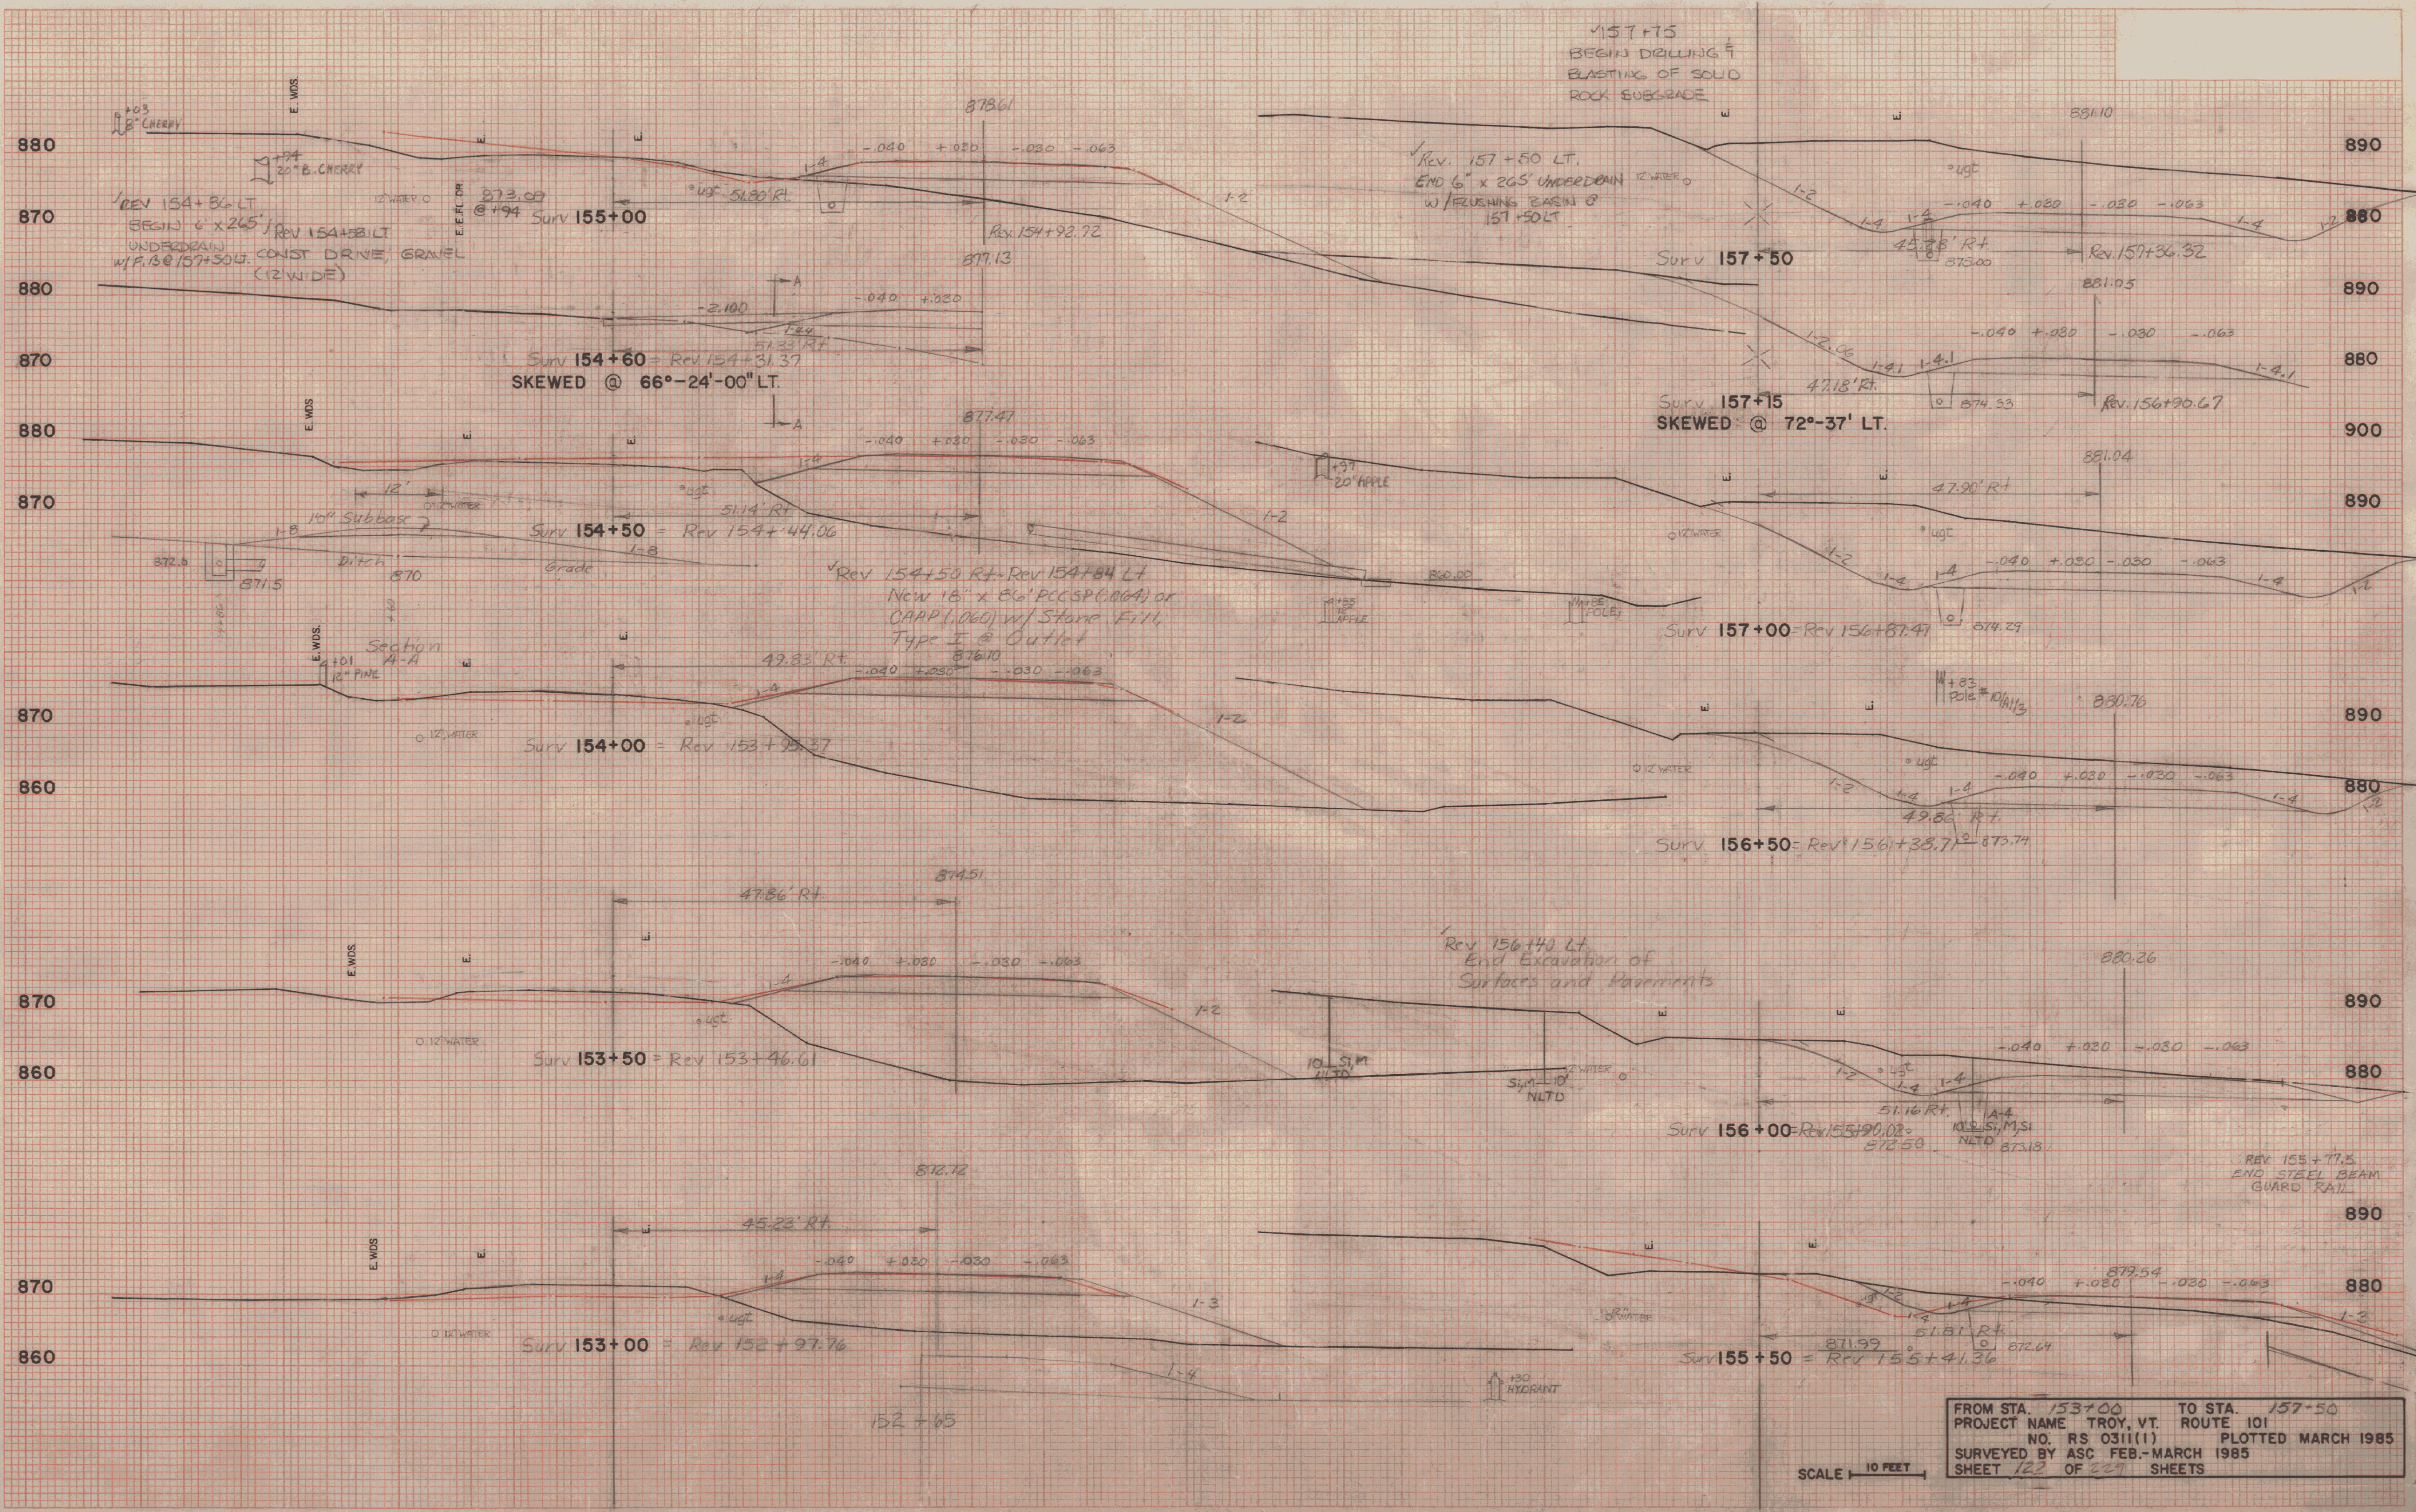

FROM STA. 153+00 TO STA. 157+50
 PROJECT NAME TROY, VT. ROUTE 101
 NO. RS 0311(1) PLOTTED MARCH 1985
 SURVEYED BY ASC FEB.-MARCH 1985
 SHEET 122 OF 229 SHEETS

SCALE 10 FEET

SURV C

SURV C

PLATE 3 CROSS SECTION - P.E. & S. STANDARD
 (SEE INSTRUCTIONS)