
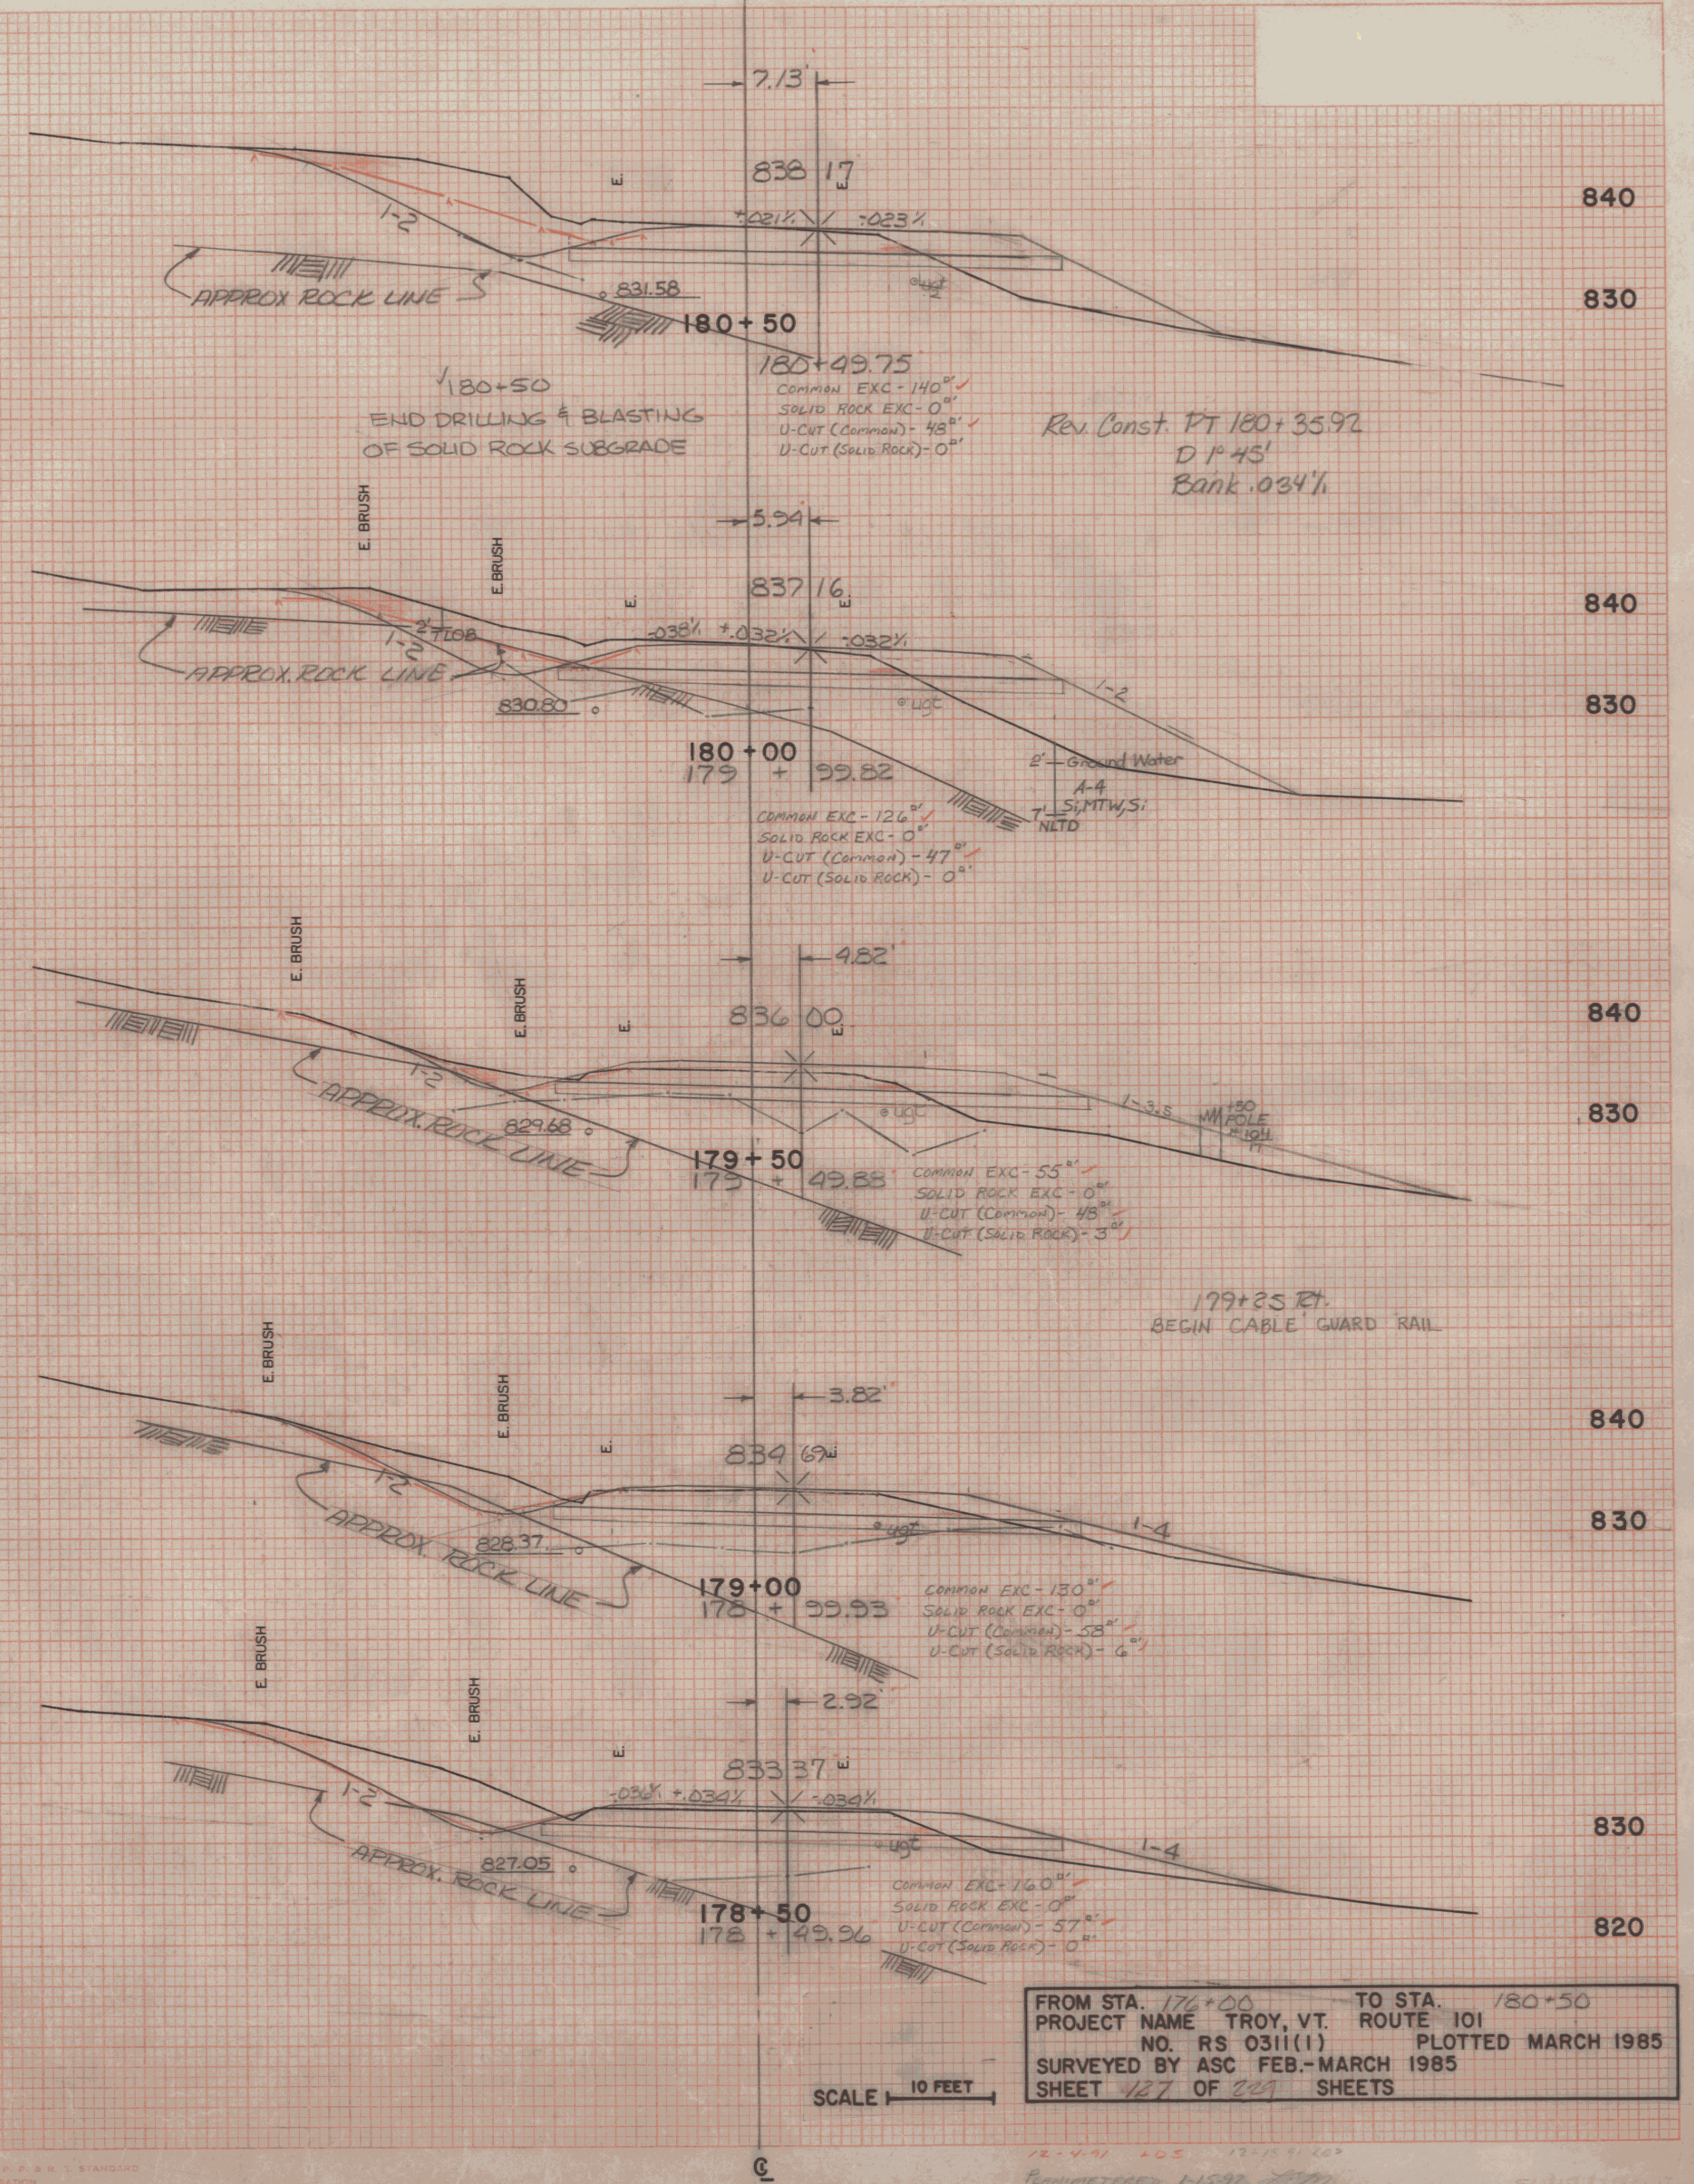


DATE: \_\_\_\_\_ BY: \_\_\_\_\_  
 SURVEYED: \_\_\_\_\_ PLOTTED: \_\_\_\_\_  
 ORIGINAL SURVEY: \_\_\_\_\_ TEMPLATE: \_\_\_\_\_  
 NOTE BOOK: \_\_\_\_\_ AREAS CHECKED: \_\_\_\_\_  
 NO. \_\_\_\_\_

DATE: \_\_\_\_\_ BY: \_\_\_\_\_  
 SURVEYED: \_\_\_\_\_ PLOTTED: \_\_\_\_\_  
 ORIGINAL SURVEY: \_\_\_\_\_ TEMPLATE: \_\_\_\_\_  
 NOTE BOOK: \_\_\_\_\_ AREAS CHECKED: \_\_\_\_\_  
 NO. \_\_\_\_\_

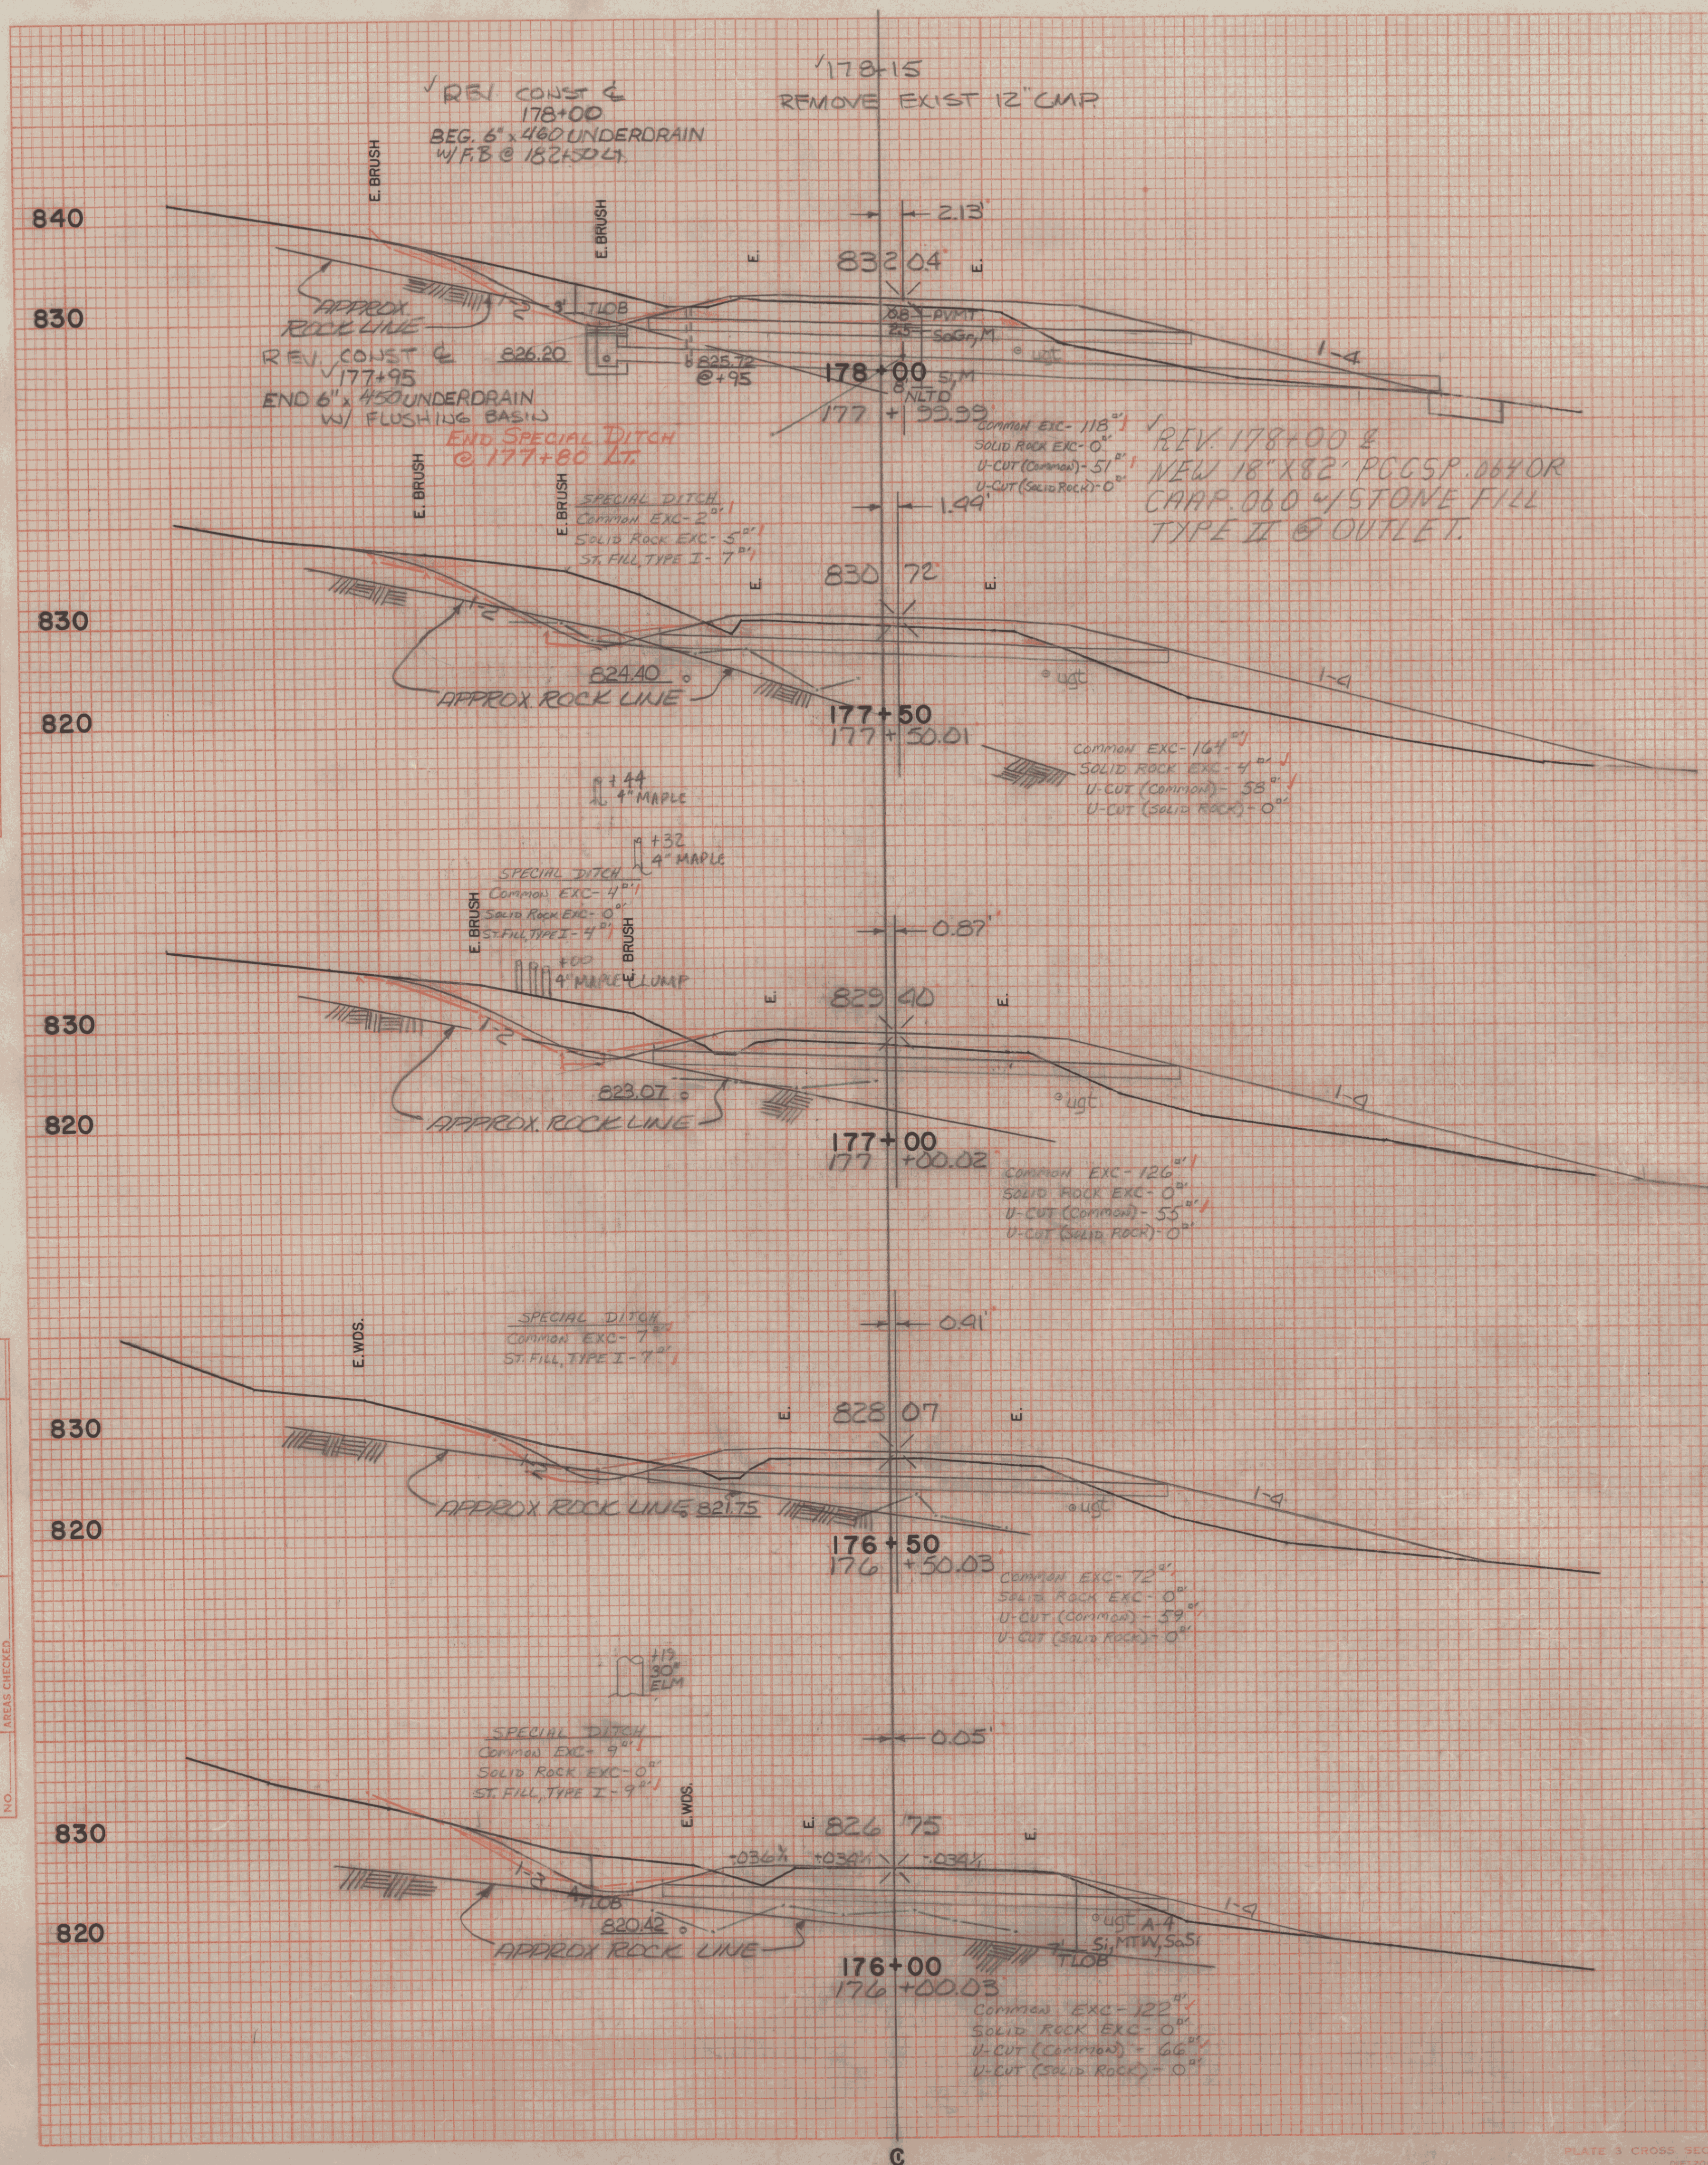

FROM STA. 176+00 TO STA. 180+50  
 PROJECT NAME TROY, VT. ROUTE 101  
 NO. RS 031(1) PLOTTED MARCH 1985  
 SURVEYED BY ASC FEB.-MARCH 1985  
 SHEET 127 OF 209 SHEETS

SCALE 10 FEET

12-4-91 LUS 12-11-91 LUS  
 PLAN 1-24-92 LTN