


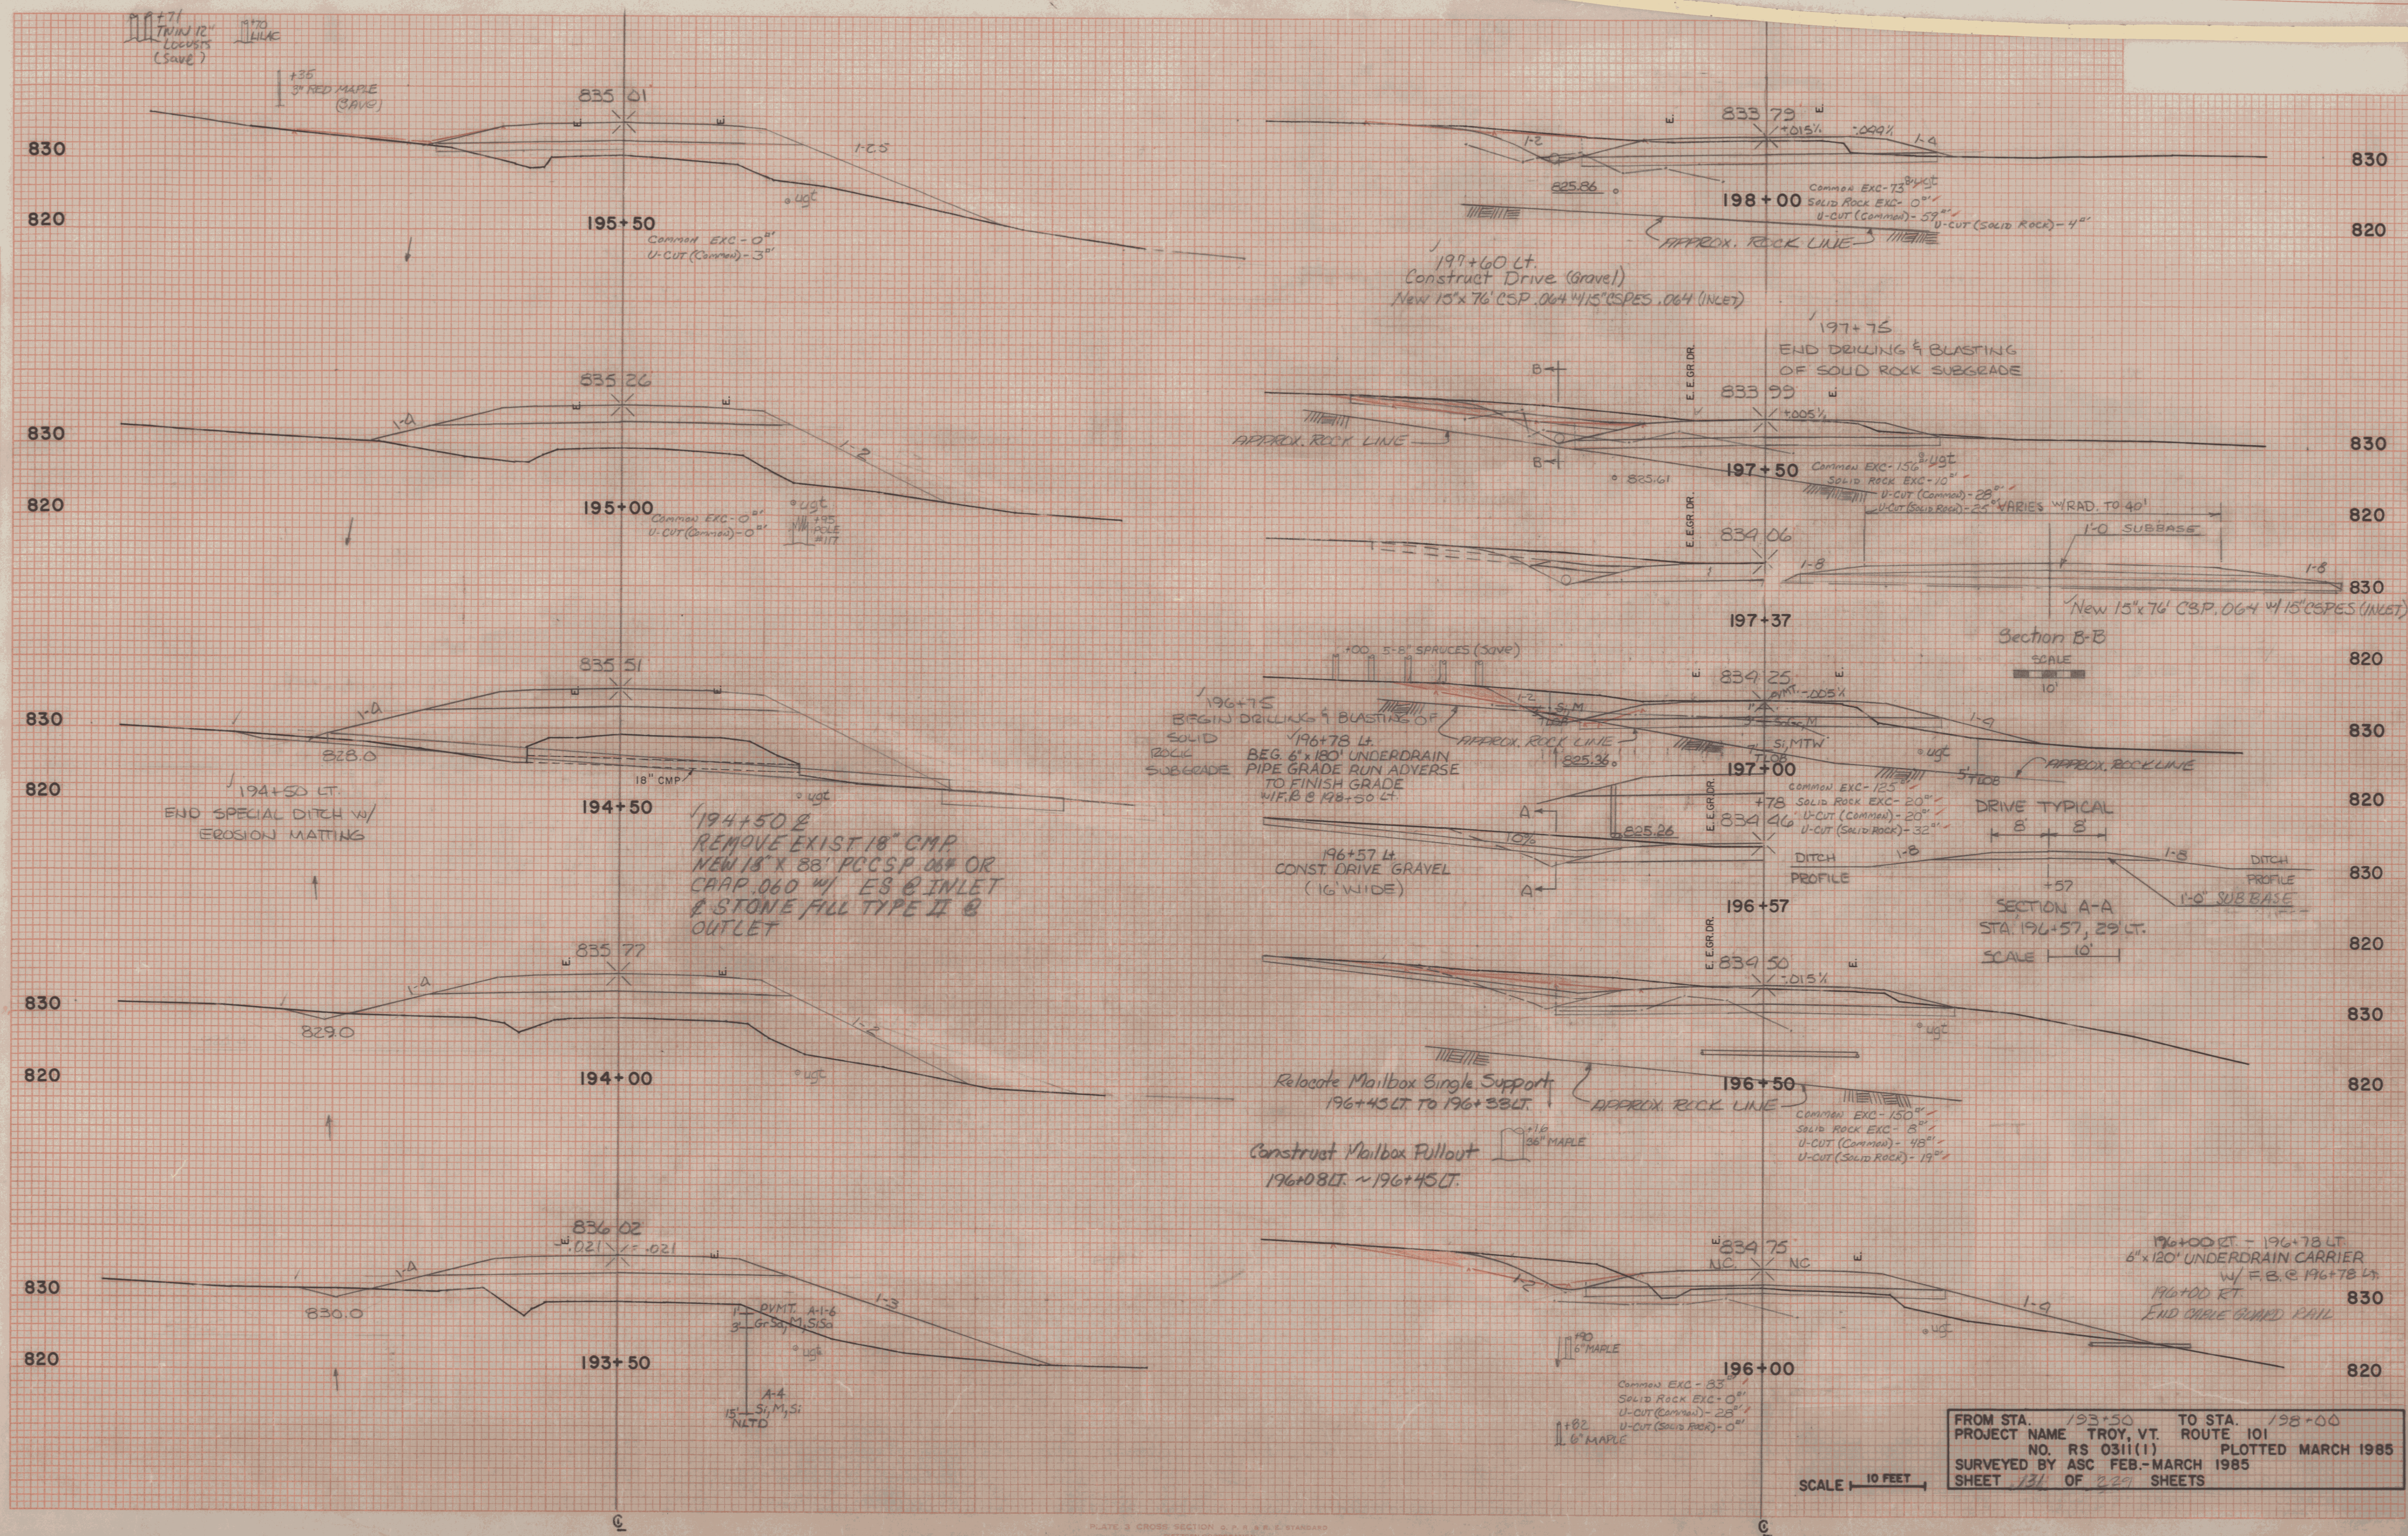

SCALE 1" = 10 FEET

FROM STA. 193+50 TO STA. 198+00
PROJECT NAME TROY, VT. ROUTE 101
NO. RS 0311(1) PLOTTED MARCH 1985
SURVEYED BY ASC FEB.-MARCH 1985
SHEET 131 OF 229 SHEETS