


DATE
BY
NO.
FINAL SURVEY PLOTTED
ROUTE BOOK NO. CHECKED
AREAS CHECKED

DATE
BY
NO.
ORIGINAL SURVEY PLOTTED
ROUTE BOOK NO. CHECKED
AREAS CHECKED

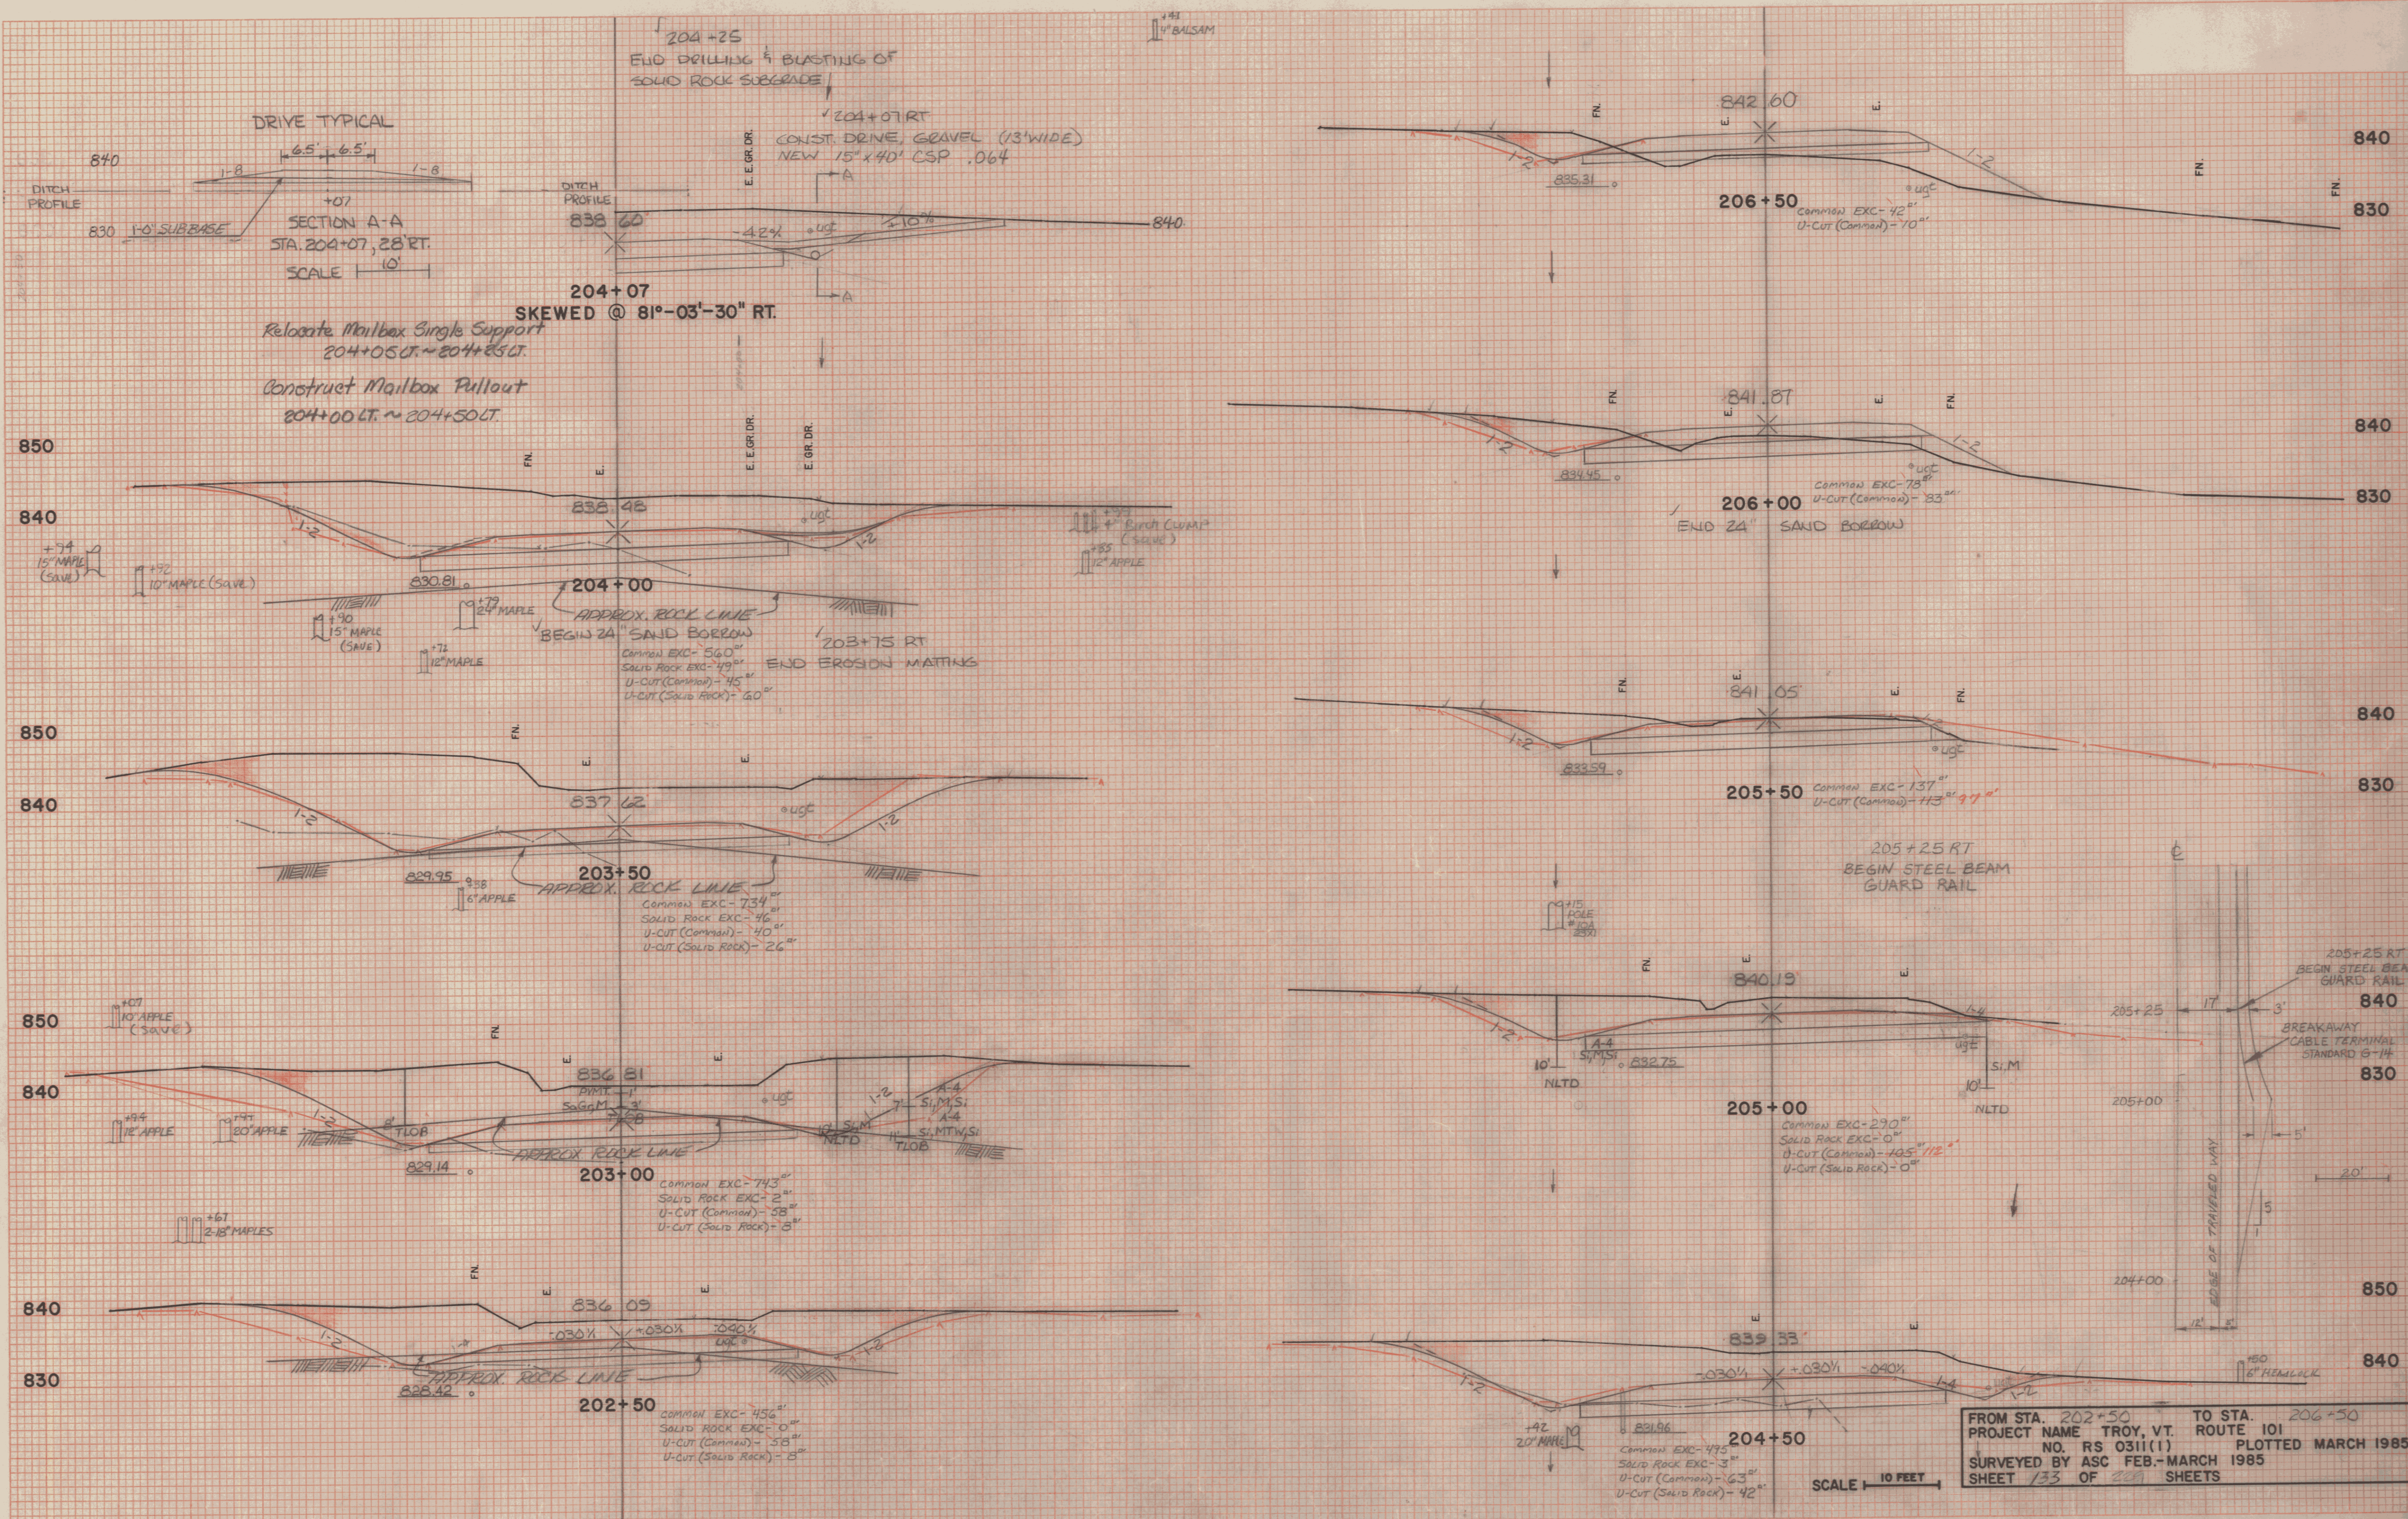

FROM STA. 202+50 TO STA. 206+50
PROJECT NAME TROY, VT. ROUTE 101
NO. RS 0311(1) PLOTTED MARCH 1985
SURVEYED BY ASC FEB.-MARCH 1985
SHEET 133 OF 209 SHEETS

SCALE 10 FEET

PLANIMETERED 1-21-92
PLOT - 3-31-92

16 33