


FINAL SURVEY PLOTTED, NOTE BOOK AREAS CHECKED.

ORIGINAL SURVEY PLOTTED, NOTE BOOK AREAS CHECKED.

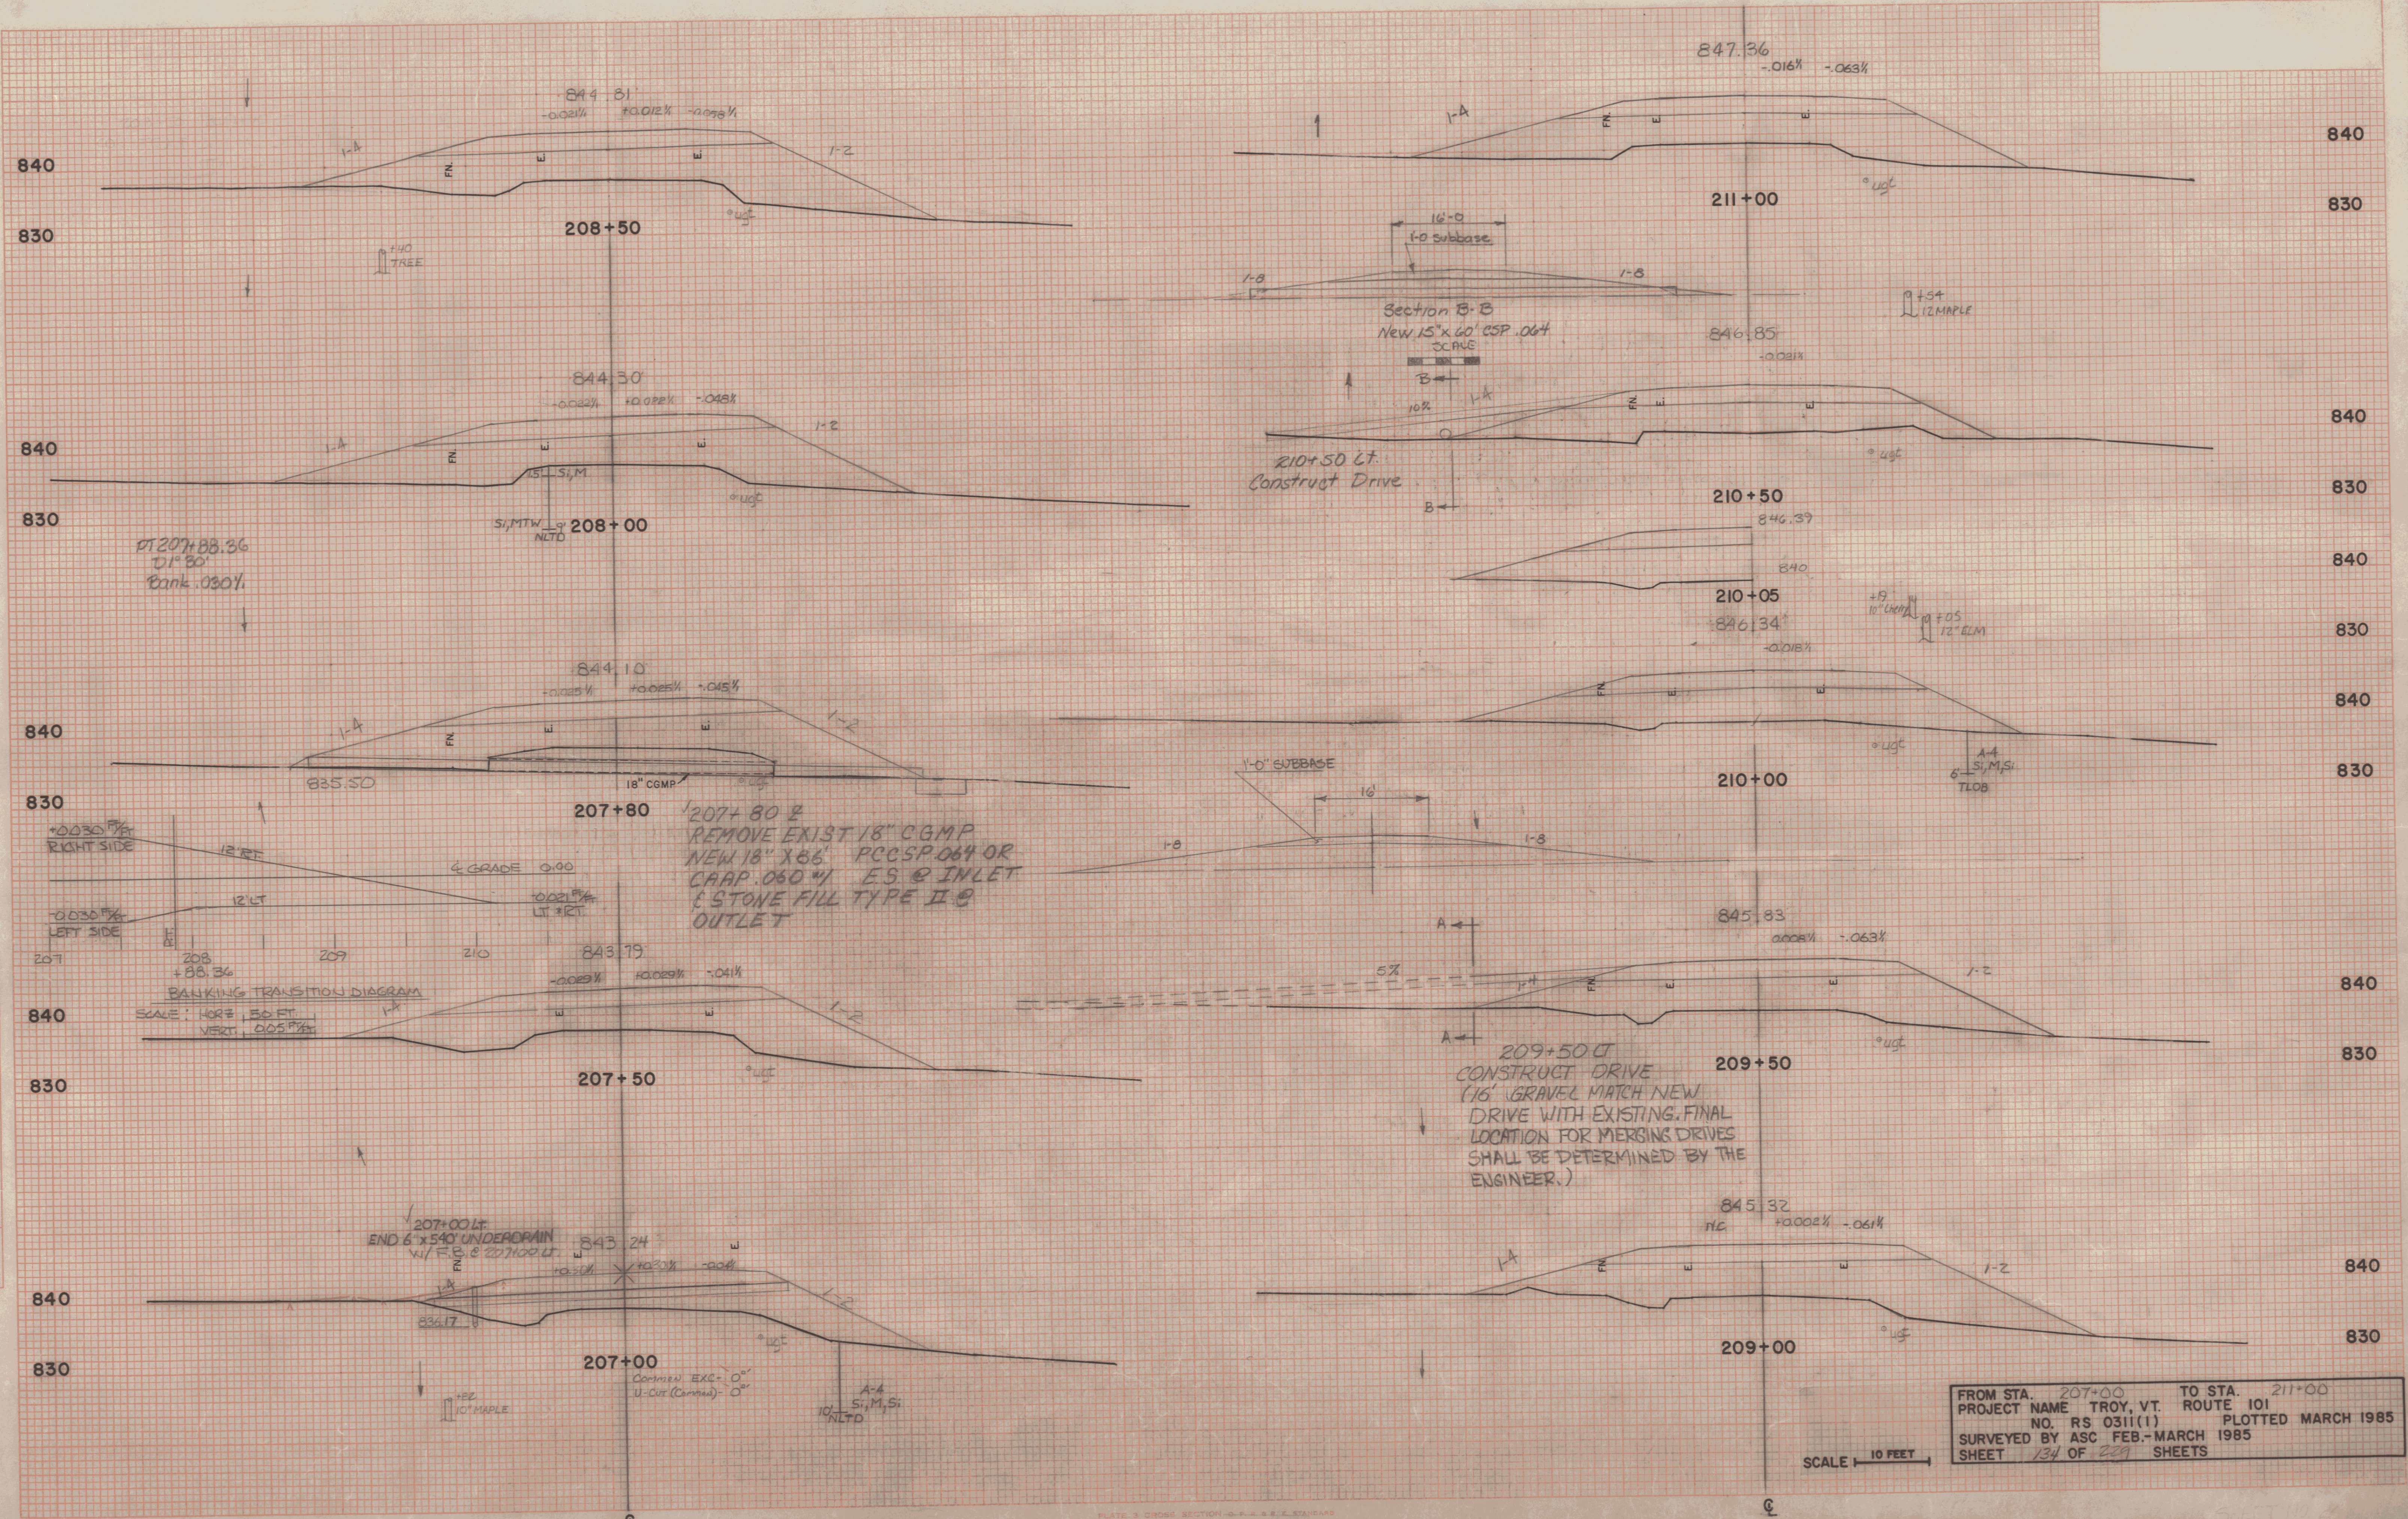

FROM STA. 207+00 TO STA. 211+00
 PROJECT NAME TROY, VT. ROUTE 101
 NO. RS 0311(1) PLOTTED MARCH 1985
 SURVEYED BY ASC FEB.-MARCH 1985
 SHEET 134 OF 229 SHEETS

SCALE 1" = 10 FEET

PLATE 3 CROSS SECTION - A.A. & E.E. STANDARD
 DETAGAN CORPORATION

DATE OF TIP
 PLOT OF 200
 PLANNED 1-21-92
 PLAN - 3-31-92