
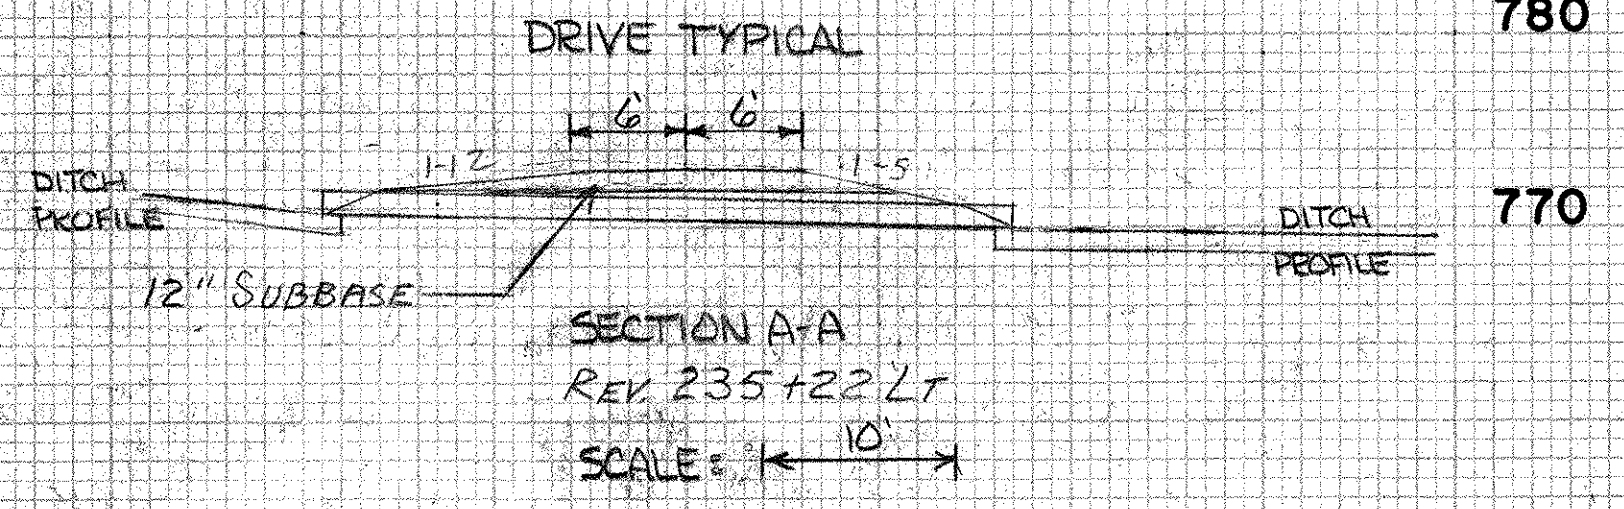


DATE	
BY	
NO.	
AREAS CHECKED	
PLATE	
DATE	
BY	
NO.	
AREAS CHECKED	
PLATE	
DATE	
BY	
NO.	
AREAS CHECKED	

DATE	
BY	
NO.	
AREAS CHECKED	
PLATE	
DATE	
BY	
NO.	
AREAS CHECKED	
PLATE	
DATE	
BY	
NO.	
AREAS CHECKED	

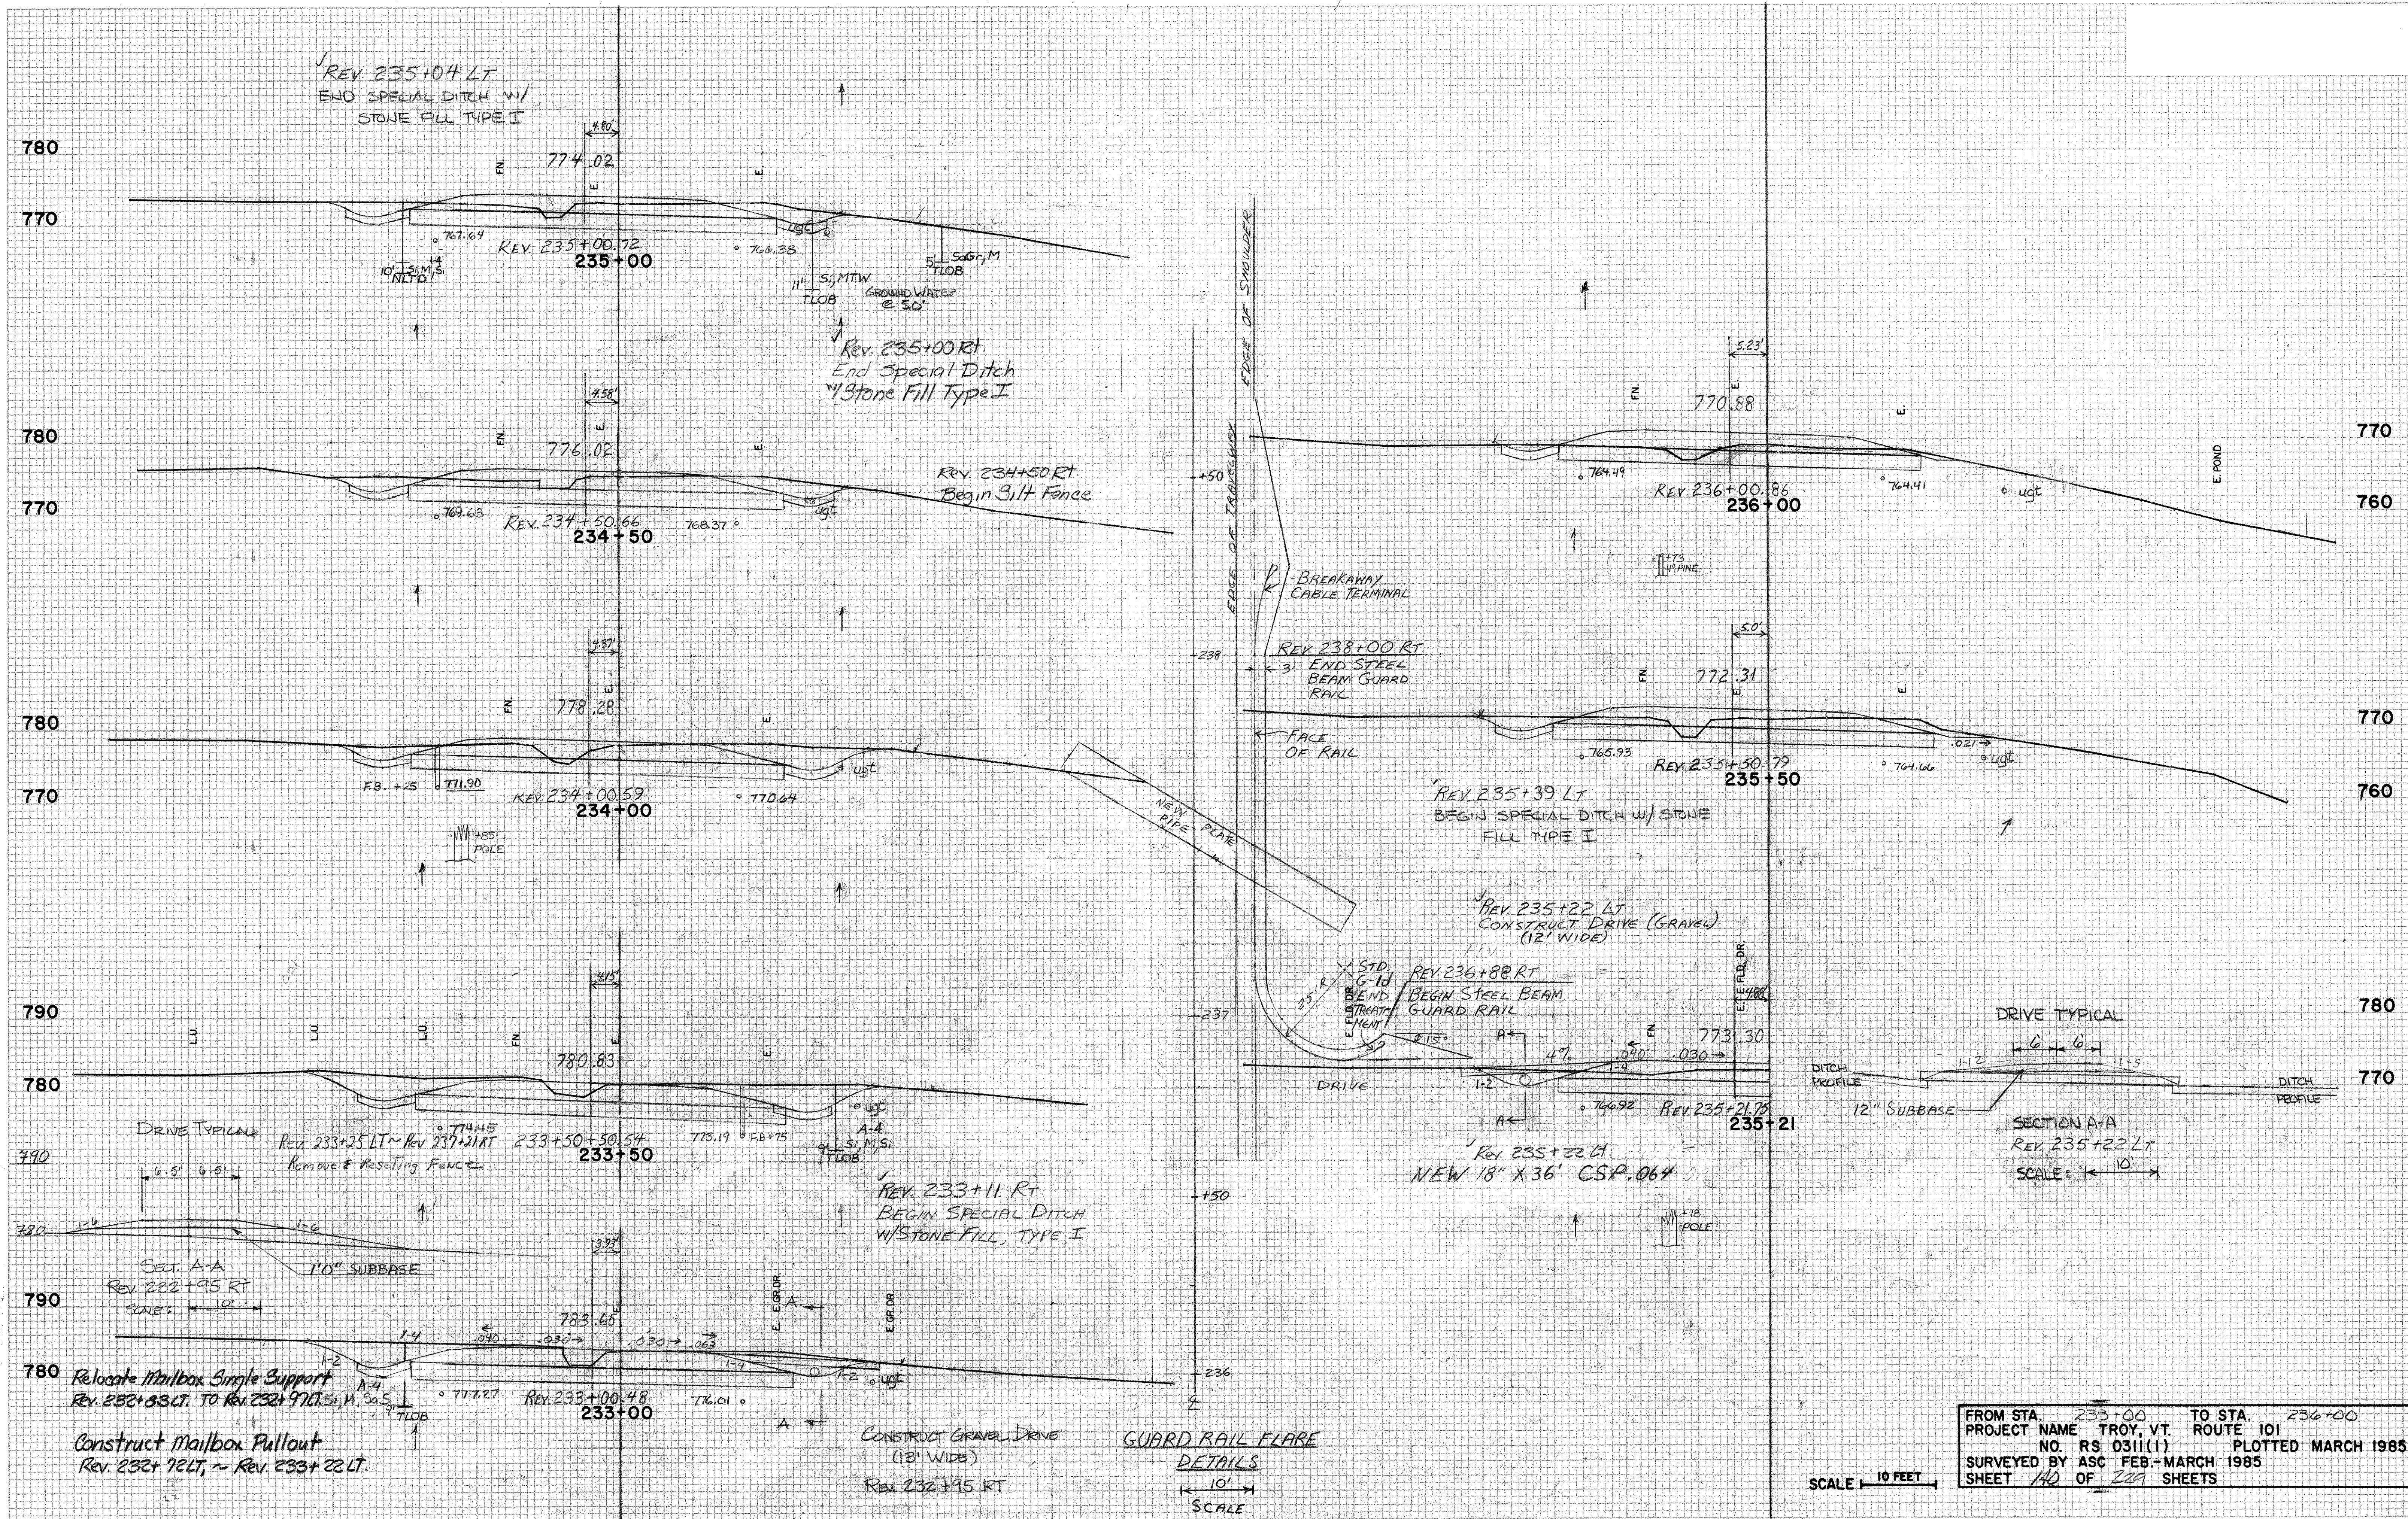

FROM STA. 235+00 TO STA. 236+00
 PROJECT NAME TROY, VT. ROUTE 101
 NO. RS 0311(1) PLOTTED MARCH 1985
 SURVEYED BY ASC FEB.-MARCH 1985
 SHEET 140 OF 221 SHEETS