


DATE	
BY	
NO.	
FINAL SURVEY	SURVEYED
NOTE BOOK	PLOTTED
NO.	TEMPLATE
	AREAS CHECKED

DATE	
BY	
NO.	
ORIGINAL SURVEY	SURVEYED
NOTE BOOK	PLOTTED
NO.	TEMPLATE
	AREAS CHECKED

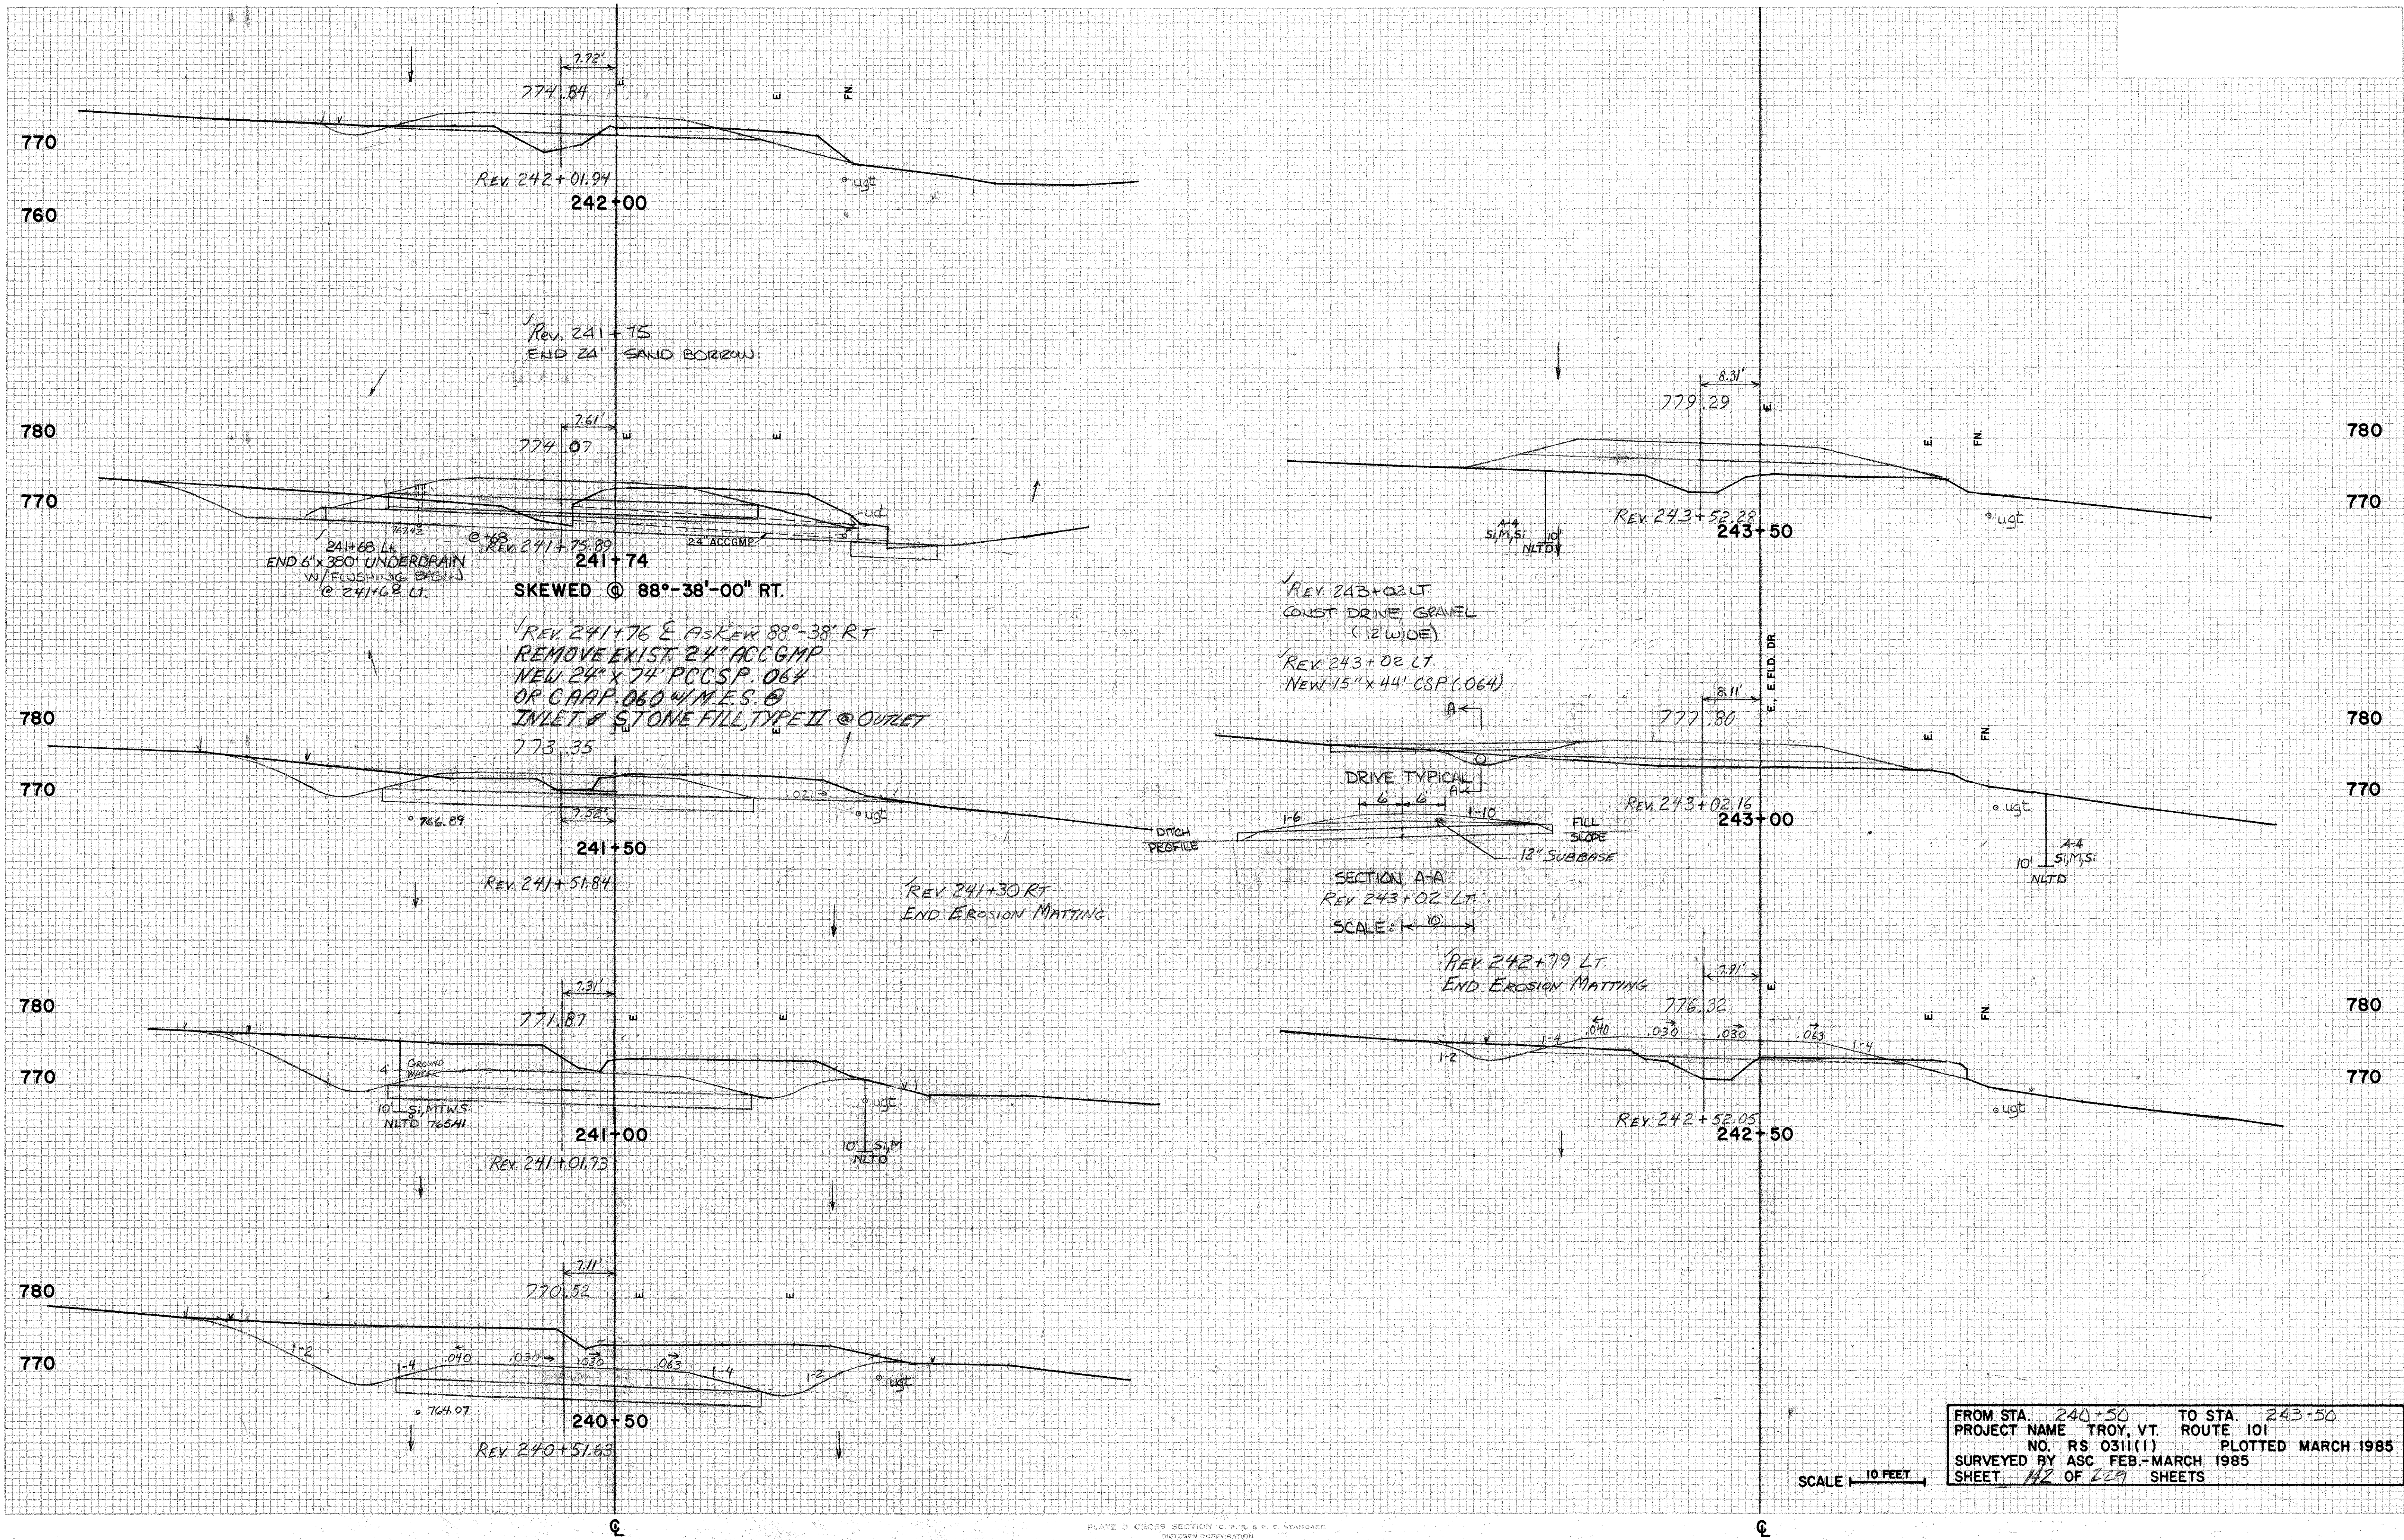

FROM STA. 240+50 TO STA. 243+50  
 PROJECT NAME TROY, VT. ROUTE 101  
 NO. RS 0311(1) PLOTTED MARCH 1985  
 SURVEYED BY ASC FEB.-MARCH 1985  
 SHEET 142 OF 229 SHEETS

SCALE 10 FEET