
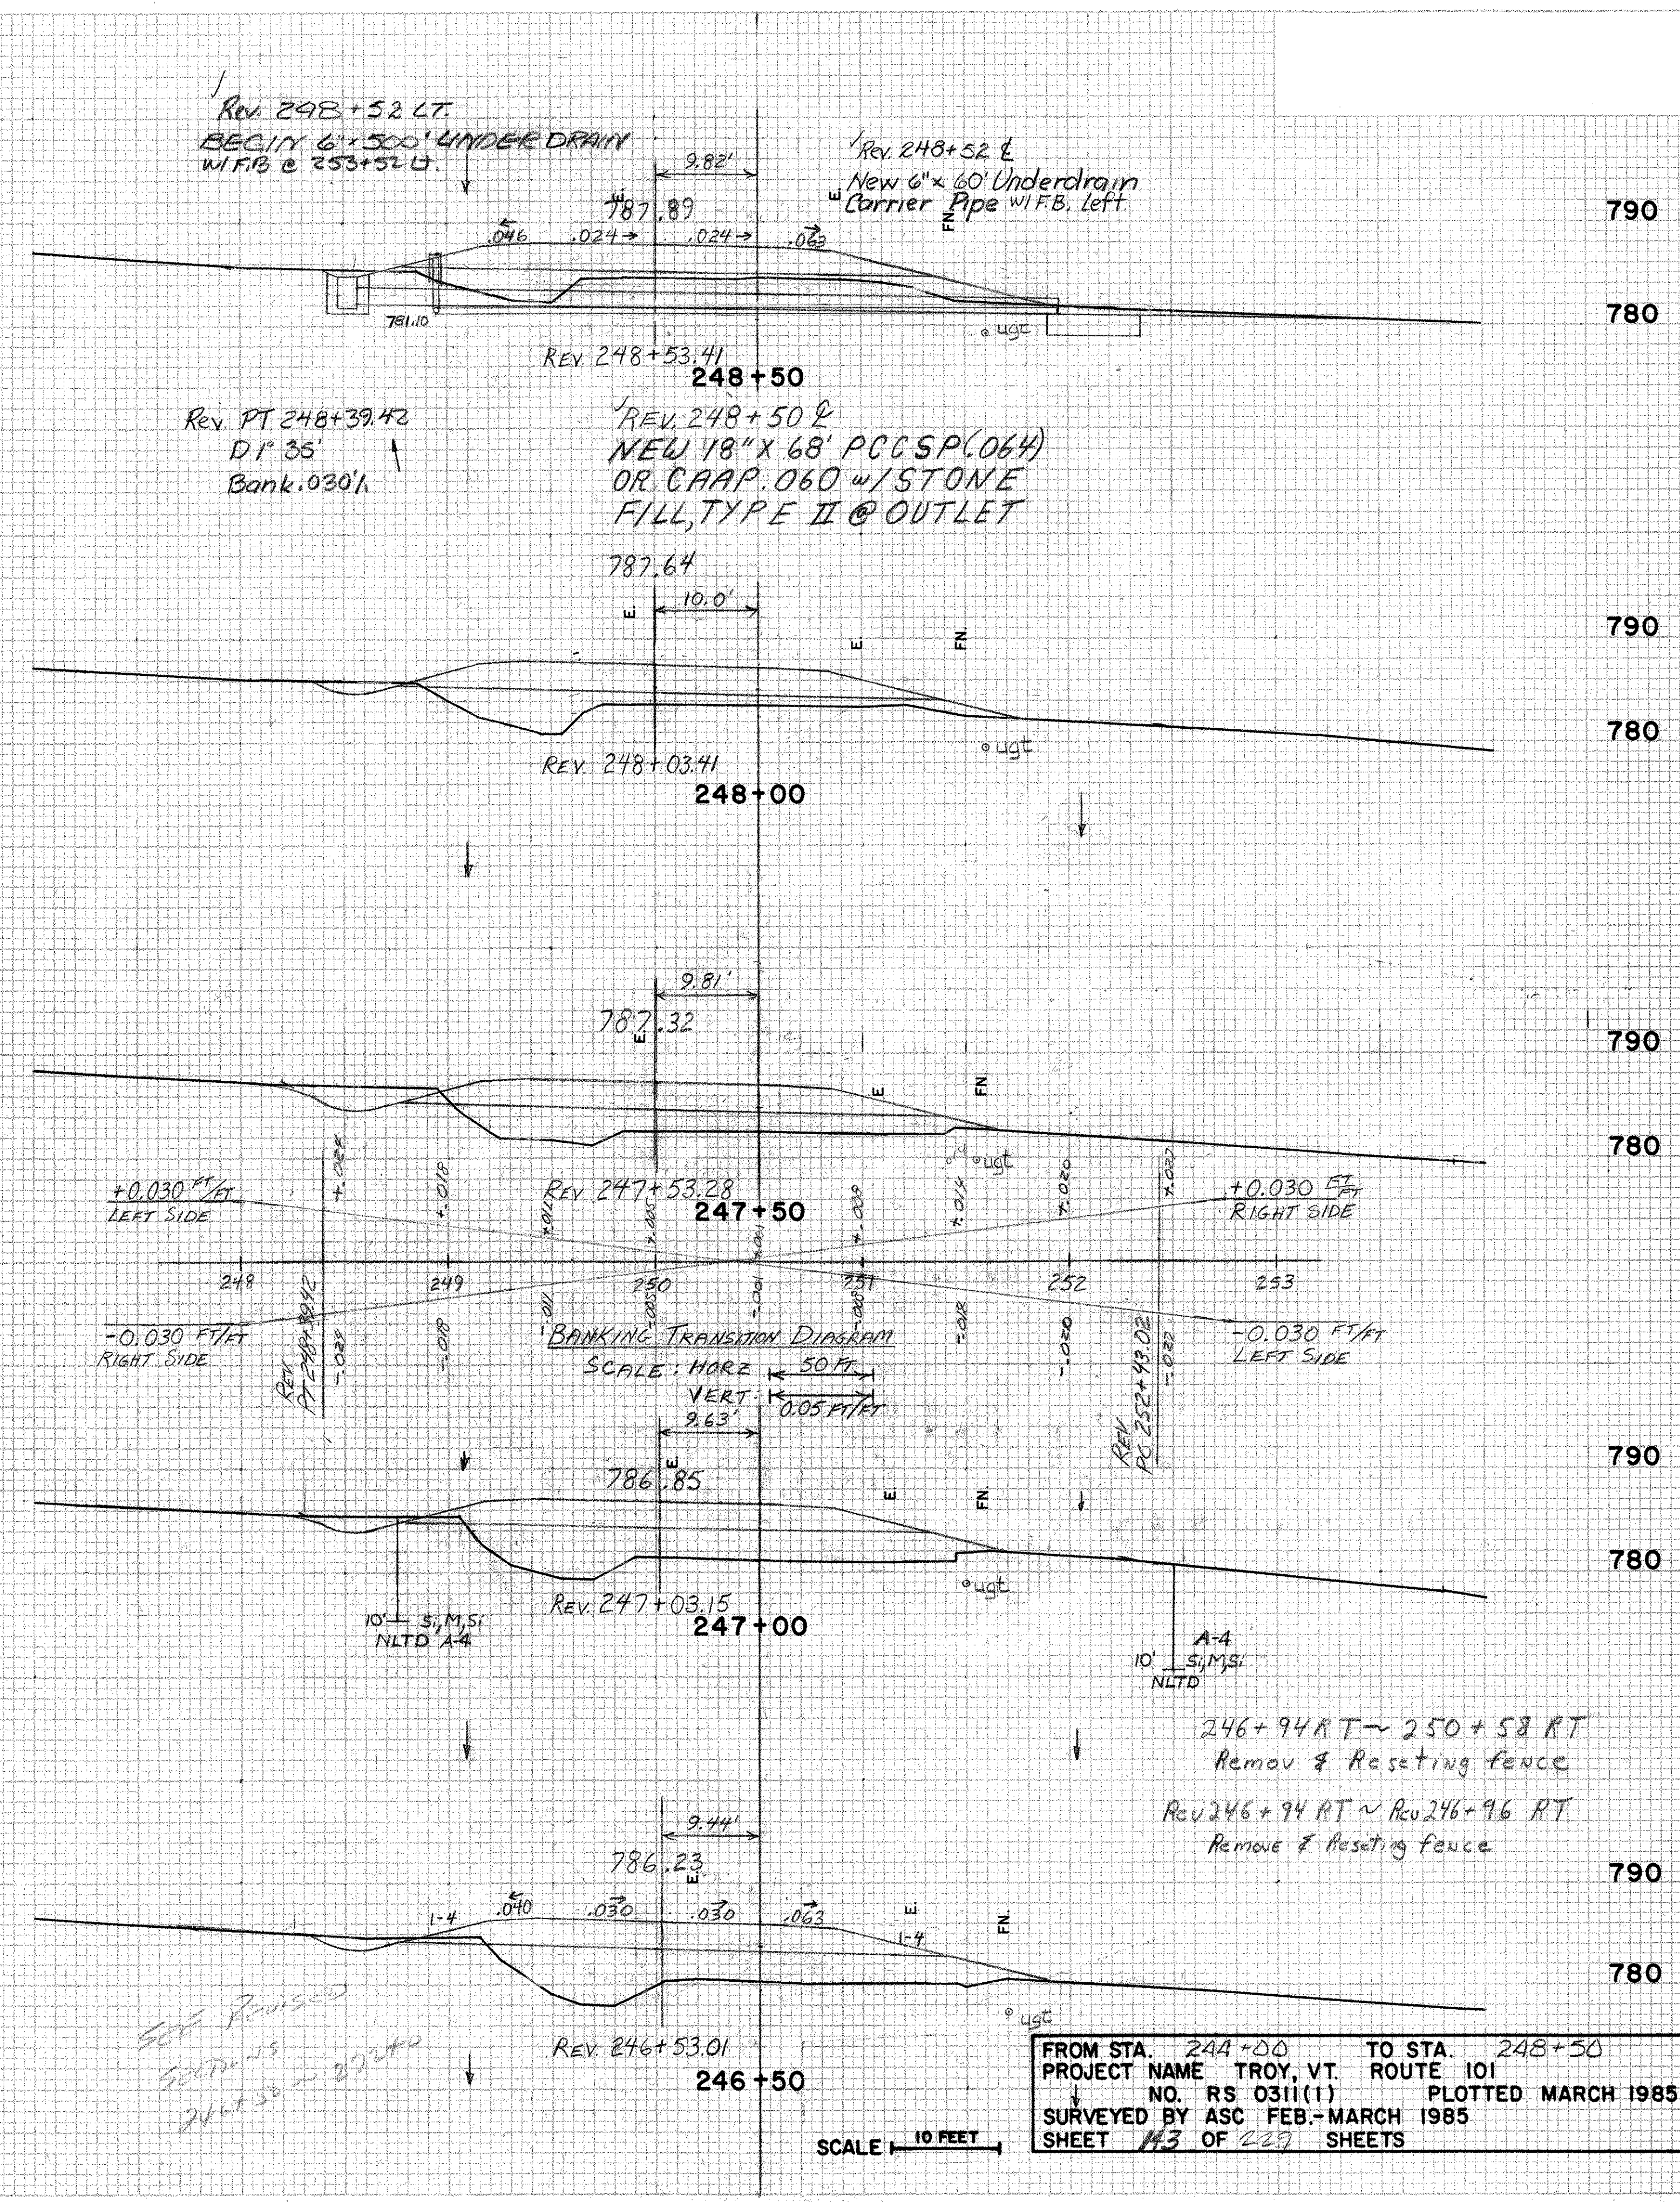


FINAL SURVEY
 SURVEYED, PLOTTED, NOTE BOOK NO., AREAS CHECKED.

ORIGINAL SURVEY
 SURVEYED, PLOTTED, NOTE BOOK NO., AREAS CHECKED.

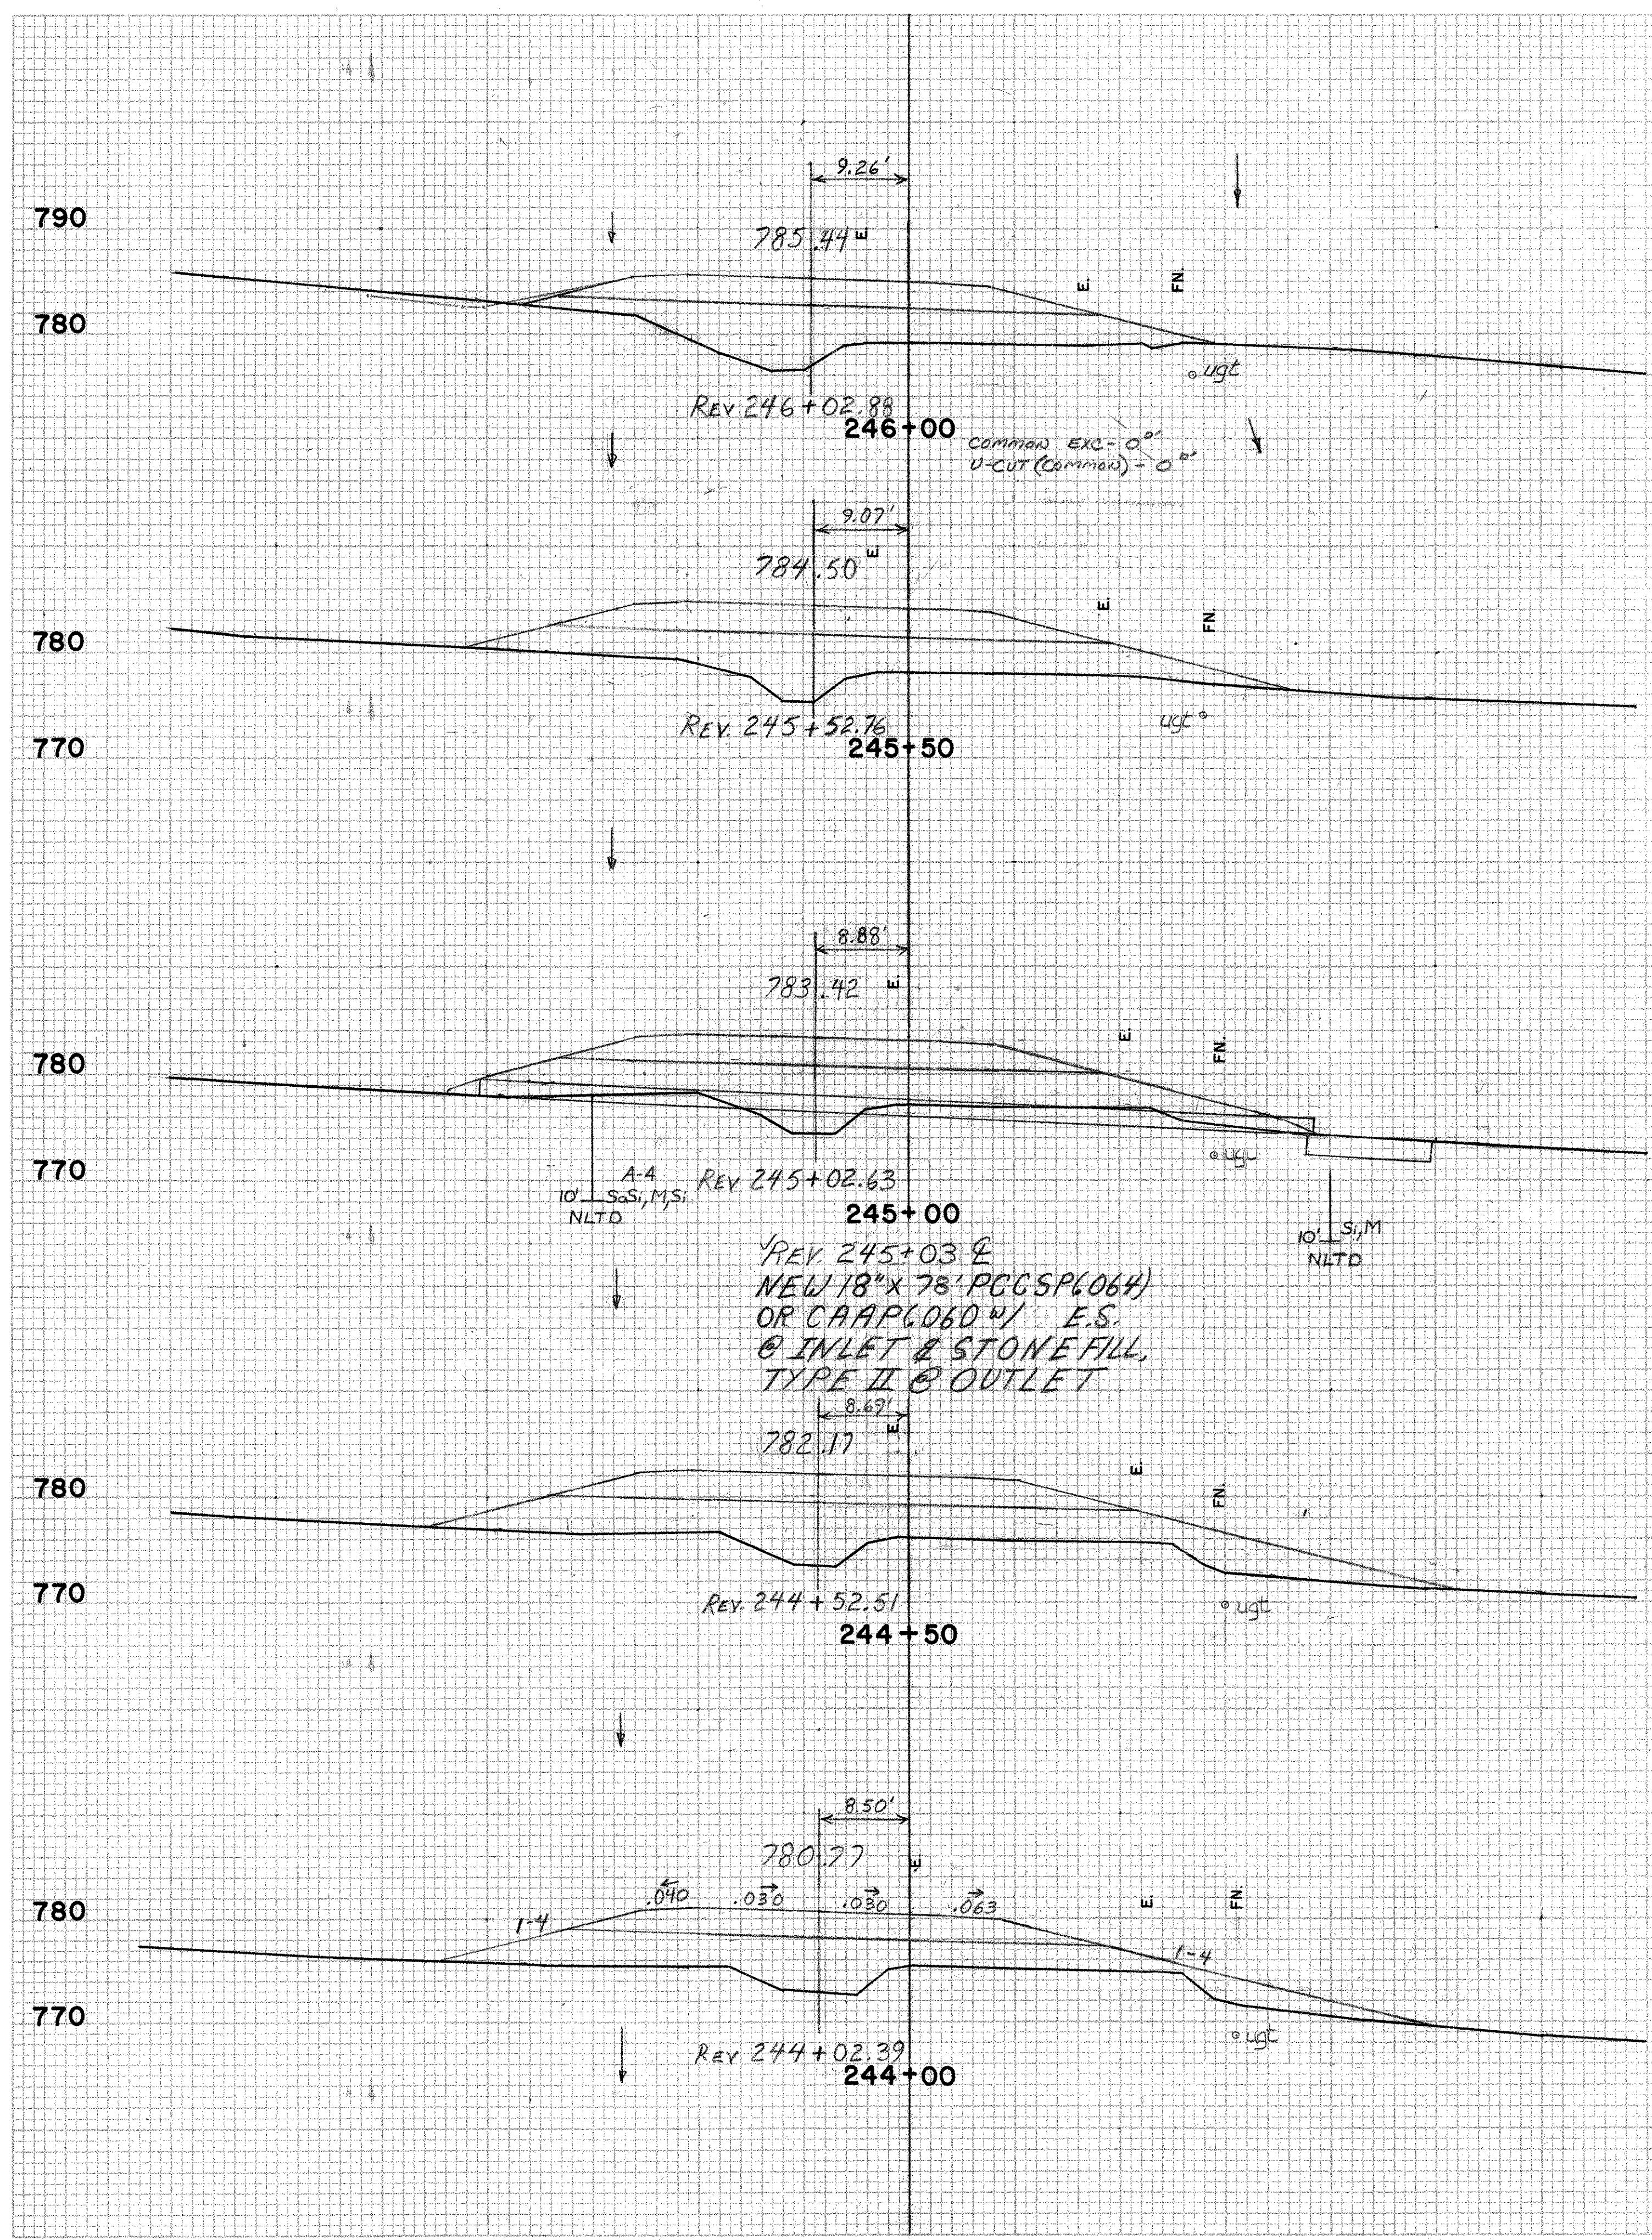

FROM STA. 244+00 TO STA. 248+50
 PROJECT NAME TROY, VT. ROUTE 101
 NO. RS 0311(1) PLOTTED MARCH 1985
 SURVEYED BY ASC FEB-MARCH 1985
 SHEET 43 OF 229 SHEETS

Plan - 3-31-85

PLATE 3 CROSS SECTION: O.P.R. & R.M. STANDARD

SCALE 10 FEET