


FINAL SURVEY SHOWN. SURVEY PLOTTED. NOTE BOOK TEMPLATE. AREAS CHECKED.

ORIGINAL SURVEY SHOWN. SURVEY PLOTTED. NOTE BOOK TEMPLATE. AREAS CHECKED.

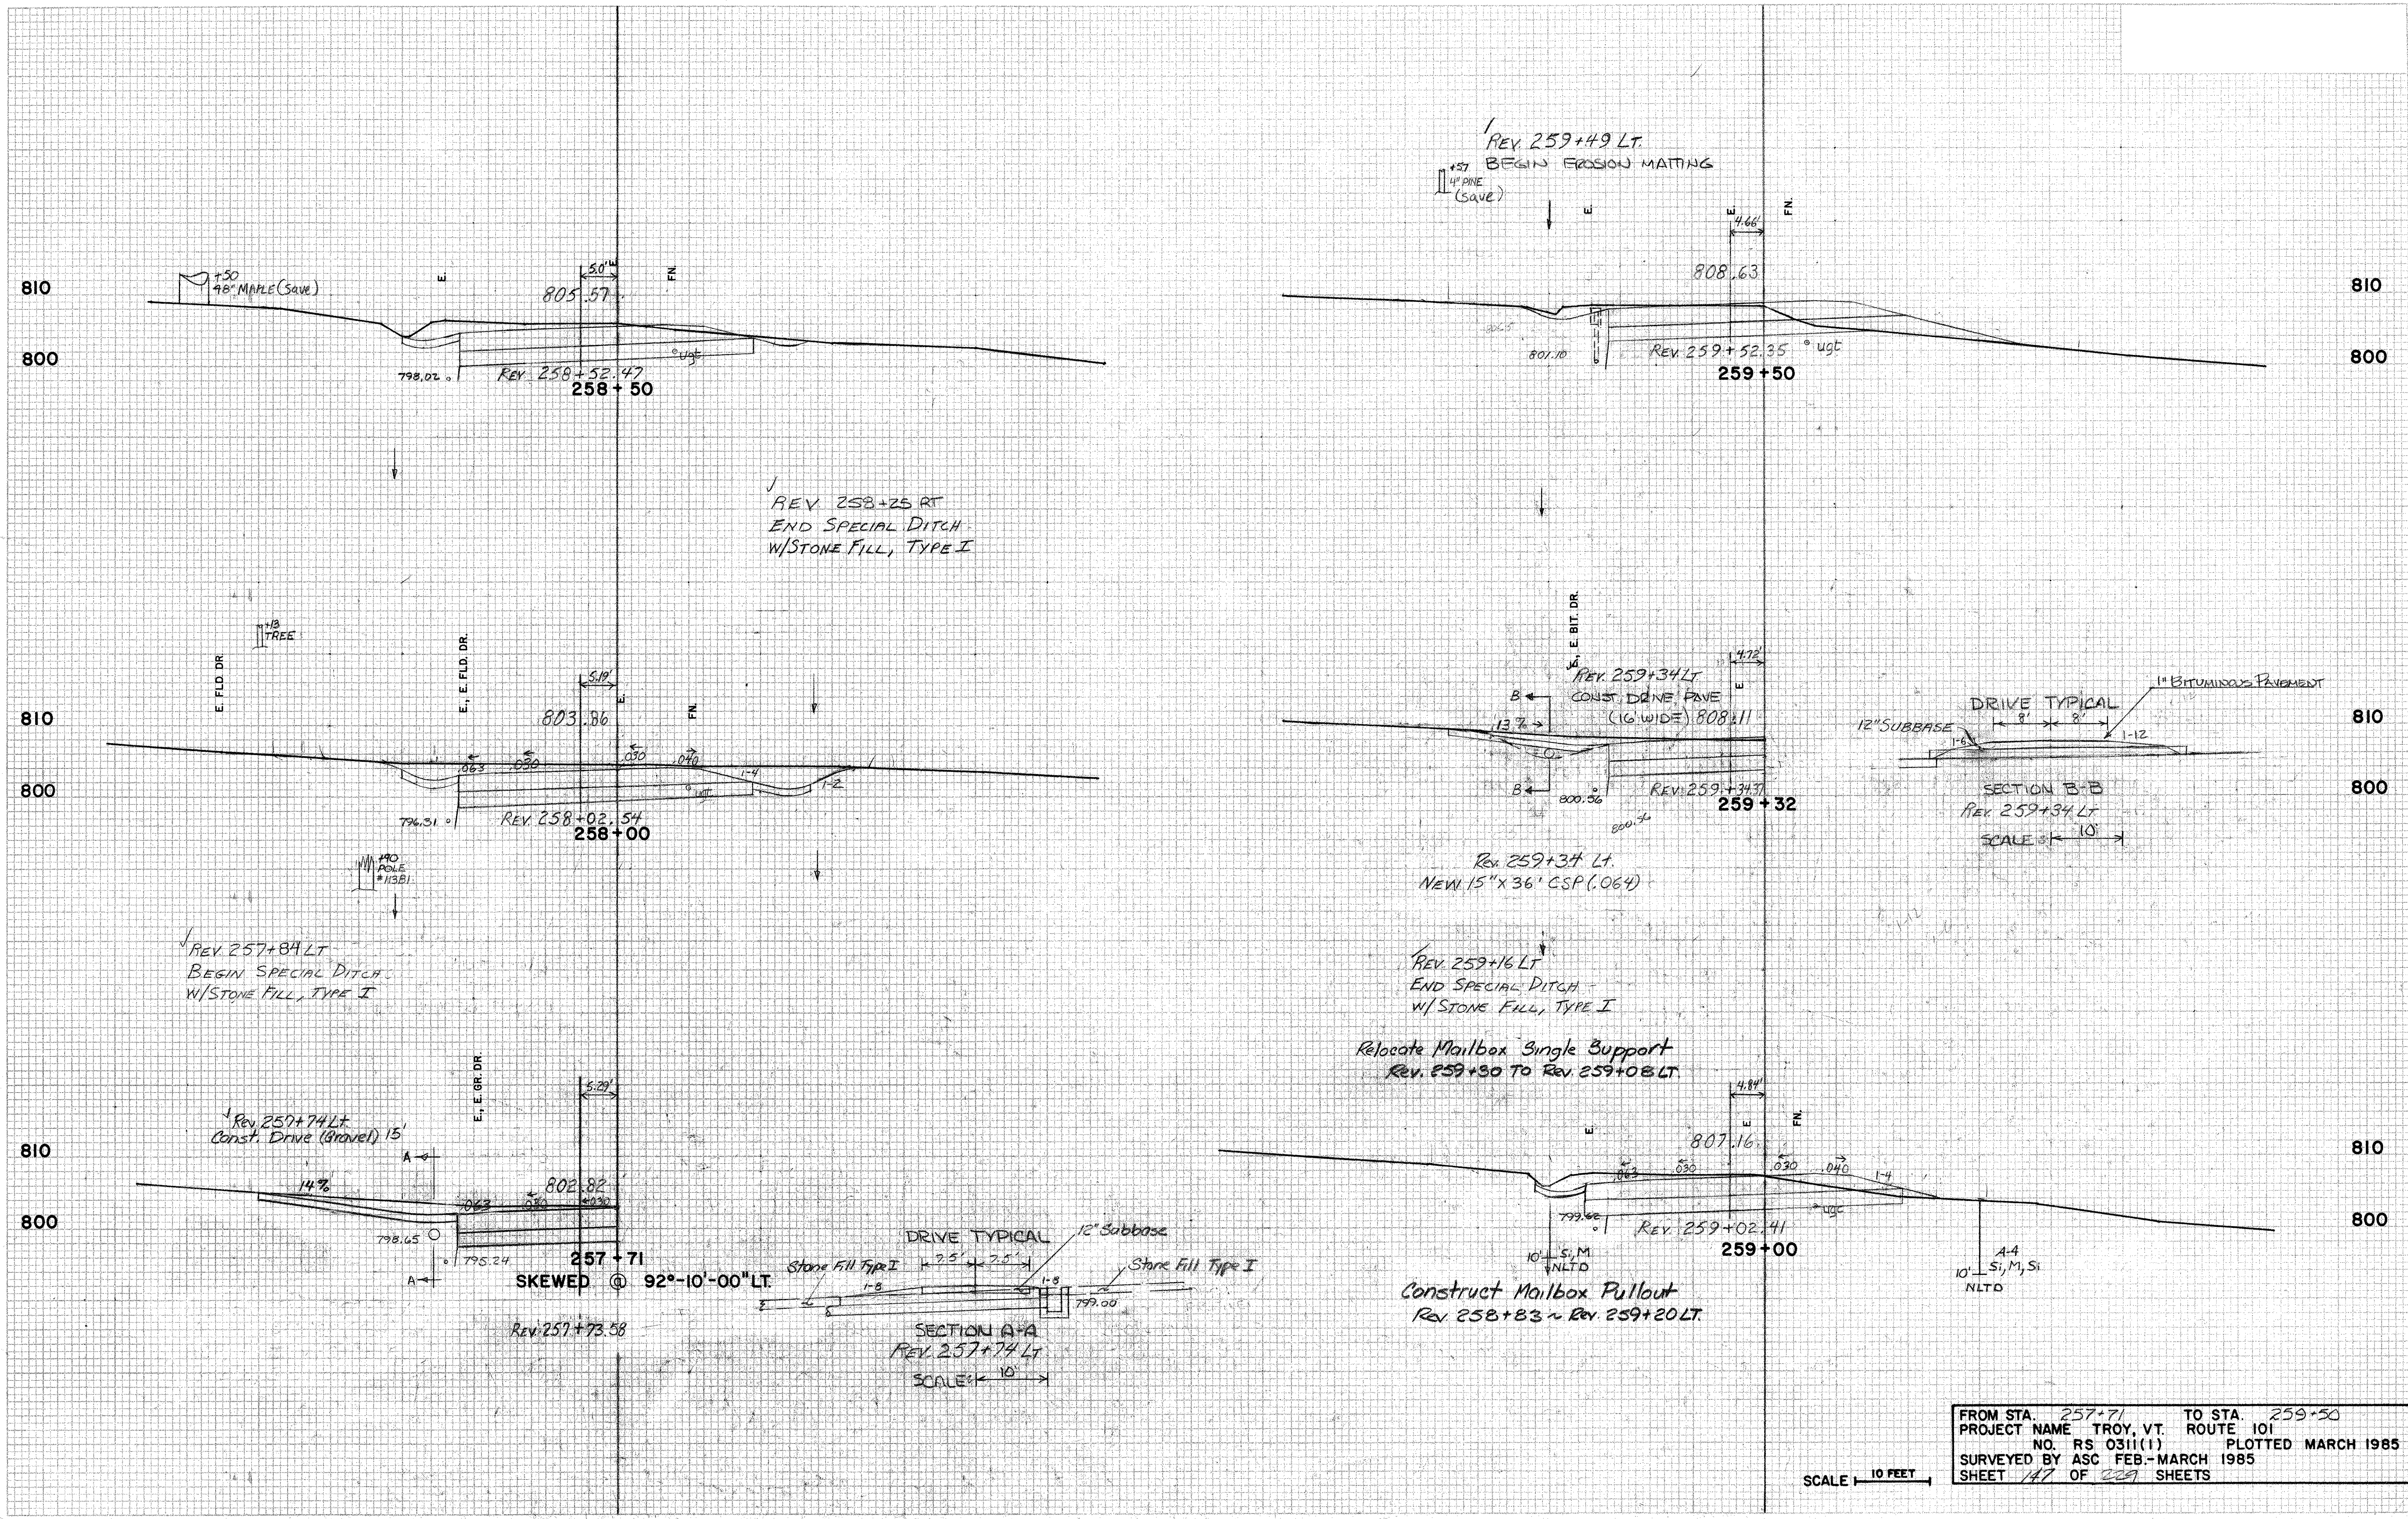

FROM STA. 257+71 TO STA. 259+50
 PROJECT NAME TROY, VT. ROUTE 101
 NO. RS 0311(1) PLOTTED MARCH 1985
 SURVEYED BY ASC FEB.-MARCH 1985
 SHEET 147 OF 229 SHEETS

SCALE 10 FEET