
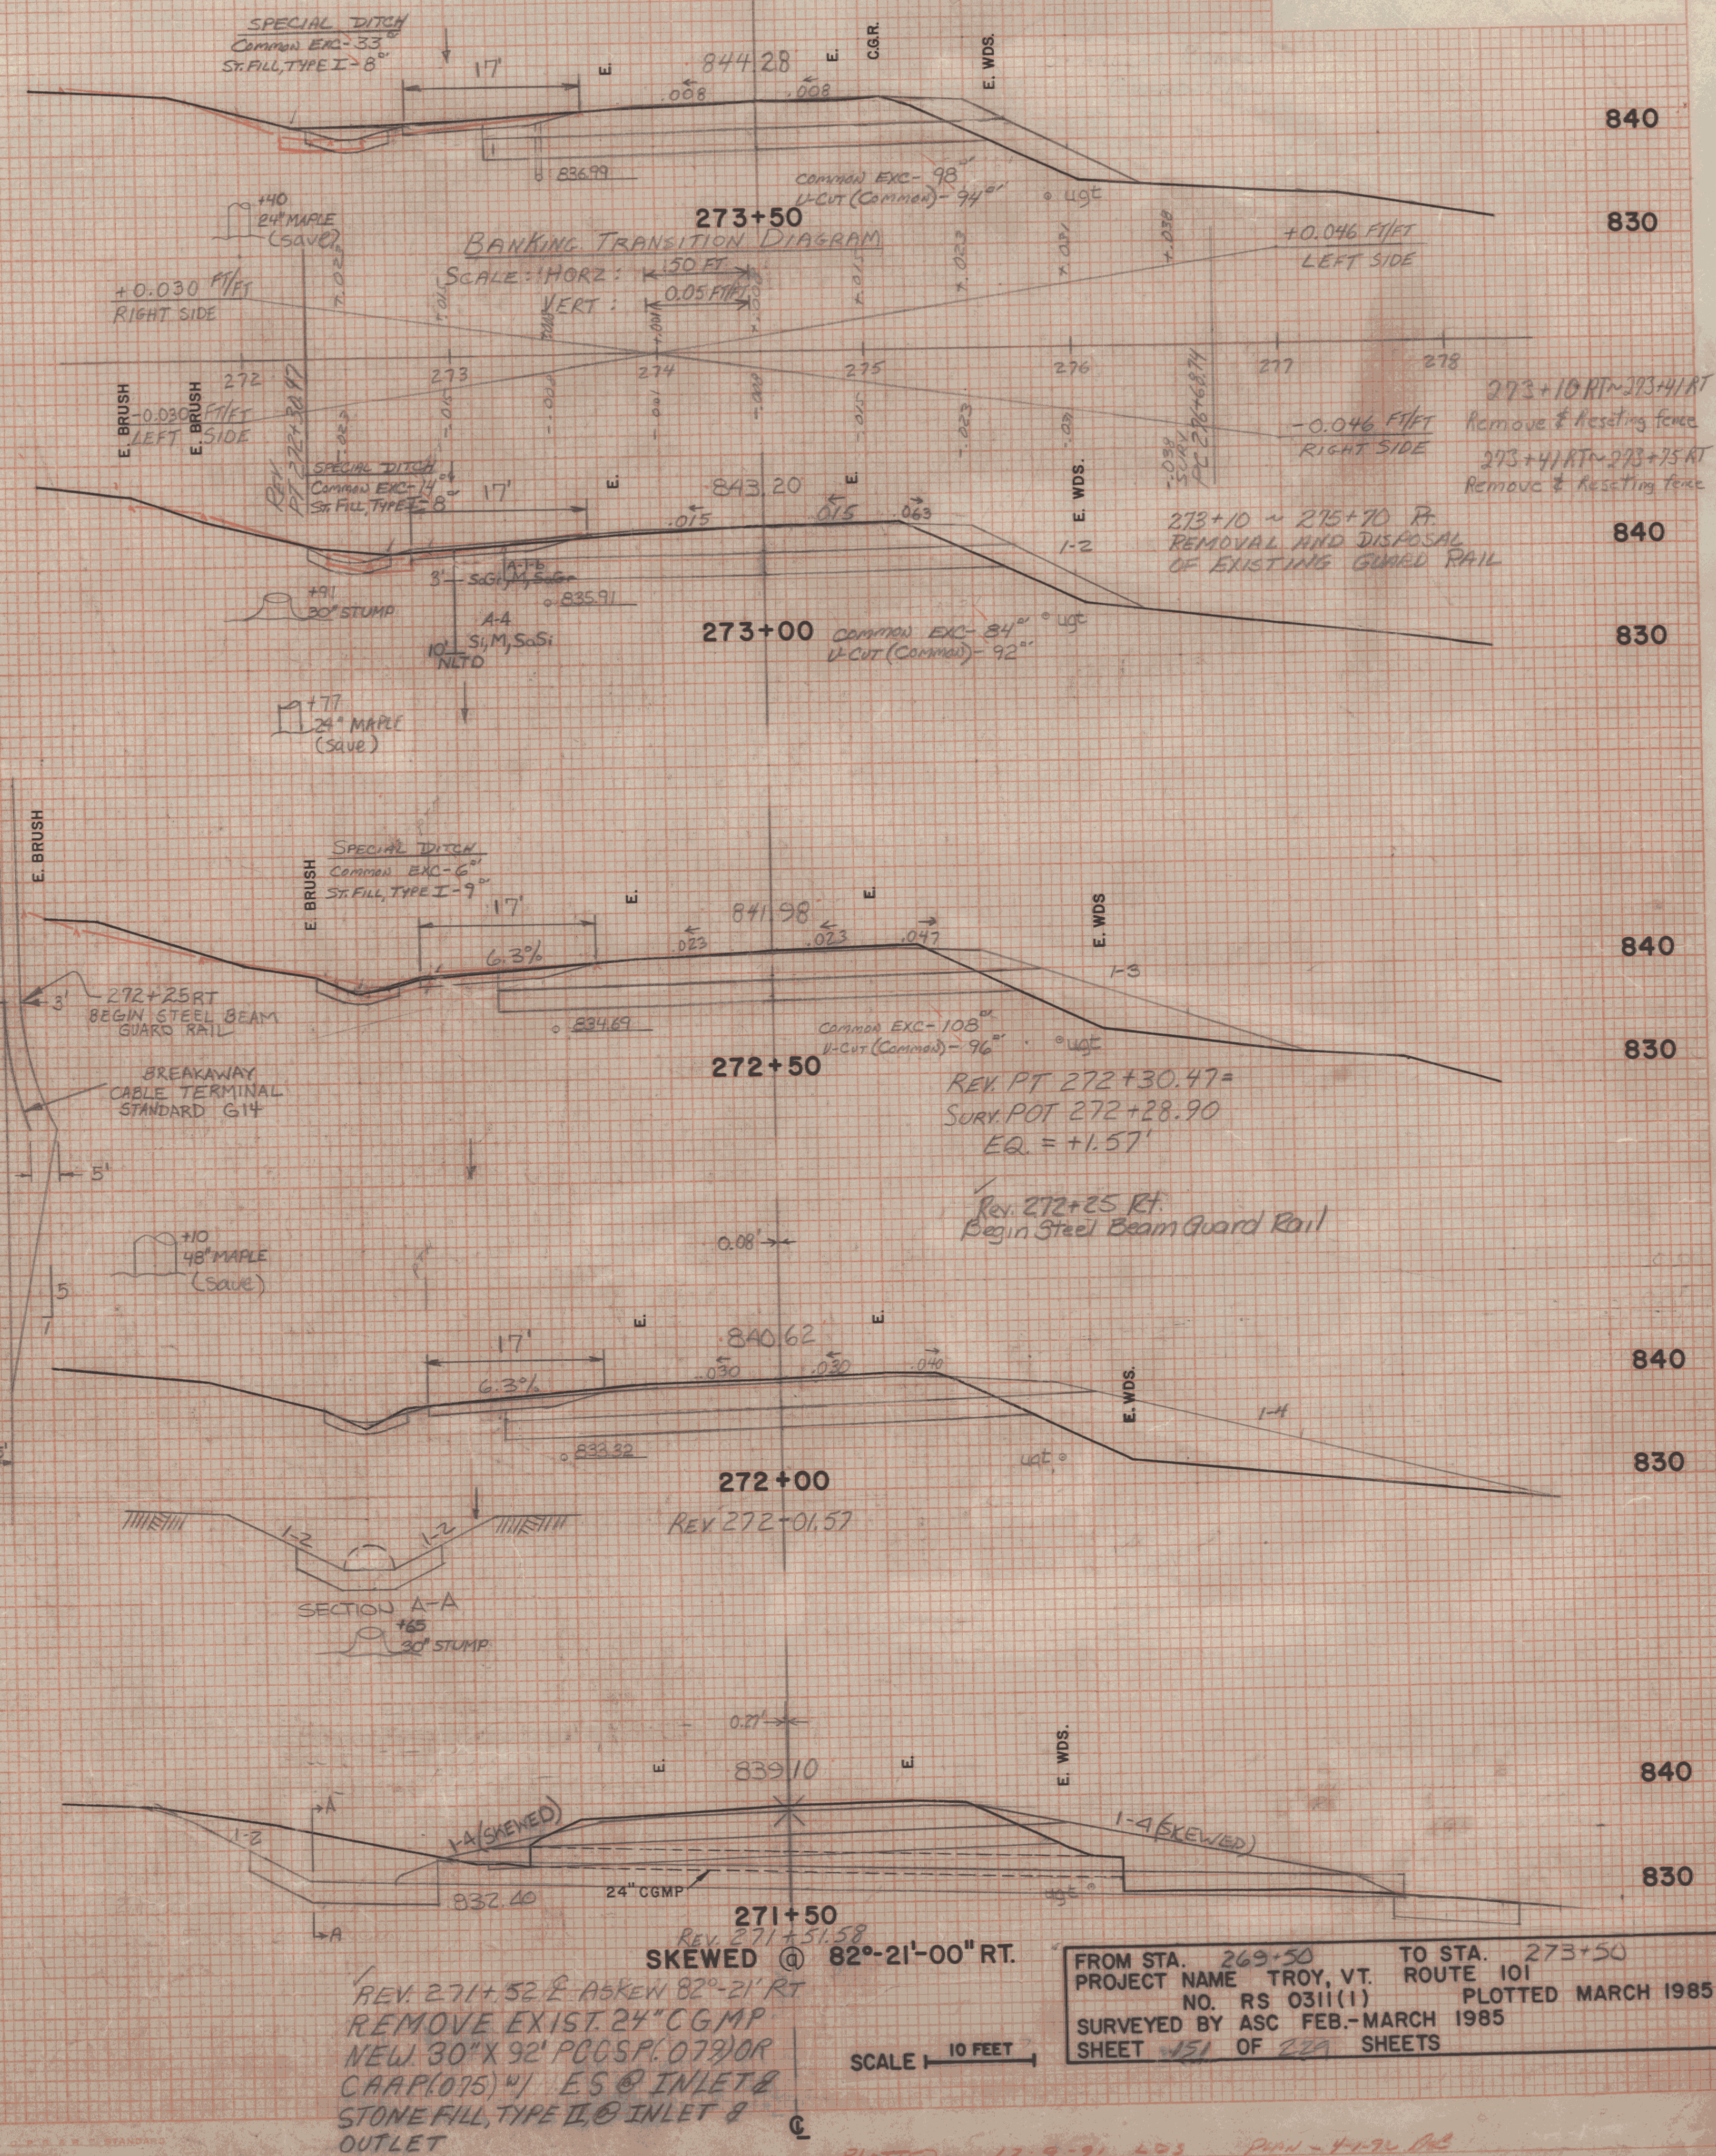


ORIGINAL		BY	DATE
SURVEYED			
PLOTTED			
TEMPLATE			
AREAS			
AREAS CHECKED			

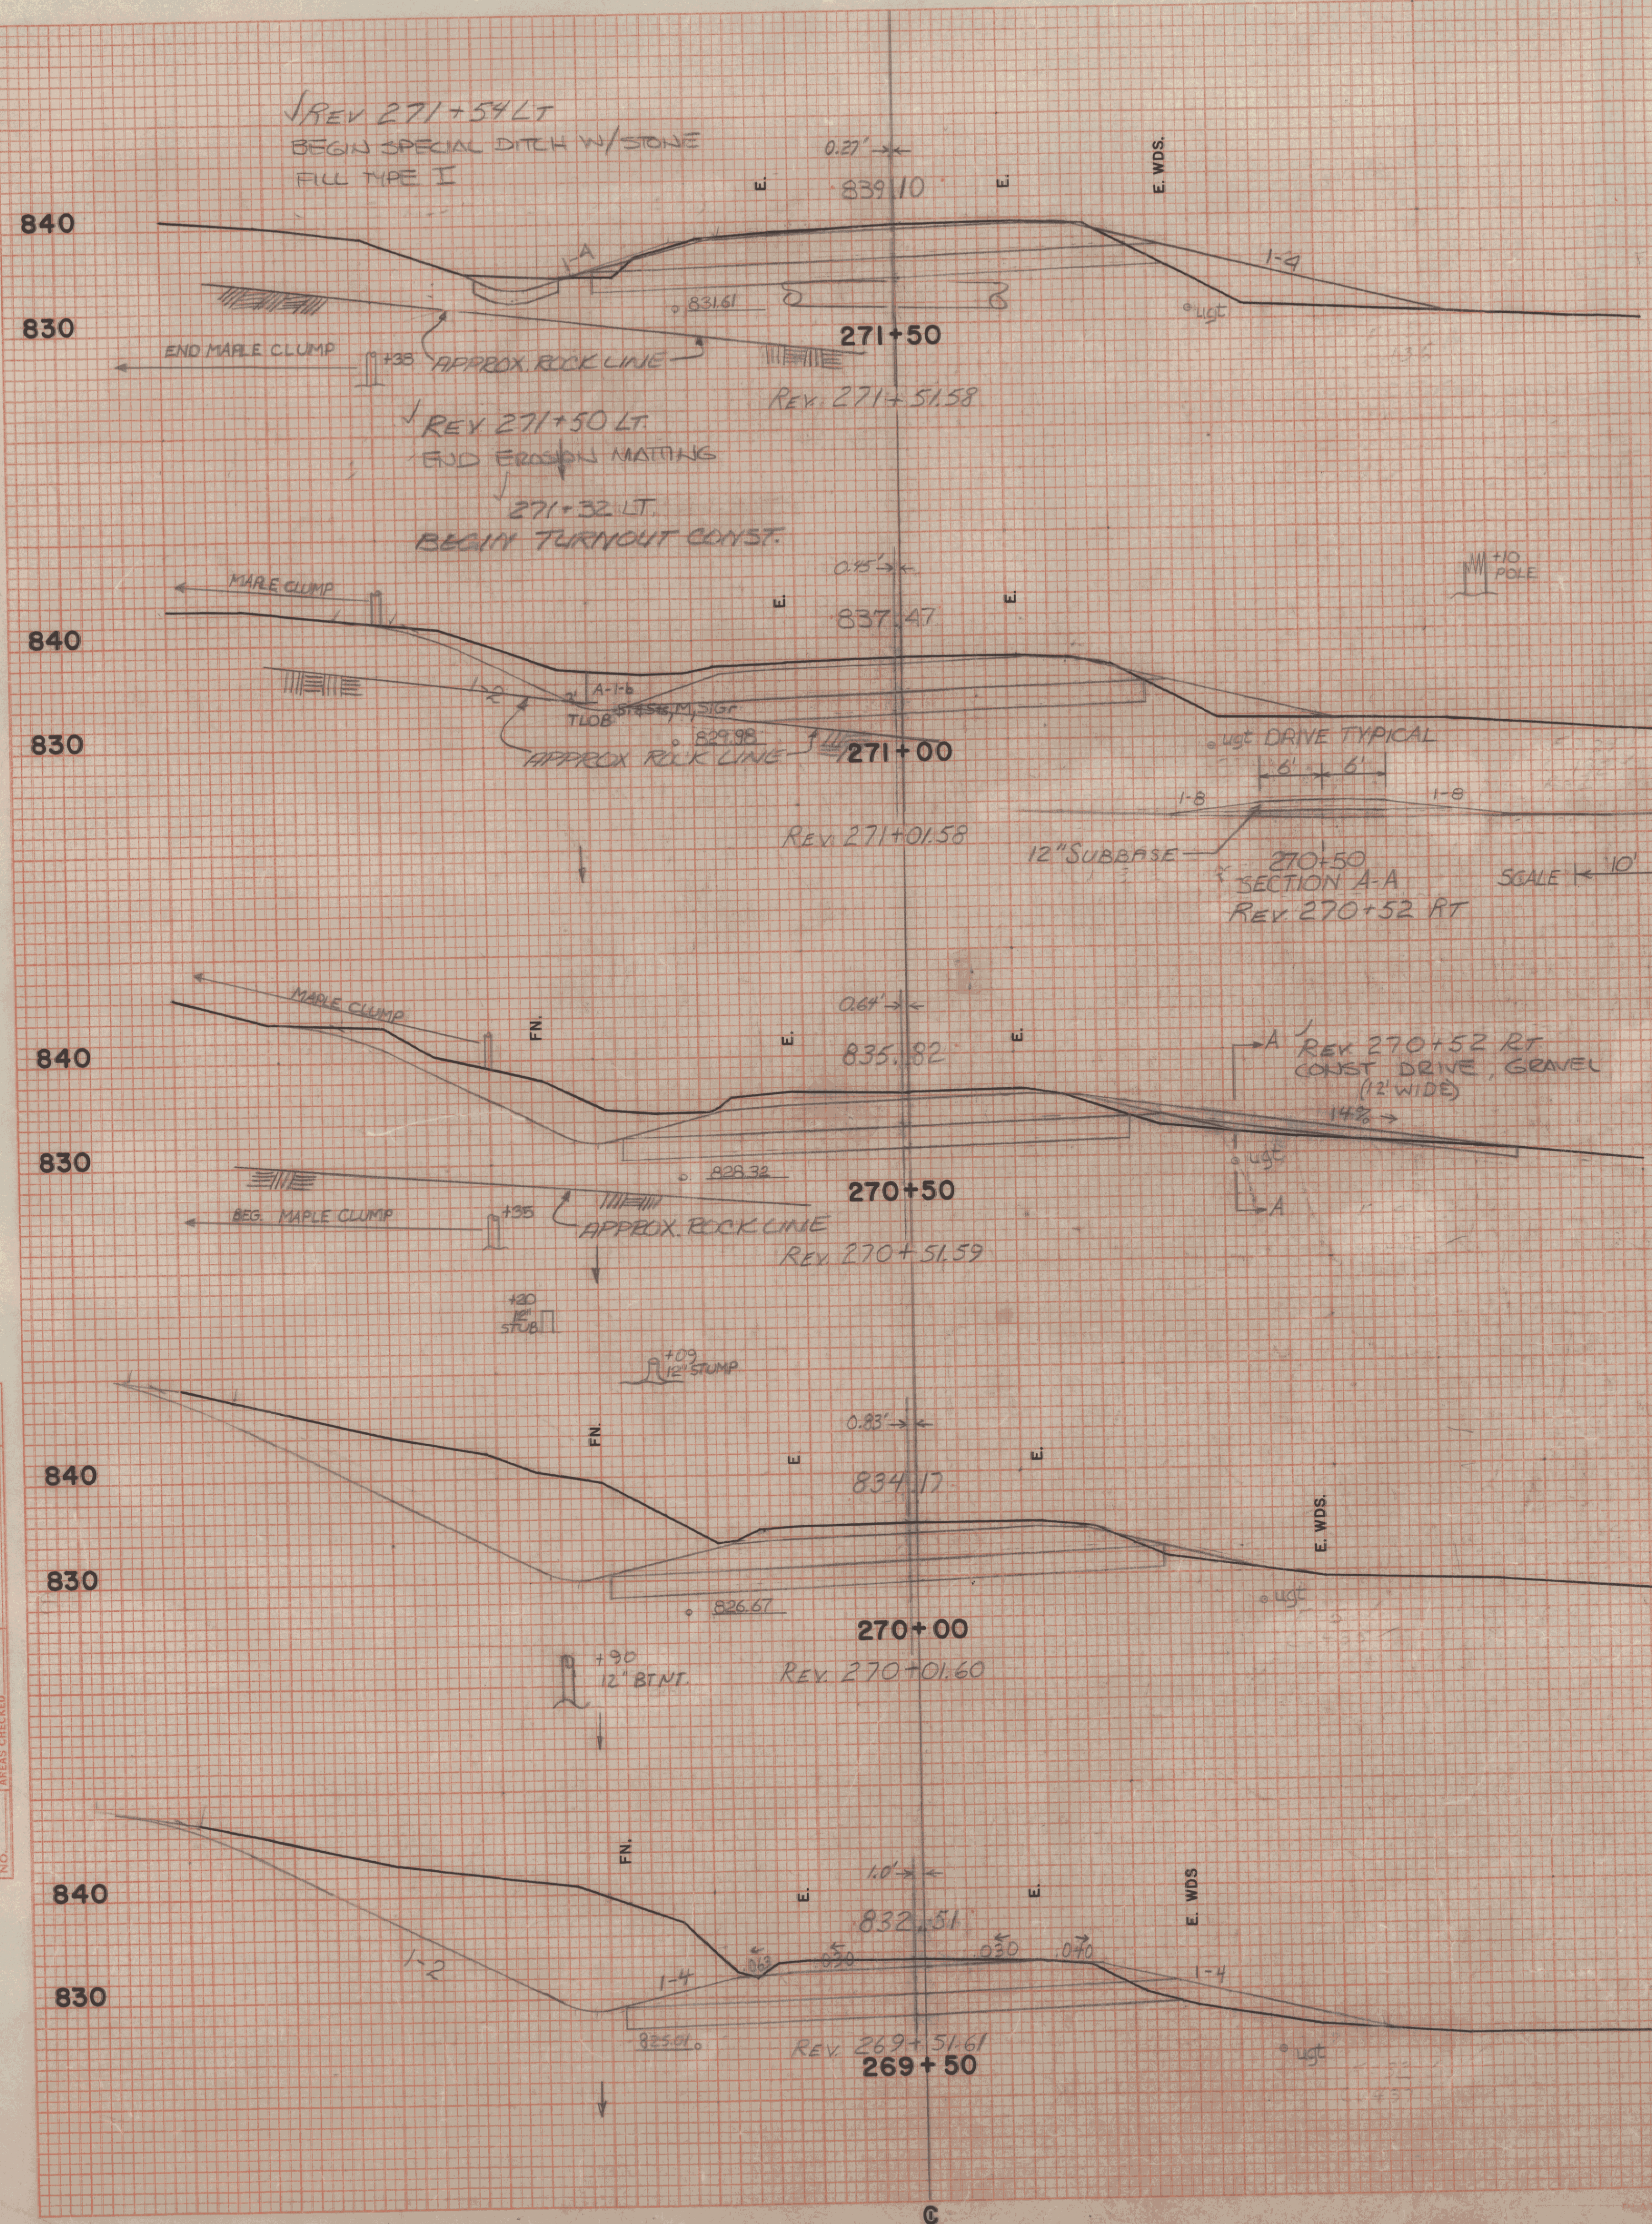

PLOTTED 12-9-91 LGS PHAN-4-1-92 OK
 PERIMETERED 1-30-92 KEM